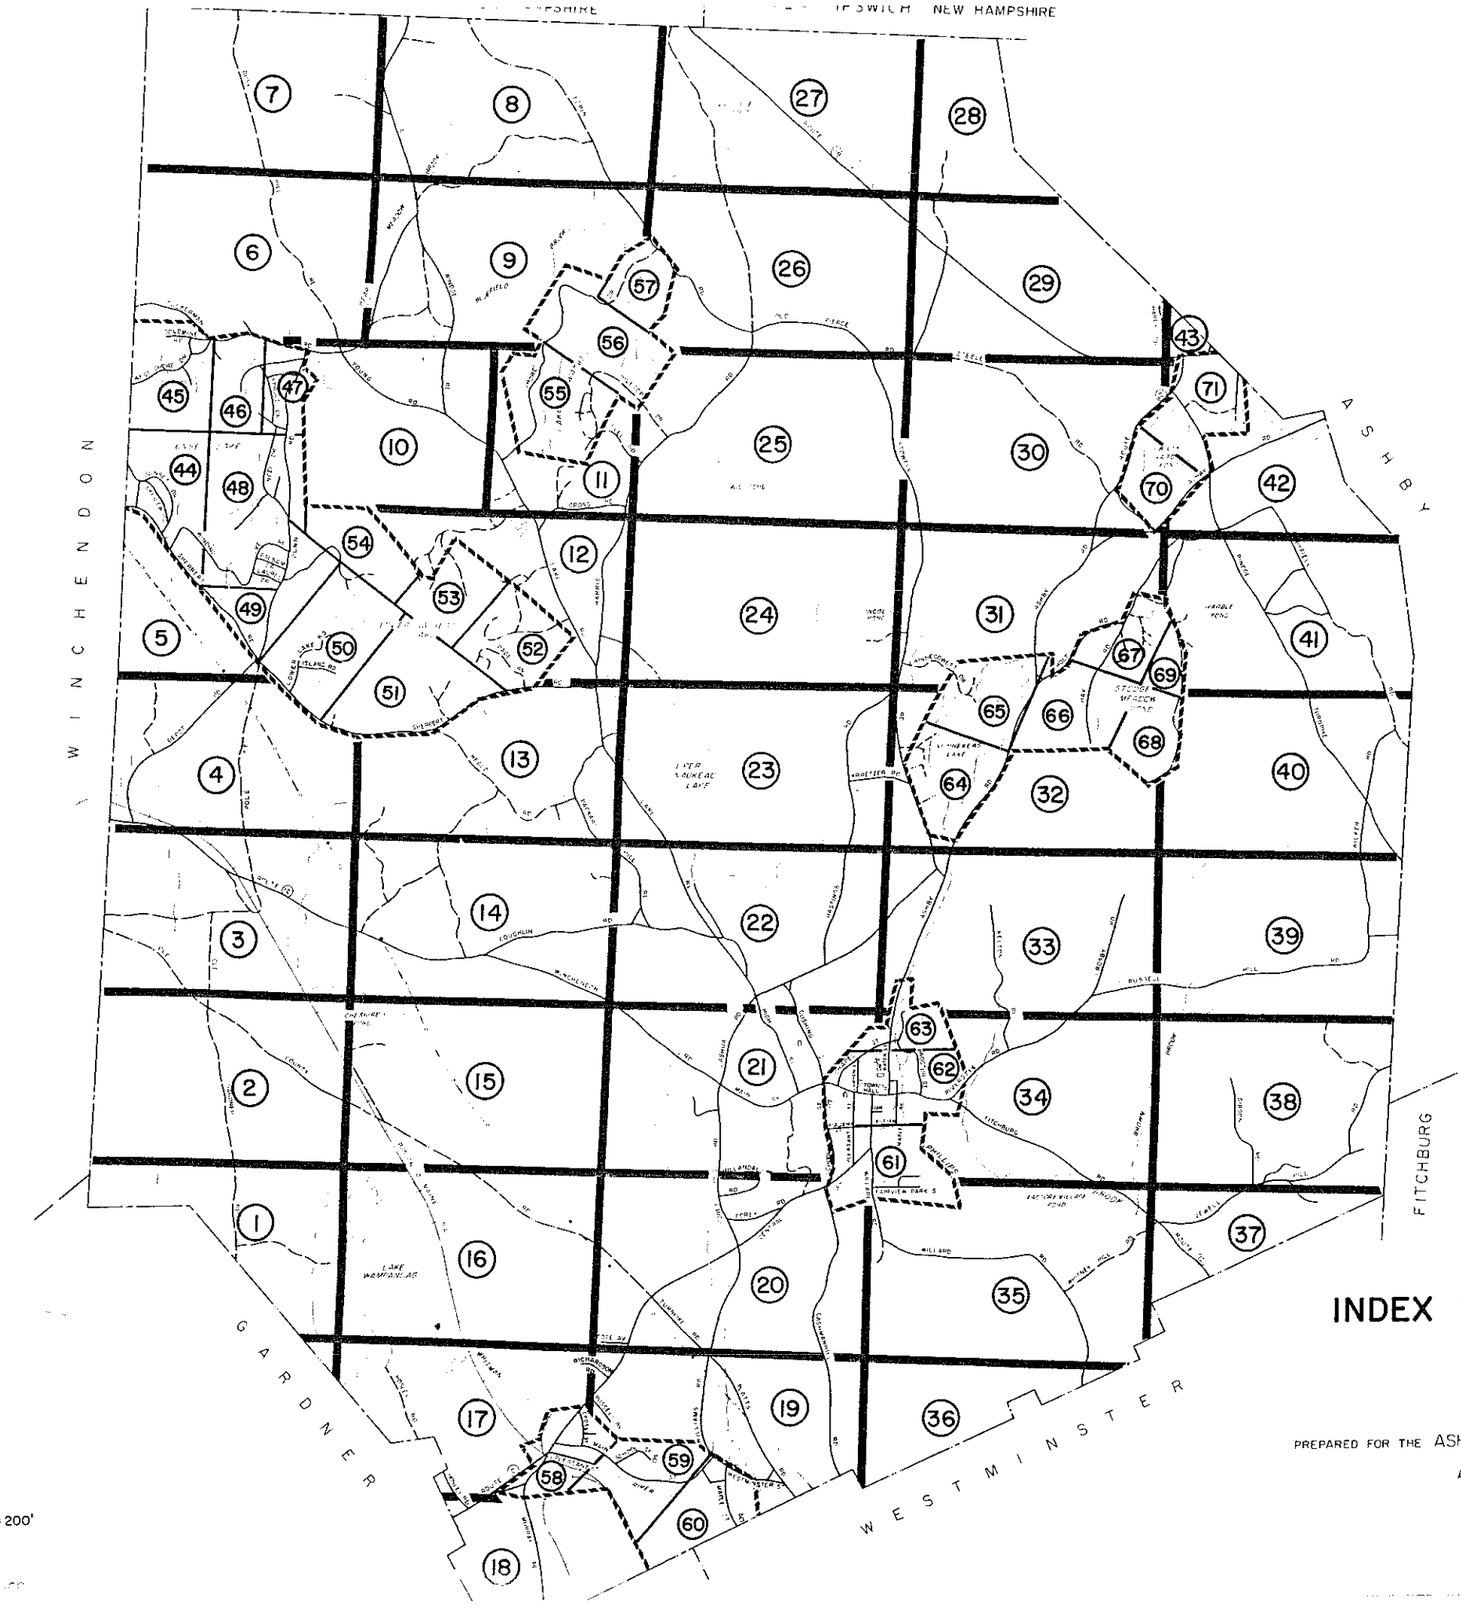


SCALE 1"=200'

SCALE 1"=400'

FY 08

# INDEX TO TAX MAPS

Revised To
January 1, 1988 ~~1/1/85~~
1/1/06

PREPARED FOR THE ASHBURNHAM BOARD OF ASSESSORS
BY
AVIS AIRMAP INC
SEPTEMBER 1971

# ASHBURNHAM, MASSACHUSETTS

ASSESSORS MAPS

SEE MAP 2

M2 L2

M2 L7

M2 L8

M2 L1

4
50 AC

3
25 AC

5
75 AC

GARDNER RD

990-S

990

FOR CONDITION

2D
60600

2C
60000

2B
60000

2A
62500

1
29400

DIRT

2
6.67AC

6A
5.8 AC

6B
5.5 AC-S

R.O.W.

6C
10 AC

6D
7.8 AC

6E
2.5AC

SEE INSET 2

BEACH

31
6000-S

1100-S

SEE MAP 16

30
2300-S

29
48 AC-S

2300-S

7
40 AC-S

LAKE WAMPANOAG

MATCH LINE

SEE INSET 1

SCALE 1"=200'

GARDNER

LAKE WAMPANOAG

MATCH LINE

32
4500-S

INSET 1

18
5.7AC

25
1.2 AC

PART OF LOT 5

COMM. OF MASS

22
19203

23
16390

20
9600

21
7036

24
5905

R.O.W.

17
27874

16
9500

15
14600

14
9000

13
12885

12
7689

11
7500

11B
14520

10
5000

33
18300-S

6
2.2AC-S

6E
2.5AC

BEACH AREA

8
4826

9
14478

28
5100-S

27
5000

26
7603

LAKE WAMPANOAG

SCALE 1"=100

INSET 2

200 0 200 400 600 FEET

PREPARED UNDER THE DIRECTION OF THE
ASHBURNHAM BOARD OF ASSESSORS
BY
AVIS AIRMAP, INC
*BROOKLINE – BRAINTREE – HARTFORD*

| | | |
|---|---|---|
| REV. BY | AVIS | 197 |
| REV. BY | AVIS | 197 |
| REV. BY | AVIS | 197 |
| REV. BY | AVIS | 198 |
| ORIGINAL ISSUE: | | 197 |

LAST Nº USED: 33
Nº NOT USED: 7

**MAP 1**

Revised To
January 1, ~~1998~~ 1996

JAN

1/1/96

| | | |
|---|---|---|
| | 2 | 15 |
| | 1 | 16 |
| | | 17 |

# ASHBURNHAM, MASSACHUSETTS

ASSESSORS MAPS

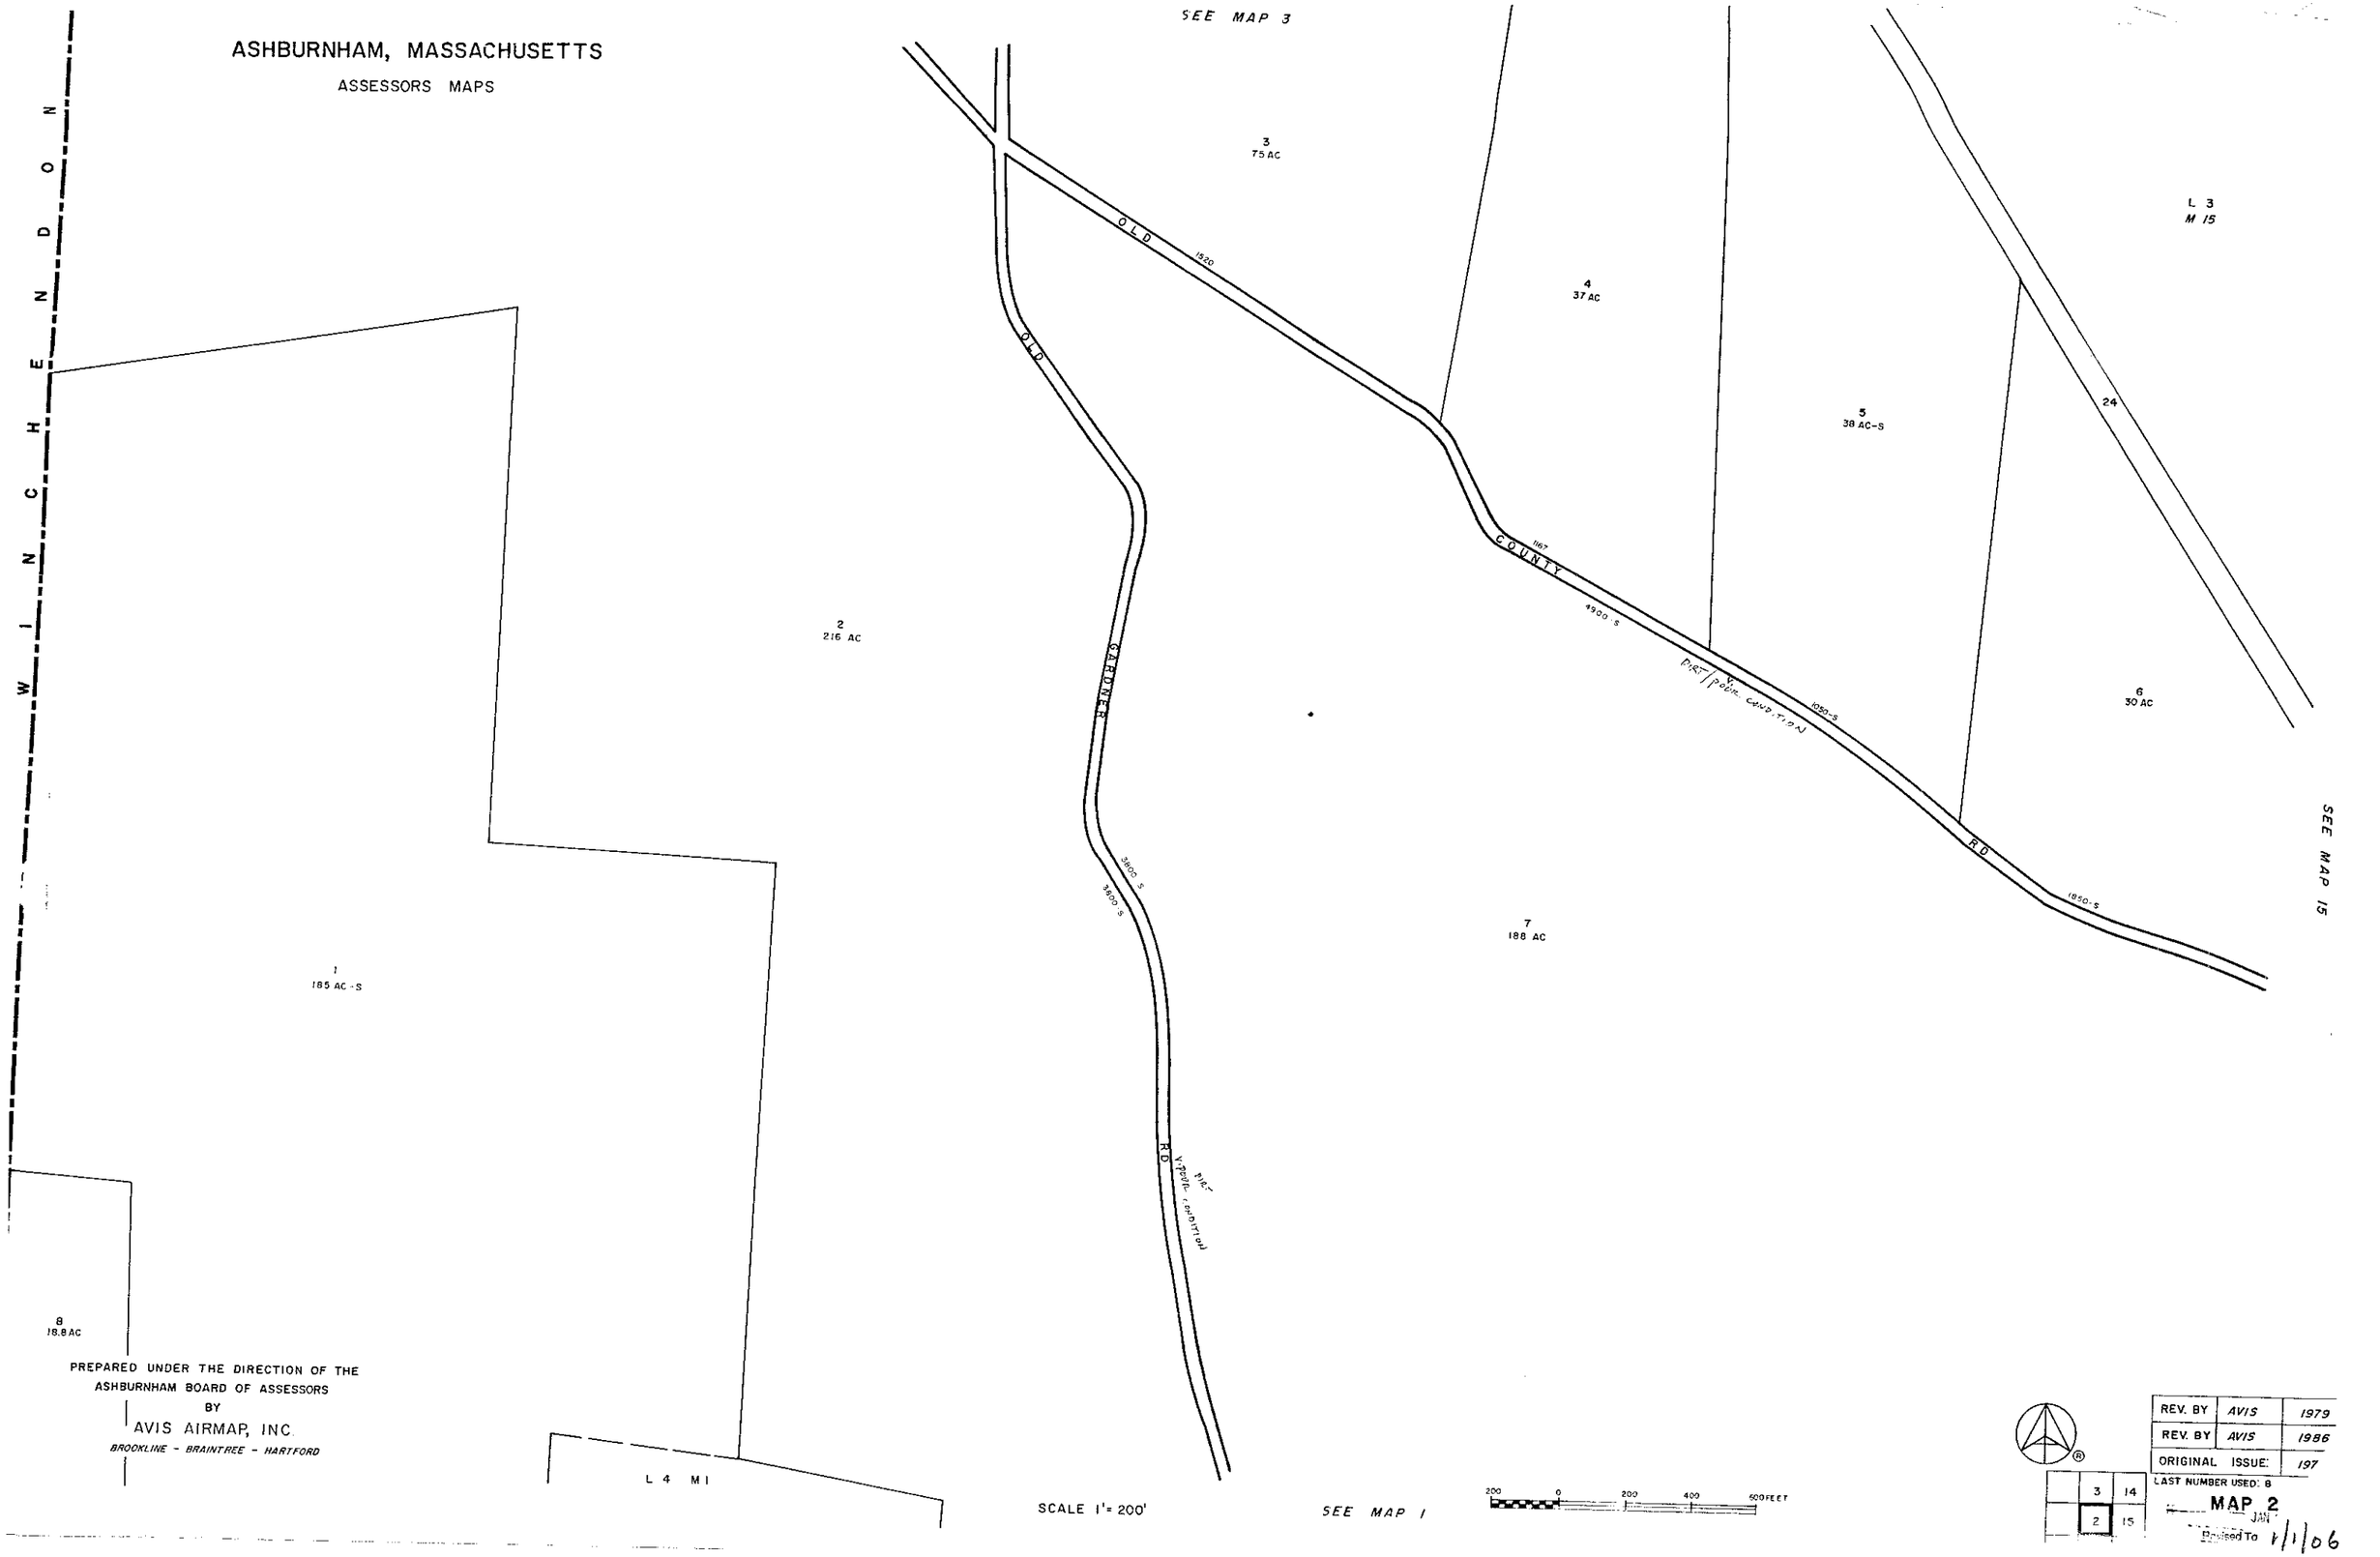


SCALE 1"= 200'

PREPARED UNDER THE DIRECTION OF THE
ASHBURNHAM BOARD OF ASSESSORS
BY
AVIS AIRMAP, INC.
*BROOKLINE - BRAINTREE - HARTFORD*

| | |
|---|---|
| REV. BY | AVIS 1979 |
| REV. BY | AVIS 1986 |
| ORIGINAL ISSUE: | 197 |

LAST NUMBER USED: 8

| | |
|---|---|
| 3 | 14 |
| 2 | 15 |

MAP 2

JAN

Revised To 1/1/06

# ASHBURNHAM, MASSACHUSETTS

ASSESSORS MAPS

SEE MAP 4

M4 L4

M4 L1

M4 L2

M4 L3

M4 L30

M4 L1A

844

HIGHWAY

335

20
2.37 Ac

200

19
63763

200

18
61146

200

17
45173

200

(WINCHENDON)

2 R.S. 100-S

MASS C P W EASEMENT

180-S

160-S

7
70673

230-S

6
10850

450

300-S

330

200

23
1.2 AC

200

22
1.14 AC

200

21
1.14 AC

320

8
16 AC-S

9
55.4 AC
TOWN DUMP

POLE ST

11
97 AC

NEW ENGLAND POWER COMPANY EASEMENT

2
24.2 AC

4
2 AC-S

POLE

700-S

600-S

ST

Dirt
V. poor cond.

RD

1450

10
24.25 AC-S

1370

1170

ST

POLE

10A
12 AC-S

2200-S

15 A
8 AC

15 B
8.9 AC

15 C
10.3 AC

15
12.7 AC

RD

300

300

270

2548

GARDNER

OLD

1350-S

13
43.2 AC

14
13000

2A

1185-P

No 12

330

1186

SEE MAP 14

1
11.3 AC

OLD

COUNTY

3500-S

3500-S

RD

M2 L3

M2 L3

M2 L5

M2 L4

12
40 AC

Dirt
V. poor cond.

PREPARED UNDER THE DIRECTION OF THE
ASHBURNHAM BOARD OF ASSESSORS
BY
AVIS AIRMAP, INC.
*BROOKLINE - BRAINTREE - HARTFORD*

200 0 200 400 600 FEET

SCALE 1" = 200'

NO PARCEL 3 16

SEE MAP 2

| | | |
|---|---|---|
| | 4 | 13 |
| | 3 | 14 |
| | 2 | 15 |

| | | |
|---|---|---|
| REV BY | AVIS | 1979 |
| REV. BY | AVIS | 1986 |
| ORIGINAL ISSUE: | | 1972 |

LAST NUMBERS USED: 23

**MAP 3**

~~Revised for~~ January 1, ~~1986~~ 1992

1/1/06

# ASHBURNHAM, MASSACHUSETTS

ASSESSORS MAPS

| | | |
|---|---|---|
| REV. BY | AVIS | 1979 |
| REV. BY | AVIS | 1975 |
| REV. BY | AVIS | 1974 |
| REV. BY | AVIS | 1986 |
| ORIGINAL ISSUE: | | 1972 |

LAST NUMBER USED: 5-0

MAP 4

SCALE 1" = 100'

SCALE 1" = 200'

SCALE 1" = 200'

WINCHENDON

SEE MAP 50

SEE MAP 51

SEE MAP 13

M5 L2

M5 L11D

M3 L1

M3 L8

M3 L9

M3 L11

17 23.3 AC

16 12000 100

29 3.4 AC

45 2.5 AC

46 1.8 AC

28 12 AC

27A 4.7AC

27 8.13Ac

23C 1.2 AC

238 48719

23A 48566

14A 3.19Ac

44 3.59Ac.

43 4.4 AC

42 4.4 AC

41 3.7 AC

40 15.7 AC

15 9.5 AC-S

14 1.8AC

13 2.8AC

12 1.5AC

10 7 AC-S

9 1 AC-S

48 2.2AC

31 2 AC-S

31A 2 AC-S

32 15 AC-S

8 3.5 AC

7 1 AC-S

5 1.5AC

6 30932

33 21780

4 5.2AC

1B 2.41Ac

1 1.35Ac

1A 76.97AC

2 15000

3

26 15AC

23 42.1AC

39 28620

38 32950

19 25000

36 25100

35 25480

34 2.0Ac

18 1.3 AC

34A 12.67A

34B 11.47Ac

37 12.3AC

24 8AC-S

25 41 Ac.

30 148 AC-S

22 7.2AC.

21 3.5 AC-S

21 10 AC

50 190Ac

20 8AC

Lot A

Lot B

POLE NOT A RD

SHERBERT ST

DEPOT RD

HIGHWAY (WINCHENDON RD)

R O W

Rte 12

PREPARED UNDER THE DIRECTION OF THE
ASHBURNHAM BOARD OF ASSESSORS
BY
AVIS AIRMAP, INC.
*BROOKLINE – BRAINTREE – HARTFORD*

Revised To January 1, 1986 1/1/06

200 0 200 400 600 FEET

| | | |
|---|---|---|
| | 5 | 51 |
| | 4 | 13 |

# ASHBURNHAM, MASSACHUSETTS

ASSESSORS MAPS

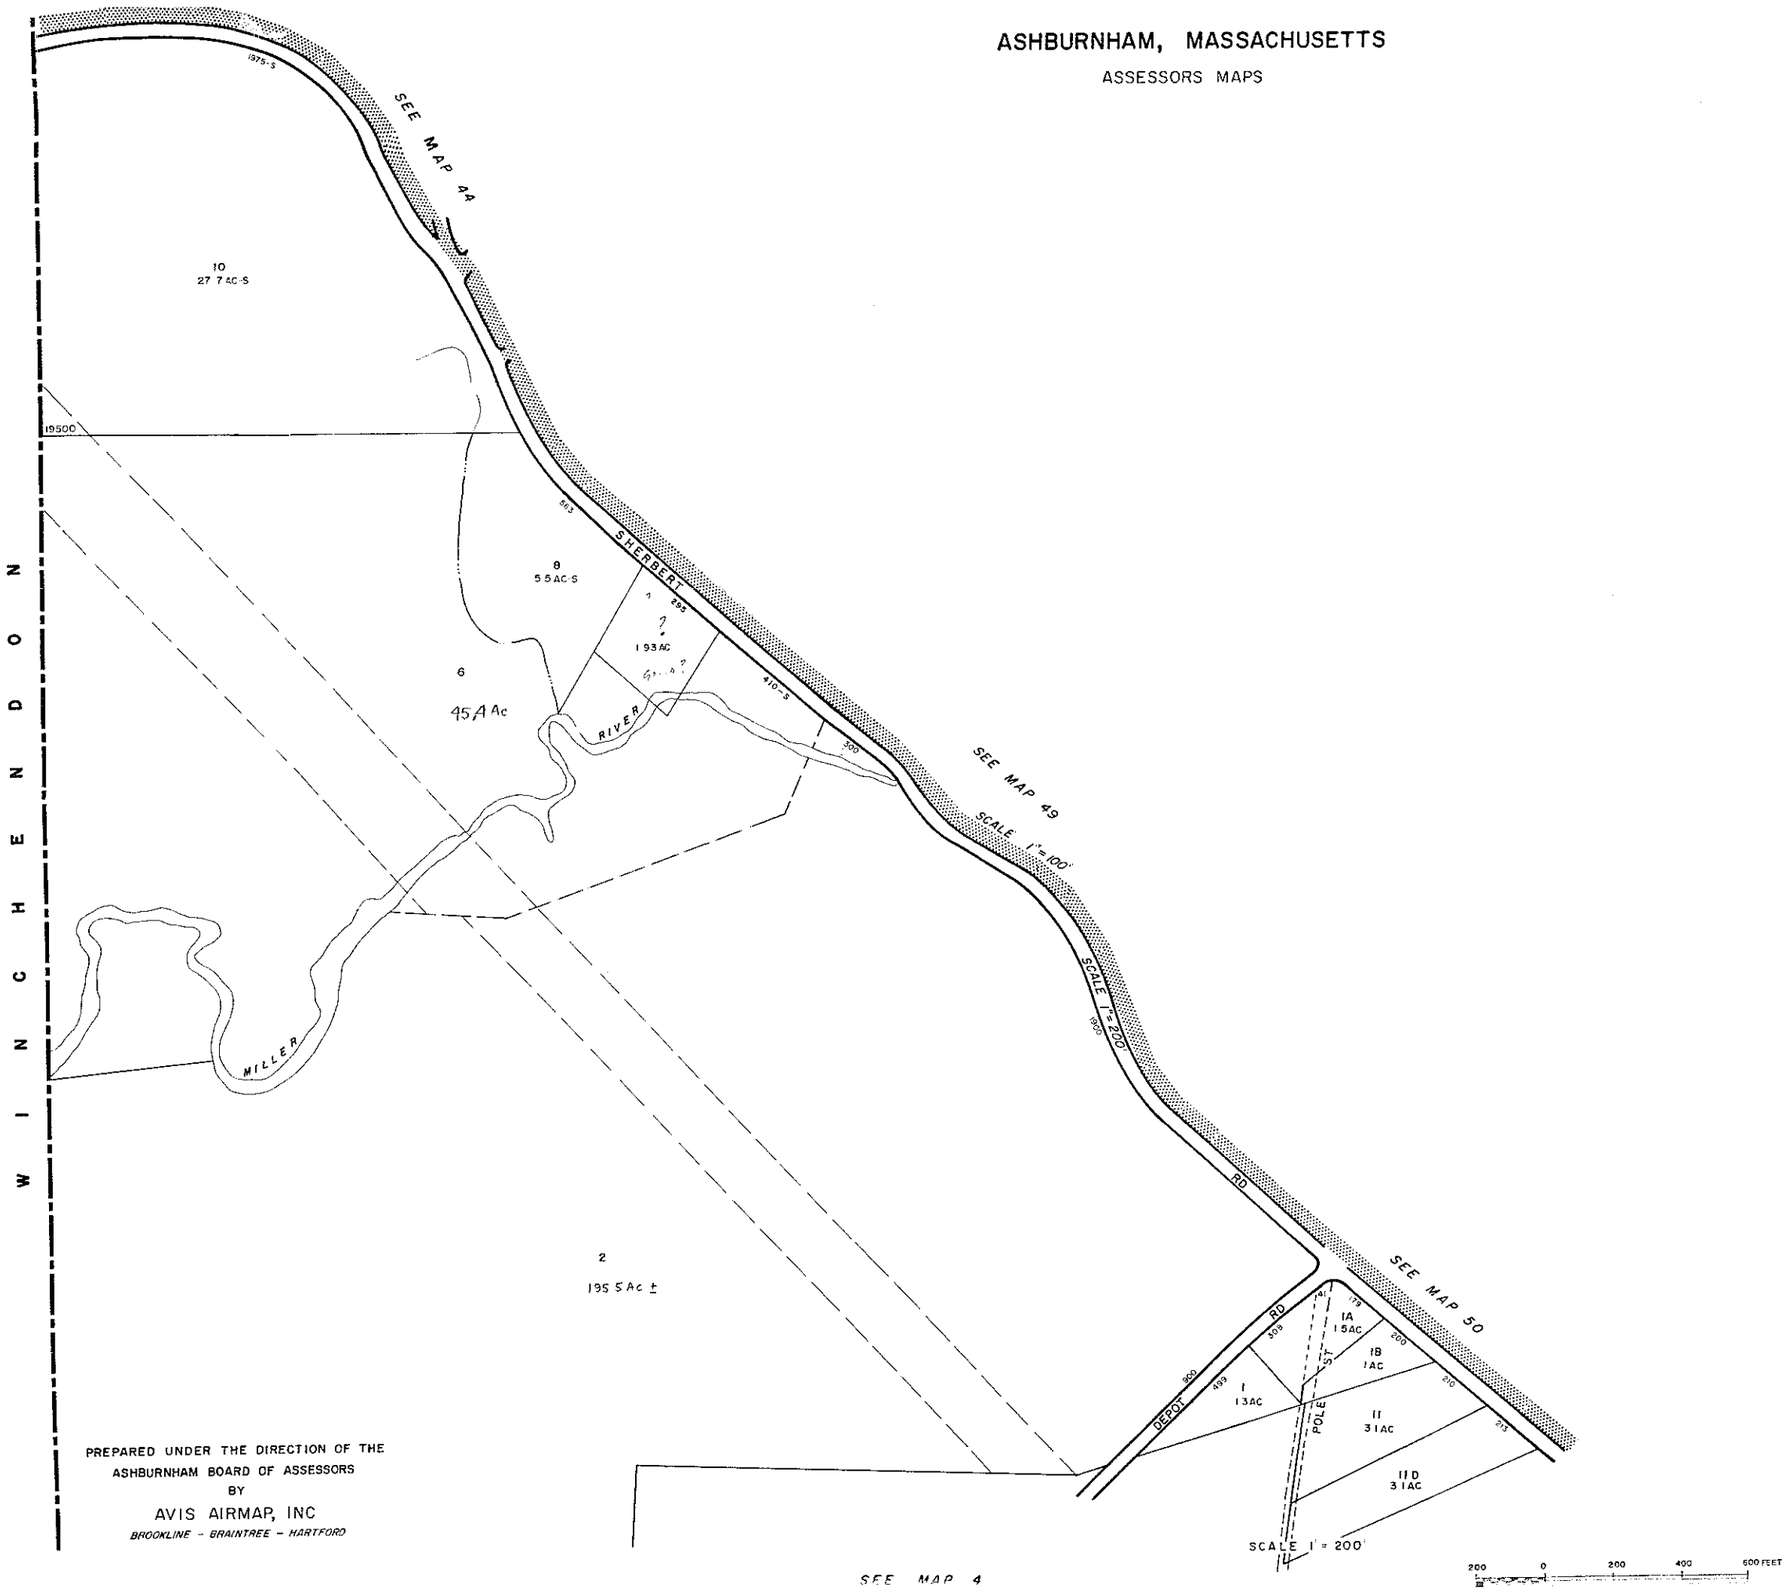


PREPARED UNDER THE DIRECTION OF THE
ASHBURNHAM BOARD OF ASSESSORS
BY
AVIS AIRMAP, INC
*BROOKLINE - BRAINTREE - HARTFORD*

| | | |
|---|---|---|
| | 44 | 48 |
| | 5 | 49 |
| | 4 | 50 |

| | | |
|---|---|---|
| REV. BY | AVIS | 197 |
| REV. BY | AVIS | 197 |
| REV. BY | AVIS | 19 |
| ORIGINAL ISSUE: | | 197 |

LAST NUMBER USED:16

**MAP 5**

Revised To: Jan X
January 1, 19XX

1/1/06

# ASHBURNHAM, MASSACHUSETTS

## ASSESSORS MAPS

WINCHENDON

SEE MAP 7

SEE MAP 9

SEE MAP 45

SEE MAP 46

SEE MAP 47

M7 L6

M9 L5F

M9 L5G

M9 L3N

M7 L21

10F 20 1AC

10 43 2 Ac.

10C 24 2 AC

10B 23 6AC

10A 20 6AC

9 91 AC

2 402.9 Ac ±

33 1 1AC

32 1 9AC

31 3 1 AC

30 2 6 AC

29 3.6AC

28 5.8 AC

27 7 1 AC

26 8 7 AC

34 8 AC-S

37 24 AC-S 16.6AC-P

36 2 3 AC

35 1 9 AC

14 500

11 11 4AC

12 9 AC

13 17 AC

8A 29 0AC

8 30 AC

7 19 4AC-S

6 3 3AC

5 4AC-S

3 30492

1 20 8 AC-S

15 1 4 AC

16 1 2 AC

17 1 2 AC

18 1 5 AC

19 1 4 AC

20 1 9 AC

21 2 2 AC

22 2 7 AC

23 2 7 AC

24 1 5 AC

25 1 6 AC

BUSH RD

TUCKERMAN RD

DUNN RD

bar rd pvt. common

2220'-S Dirt & poor condition

660'-S Fyt Dirt

SCALE 1"=200'

SCALE 1"=100'

SCALE 1"= 200'

200 0 200 400 600 FEET

PREPARED UNDER THE DIRECTION OF THE ASHBURNHAM BOARD OF ASSESSORS BY

AVIS AIRMAP, INC

BROOKLINE - BRAINTREE - HARTFORD

| | | |
|---|---|---|
| REV. BY | AVIS | 1979 |
| REV. BY | AVIS | 1975 |
| REV. BY | AVIS | 1974 |
| REV. BY | AVIS | 1986 |
| ORIGINAL ISSUE: | | 1972 |

LAST NUMBER USED: 34

L 11 M 10

# MAP 6

Revised To January 1, 1986

1/1/06

| | |
|---|---|
| 7 | 8 |
| 6 | 9 |

# ASHBURNHAM, MASSACHUSETTS

ASSESSORS MAPS

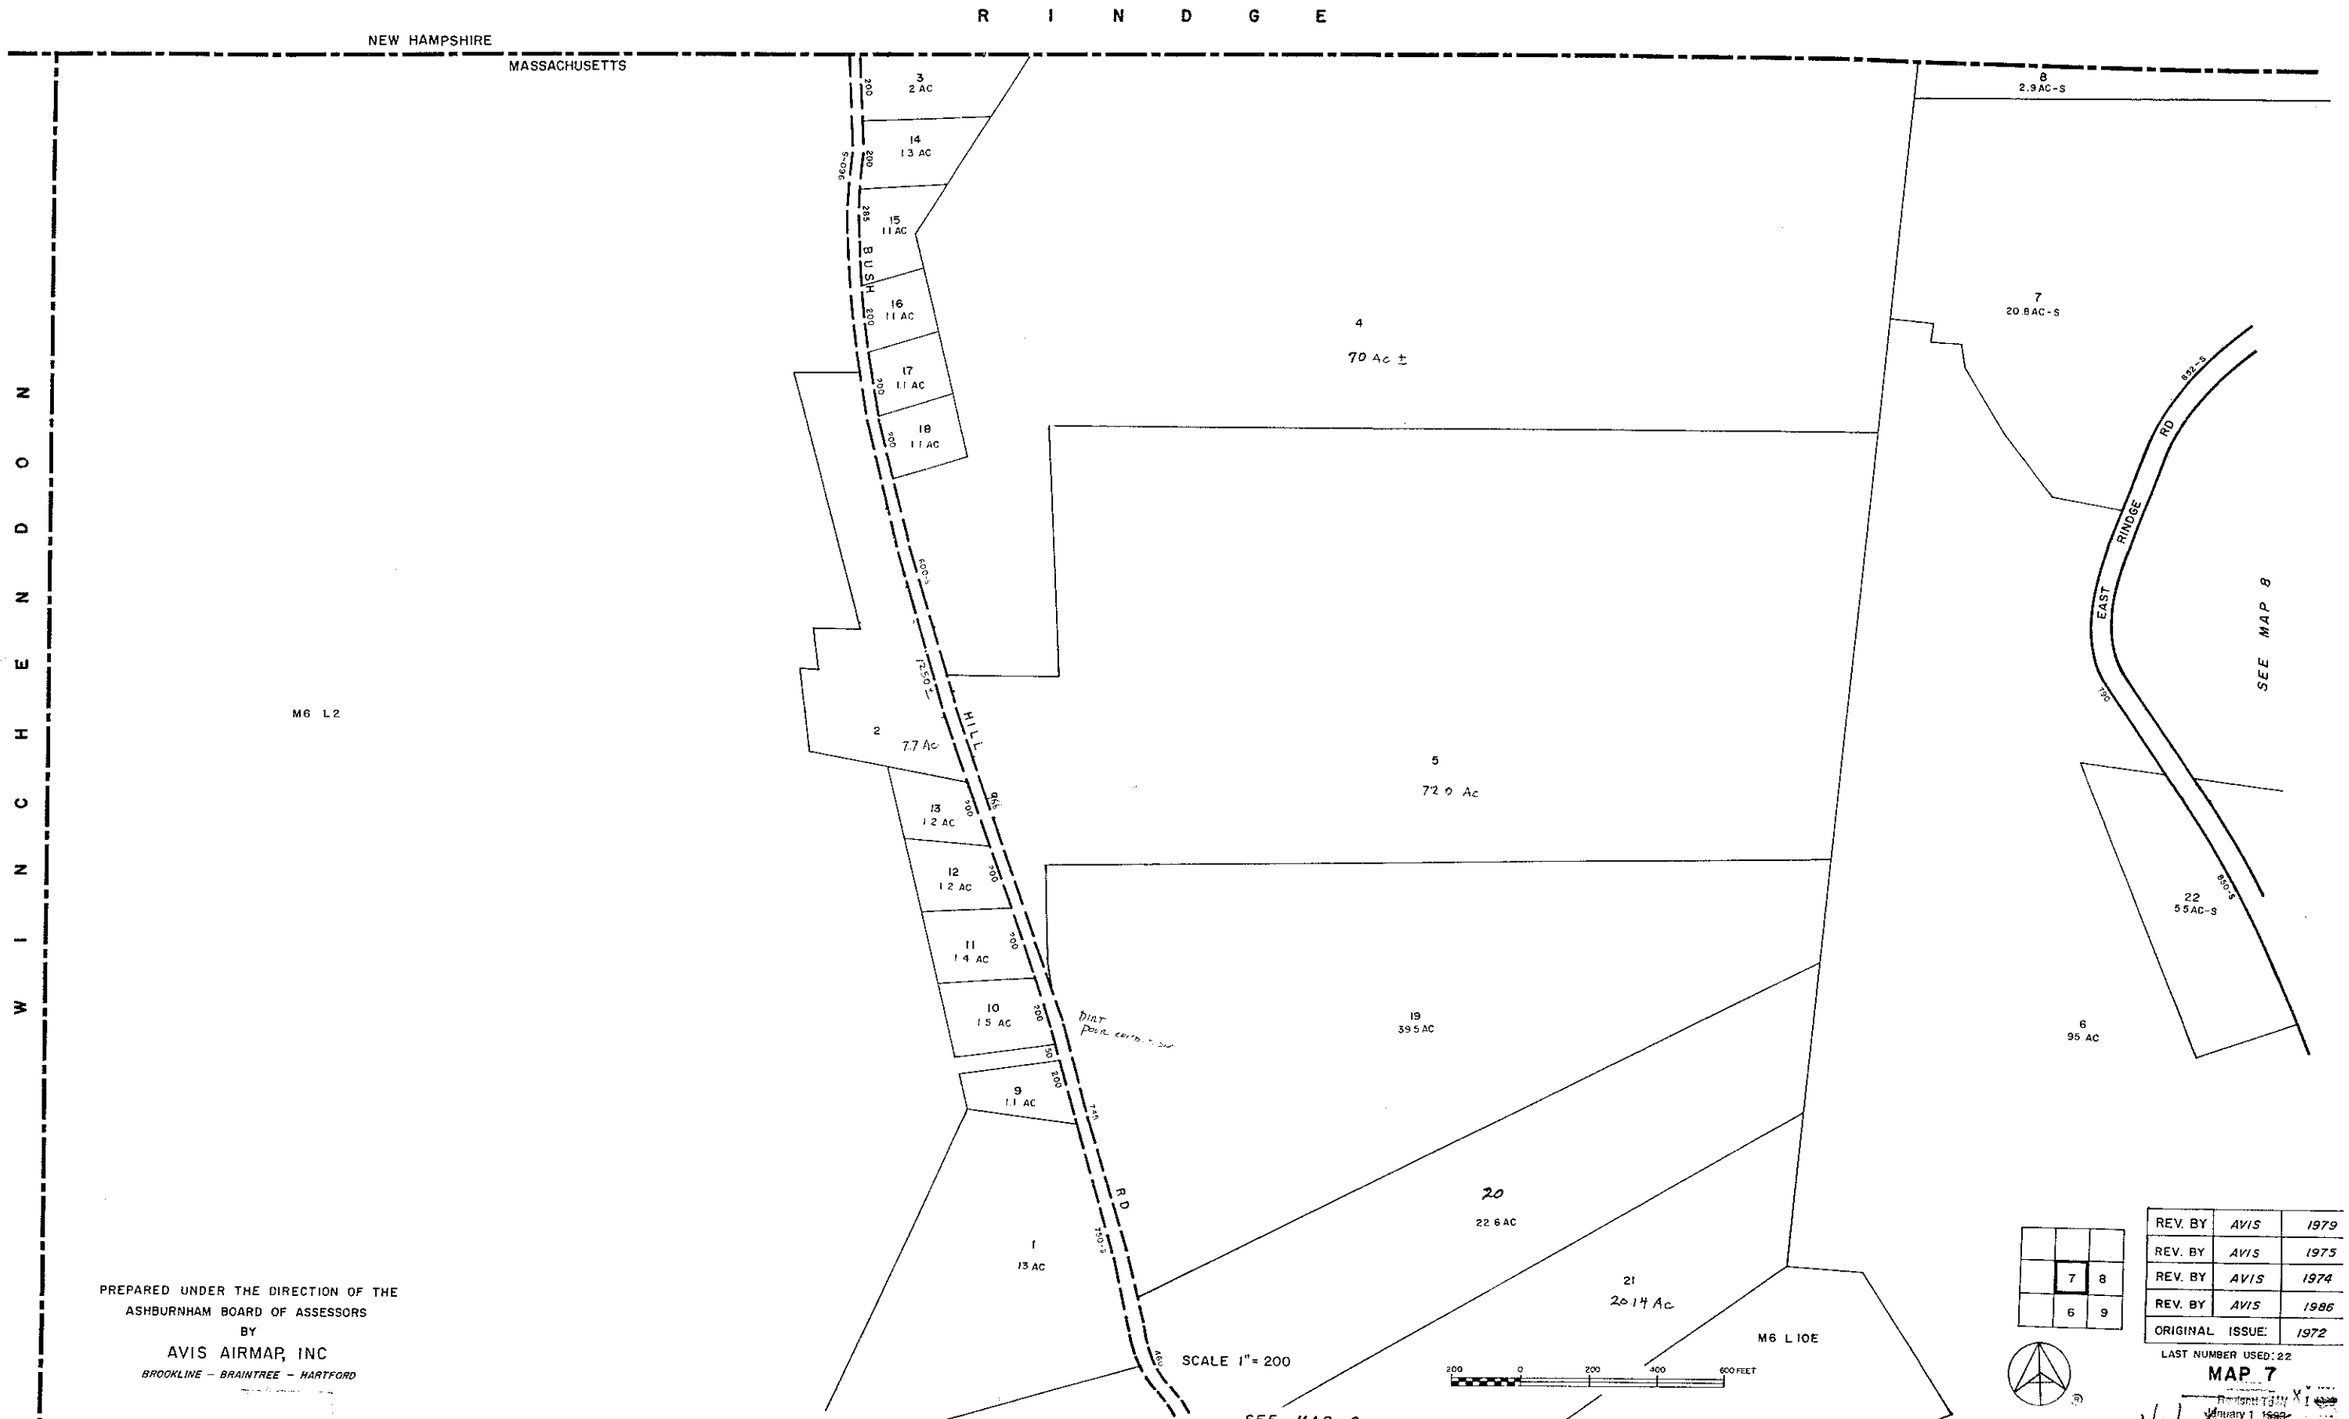


PREPARED UNDER THE DIRECTION OF THE
ASHBURNHAM BOARD OF ASSESSORS
BY
AVIS AIRMAP, INC
*BROOKLINE – BRAINTREE – HARTFORD*

| | | |
|---|---|---|
| REV. BY | AVIS | 1979 |
| REV. BY | AVIS | 1975 |
| REV. BY | AVIS | 1974 |
| REV. BY | AVIS | 1986 |
| ORIGINAL ISSUE: | | 1972 |

LAST NUMBER USED: 22

**MAP 7**

Revised to January 1 1990

1/1/06

# ASHBURNHAM, MASSACHUSETTS

ASSESSORS MAPS

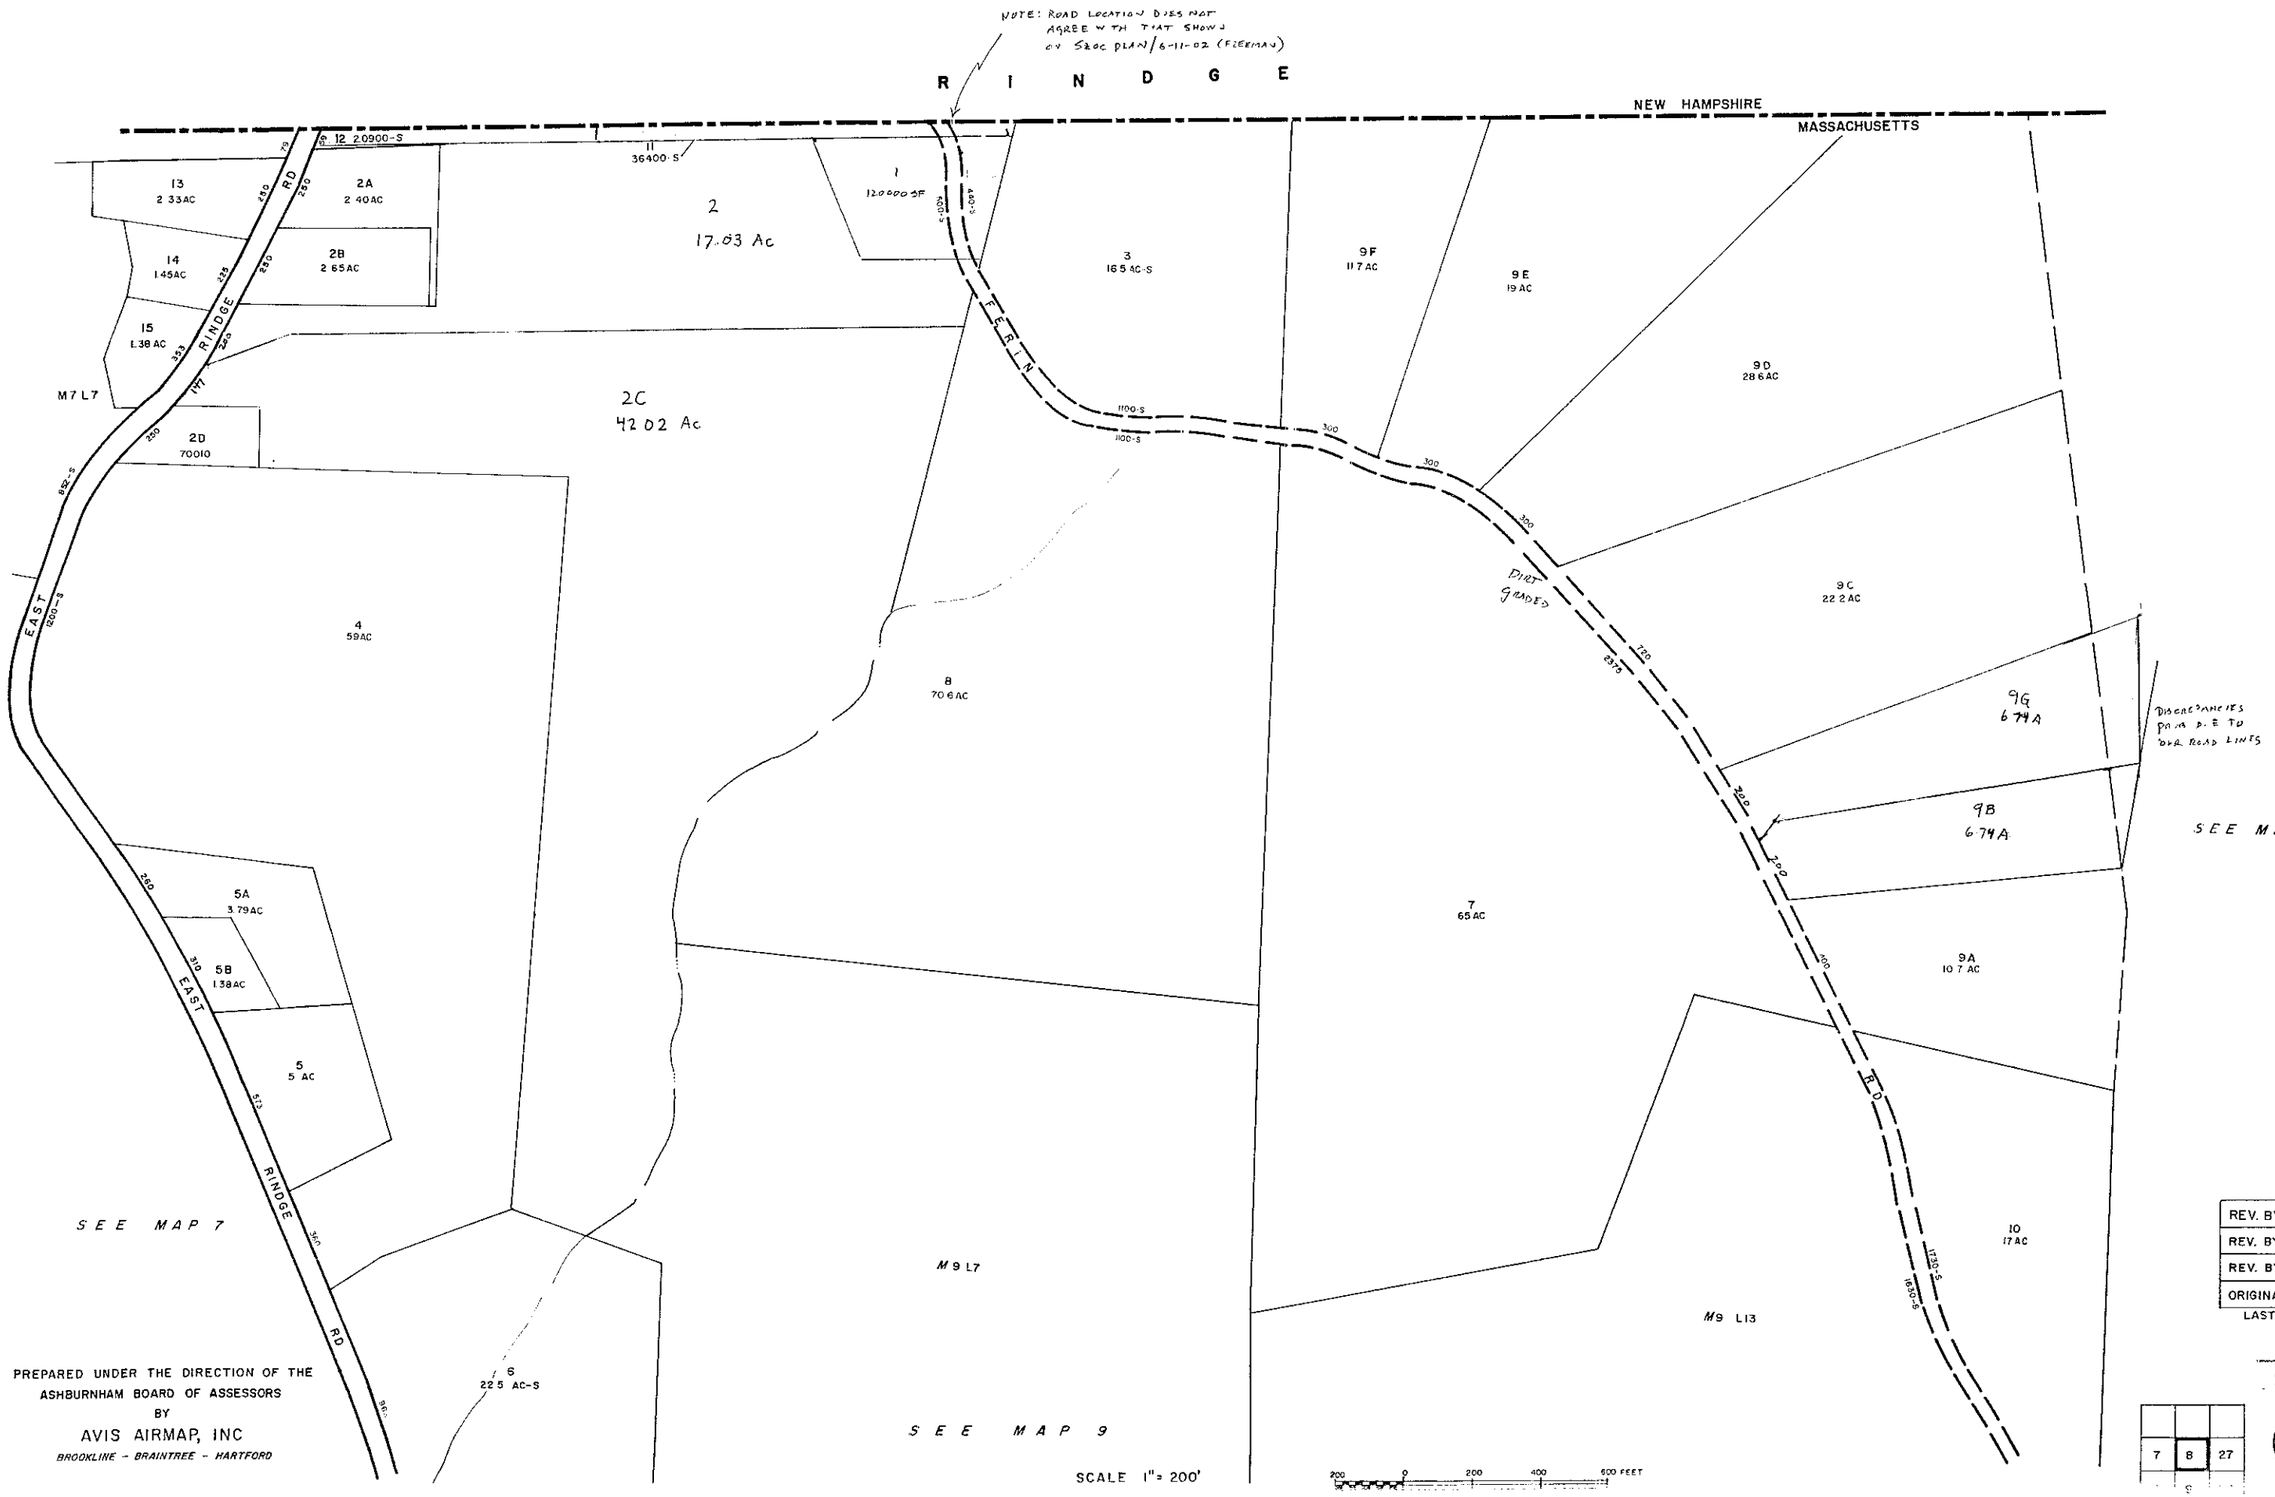


PREPARED UNDER THE DIRECTION OF THE
ASHBURNHAM BOARD OF ASSESSORS
BY
AVIS AIRMAP, INC
*BROOKLINE - BRAINTREE - HARTFORD*

SCALE 1" = 200'

200 0 200 400 600 FEET

| | | |
|---|---|---|
| REV. BY | AVIS | 1979 |
| REV. BY | AVIS | 1975 |
| REV. BY | AVIS | 1986 |
| ORIGINAL ISSUE: | | 1972 |

LAST NUMBER USED: 11

**MAP 8**

Revised To Jan January 1, ~~1986~~ 1996

1/1/06

| | | |
|---|---|---|
| 7 | 8 | 27 |

# ASHBURNHAM, MASSACHUSETTS

ASSESSORS MAPS

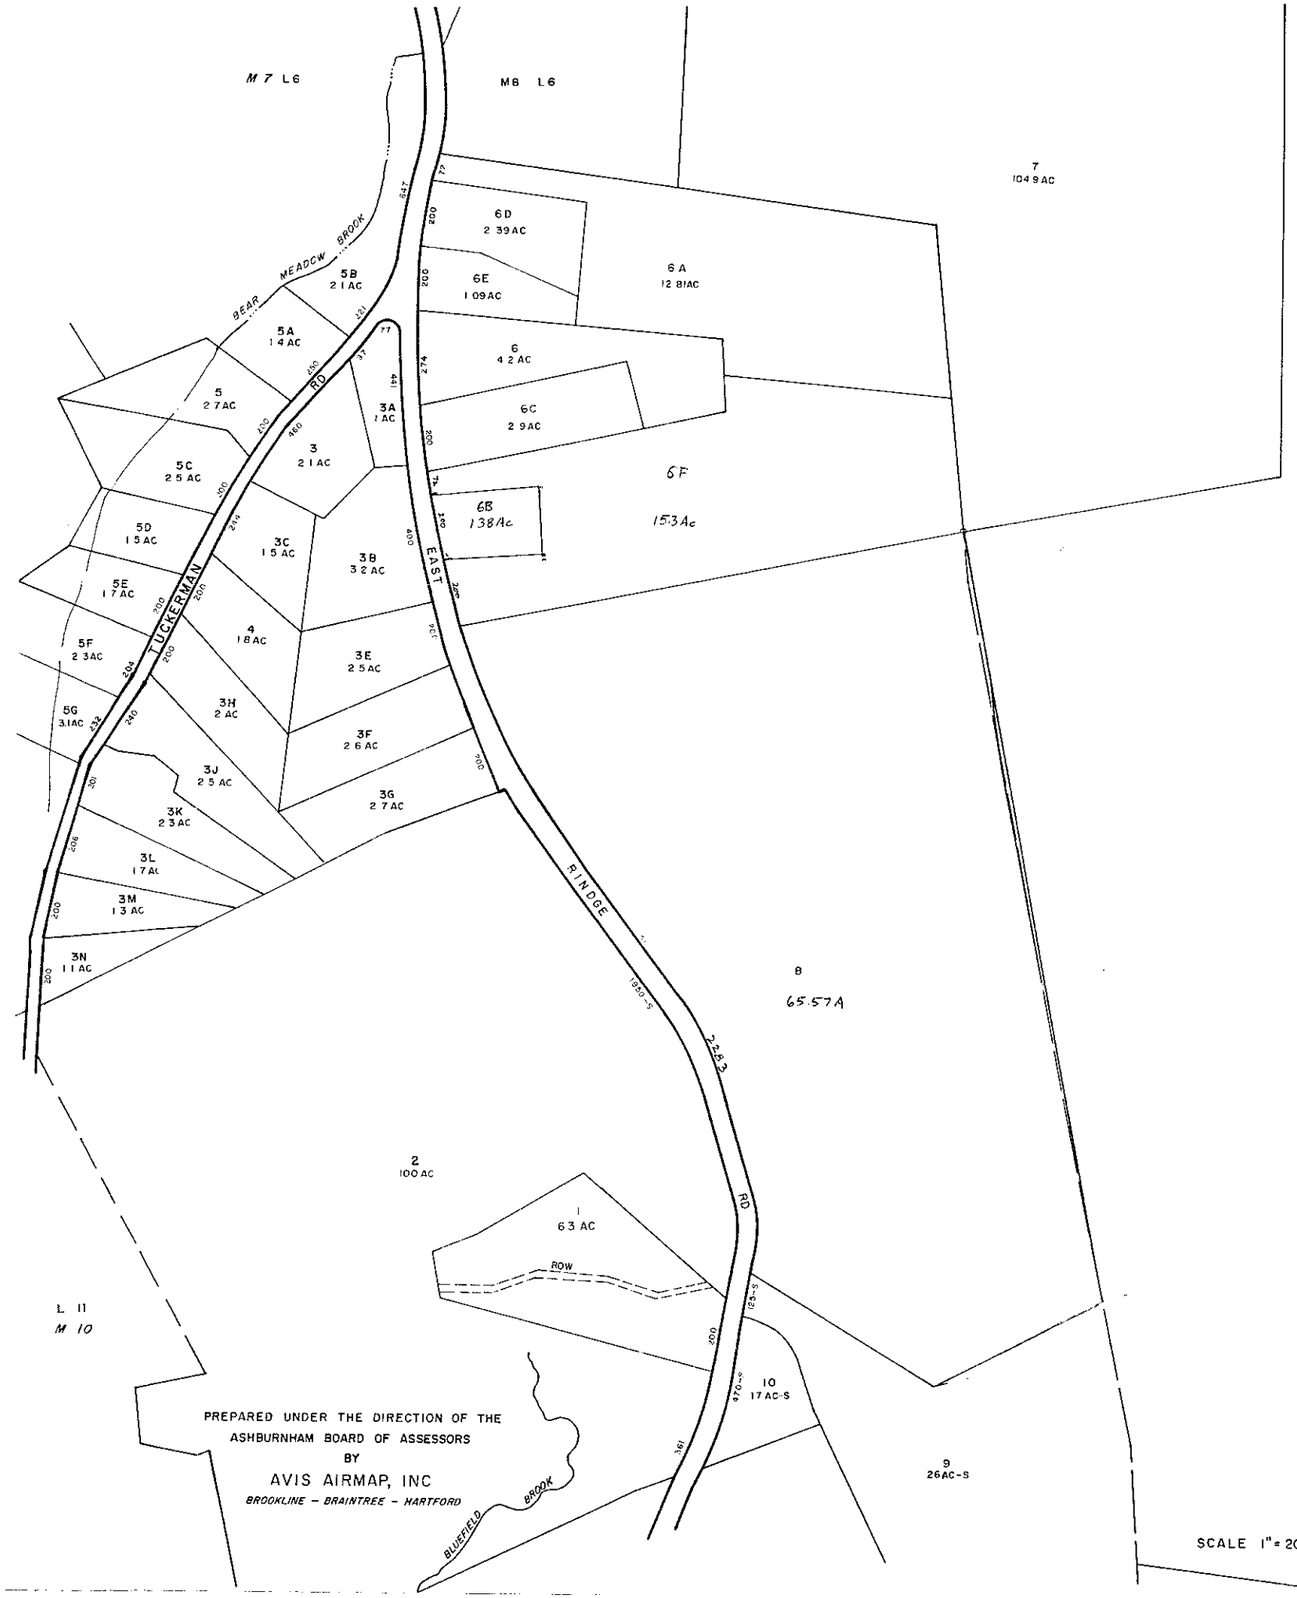


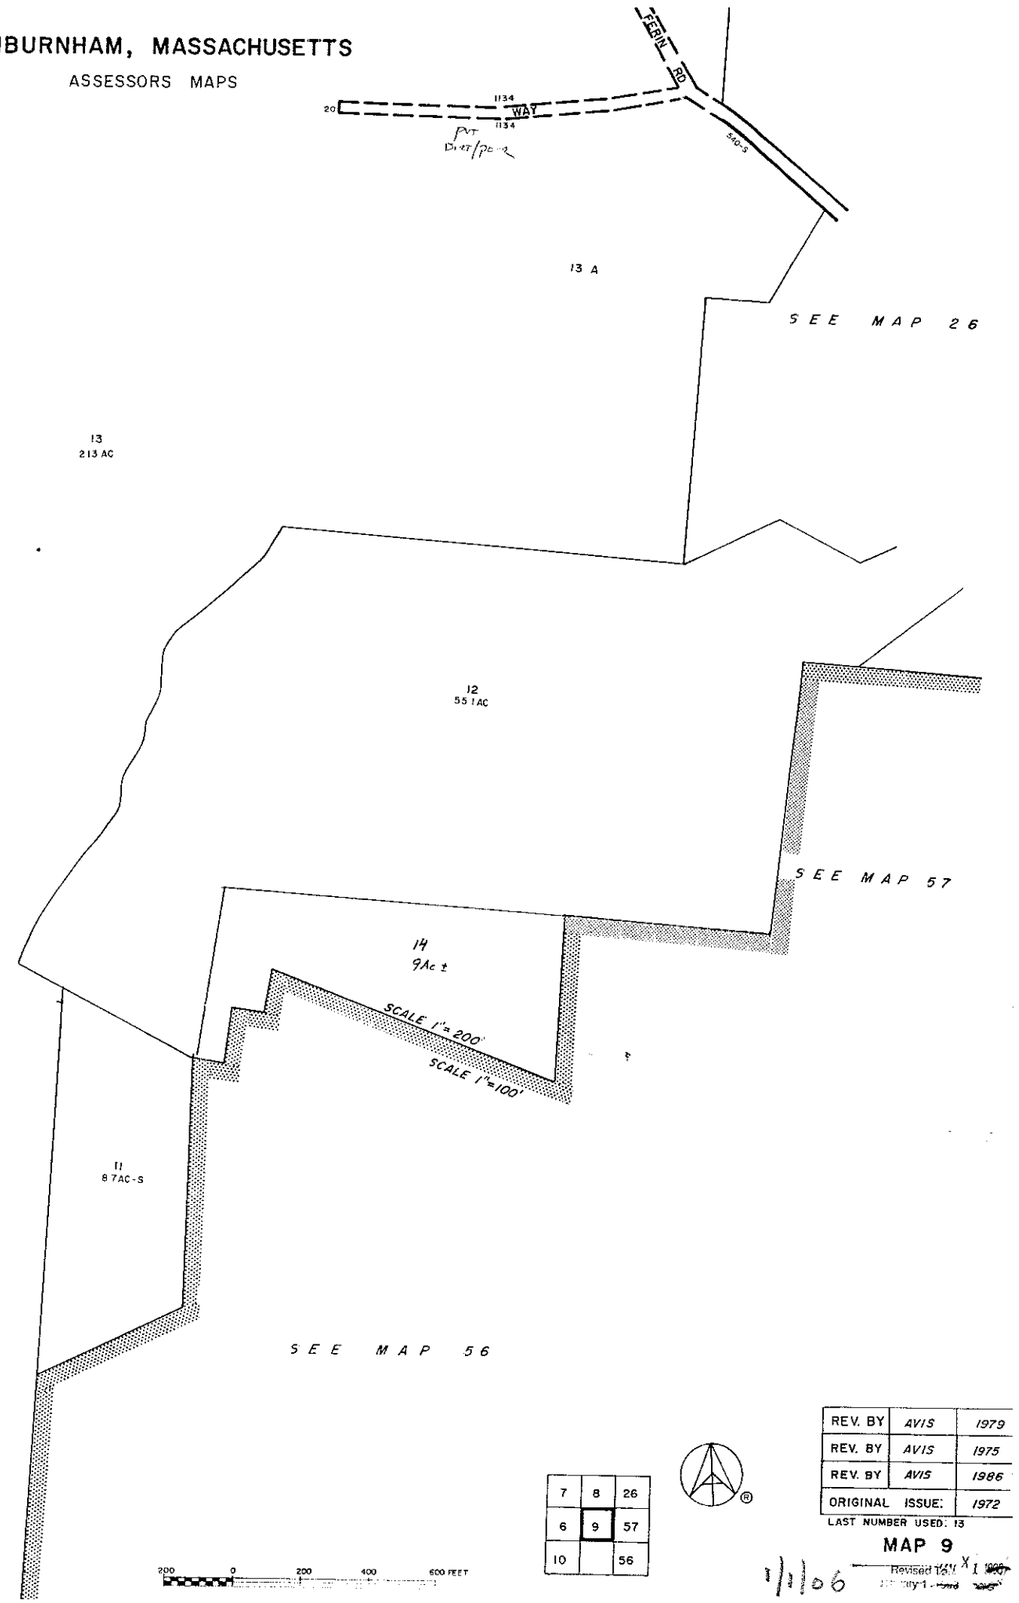


| | | |
|---|---|---|
| REV. BY | AVIS | 1979 |
| REV. BY | AVIS | 1975 |
| REV. BY | AVIS | 1986 |
| ORIGINAL ISSUE: | | 1972 |

LAST NUMBER USED: 13

**MAP 9**

Revised 1/1/1996 by I. [illegible]

1" = 100'

ASSESSORS MAPS

SEE MAP 47

SEE MAP 48

SEE MAP 55

SEE MAP 11

SEE MAP 12

LUCKERMAN RD

YOUNG

EAST RINDGE RD

MILLERS RIVER

DRAINAGE EASEMENT

LAKE SHORE DR

RD

7G 35Ac±

7 30Ac

7F 600 sf

9 1.8AC-S

7E 4.3Ac±

7D 3.1Ac±

7C 3.2Ac±

7B 2.3Ac±

7A 4.2Ac±

10 2500 sf

11 50AC

13 14.1 AC

8 20 AC-S

6D 1.348 AC

6C 1.377AC

6B 1.397AC

6A 1.380AC

12 2 AC

5A 1.160AC

16 1.1AC

L 70 M 47

8A 8 AC-S

6B 6.88 AC

5 9.1 AC-S

8B 22.4 AC

17 165.75 AC

4 33.23 Ac

14 55 AC-S

L 9 M 9

4B 4.30Ac

4A 4.15Ac

15 5 AC

3 14.4 AC

2 57.7AC-S

1 1.5AC

R O W

SCALE 1"=100'

SCALE 1"=200'

SCALE 1"=200

SCALE 1" = 200

200 0 200 400 600 FEET

| | | |
|---|---|---|
| 47 | 9 | 55 |
| 48 | 10 | 11 |
| 54 | 12 | 12 |

PARED UNDER THE DIRECTION OF THE
ASHBURNHAM BOARD OF ASSESSORS
BY
AVIS AIRMAP, INC
BROOKLINE - BRAINTREE - HARTFORD

| | | |
|---|---|---|
| REV. BY | AVIS | 1979 |
| REV. BY | AVIS | 1975 |
| LAST Nº USED: | | 68 |
| ORIGINAL ISSUE: | | 1972 |

MAP 10
Revised To: 1977
1/1/06

# ASHBURNHAM, MASSACHUSETTS

ASSESSORS MAPS

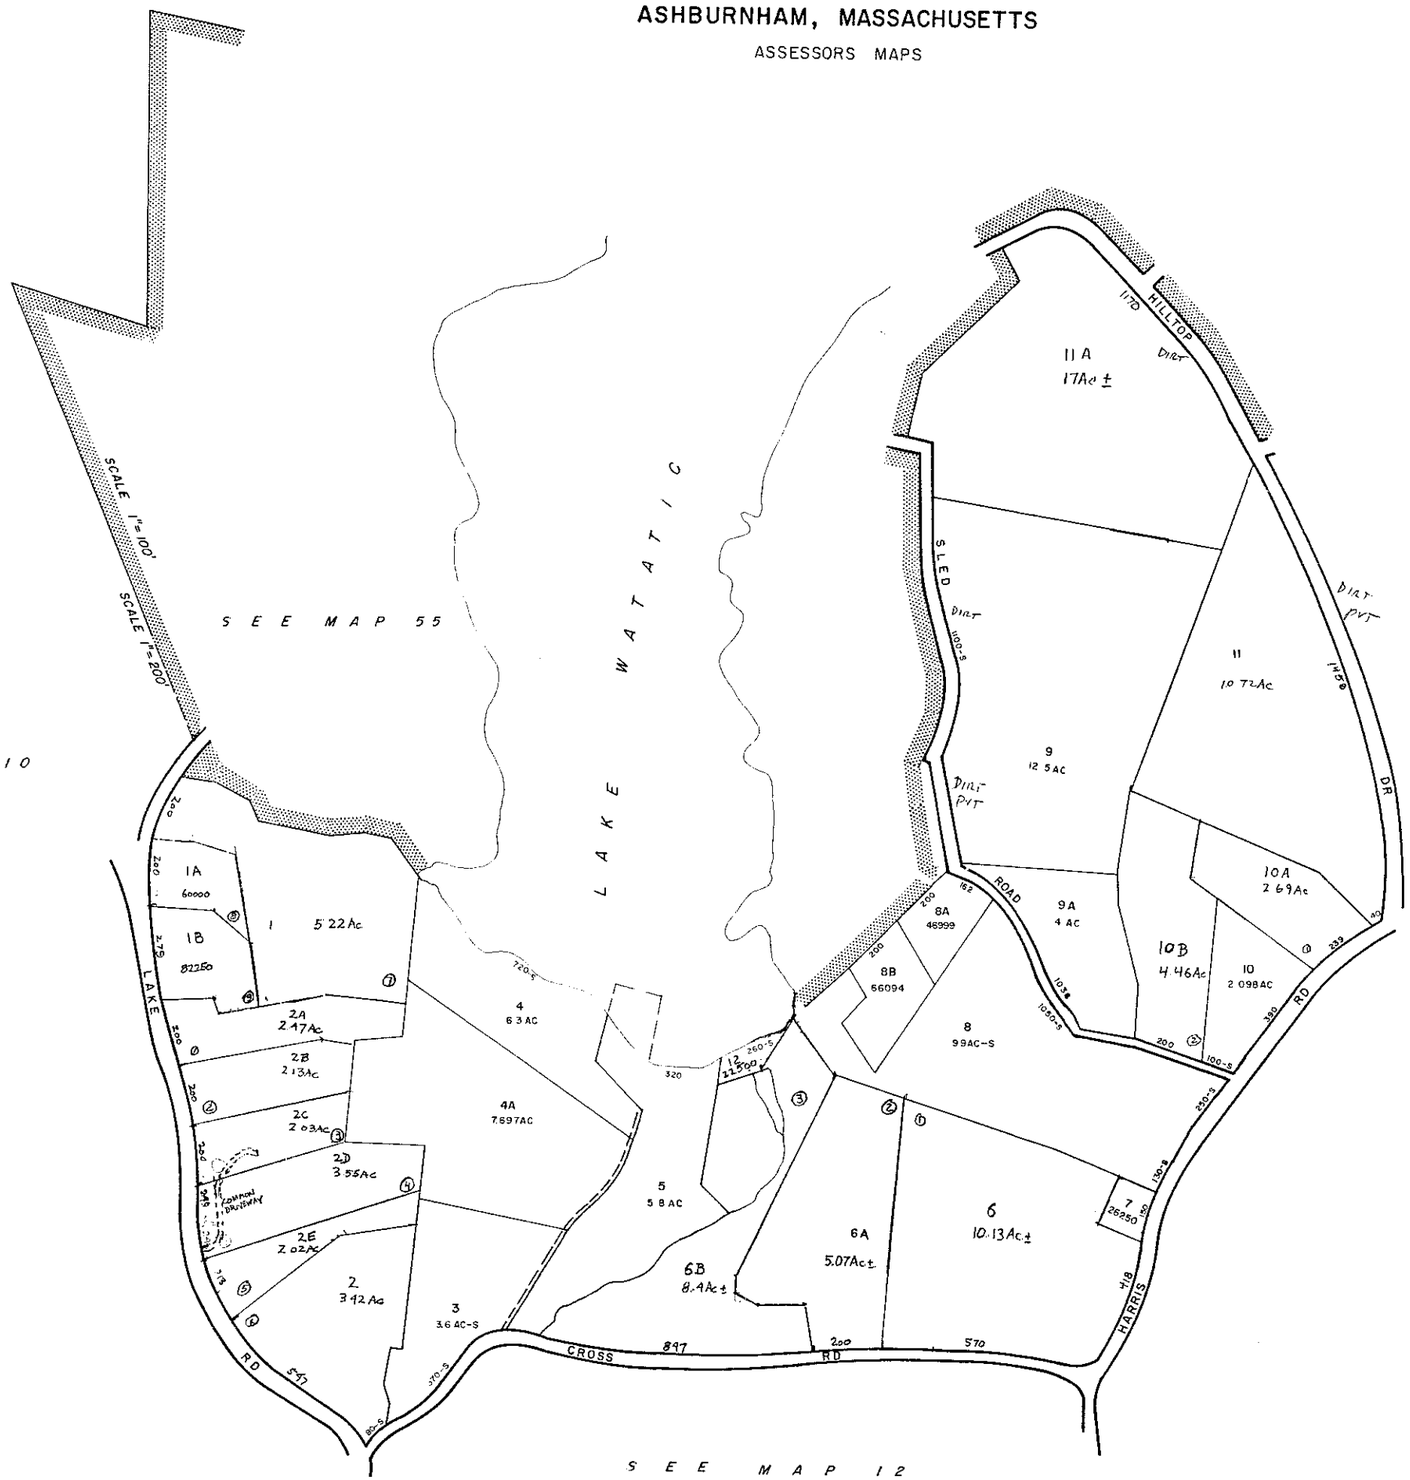


PREPARED UNDER THE DIRECTION OF THE
ASHBURNHAM BOARD OF ASSESSORS
BY
AVIS AIRMAP, INC
*BROOKLINE – BRAINTREE – HARTFORD*

| REV. BY | AVIS | 1979 |
|---|---|---|
| REV. BY | AVIS | 1975 |
| LAST Nº USED: | | 12 |
| ORIGINAL ISSUE: | | 1972 |

| | | |
|---|---|---|
| | 55 | 56 |
| 10 | 11 | 25 |

MAP 11 1/1/06
Revised To

# ASHBURNHAM, MASSACHUSETTS

ASSESSORS MAPS

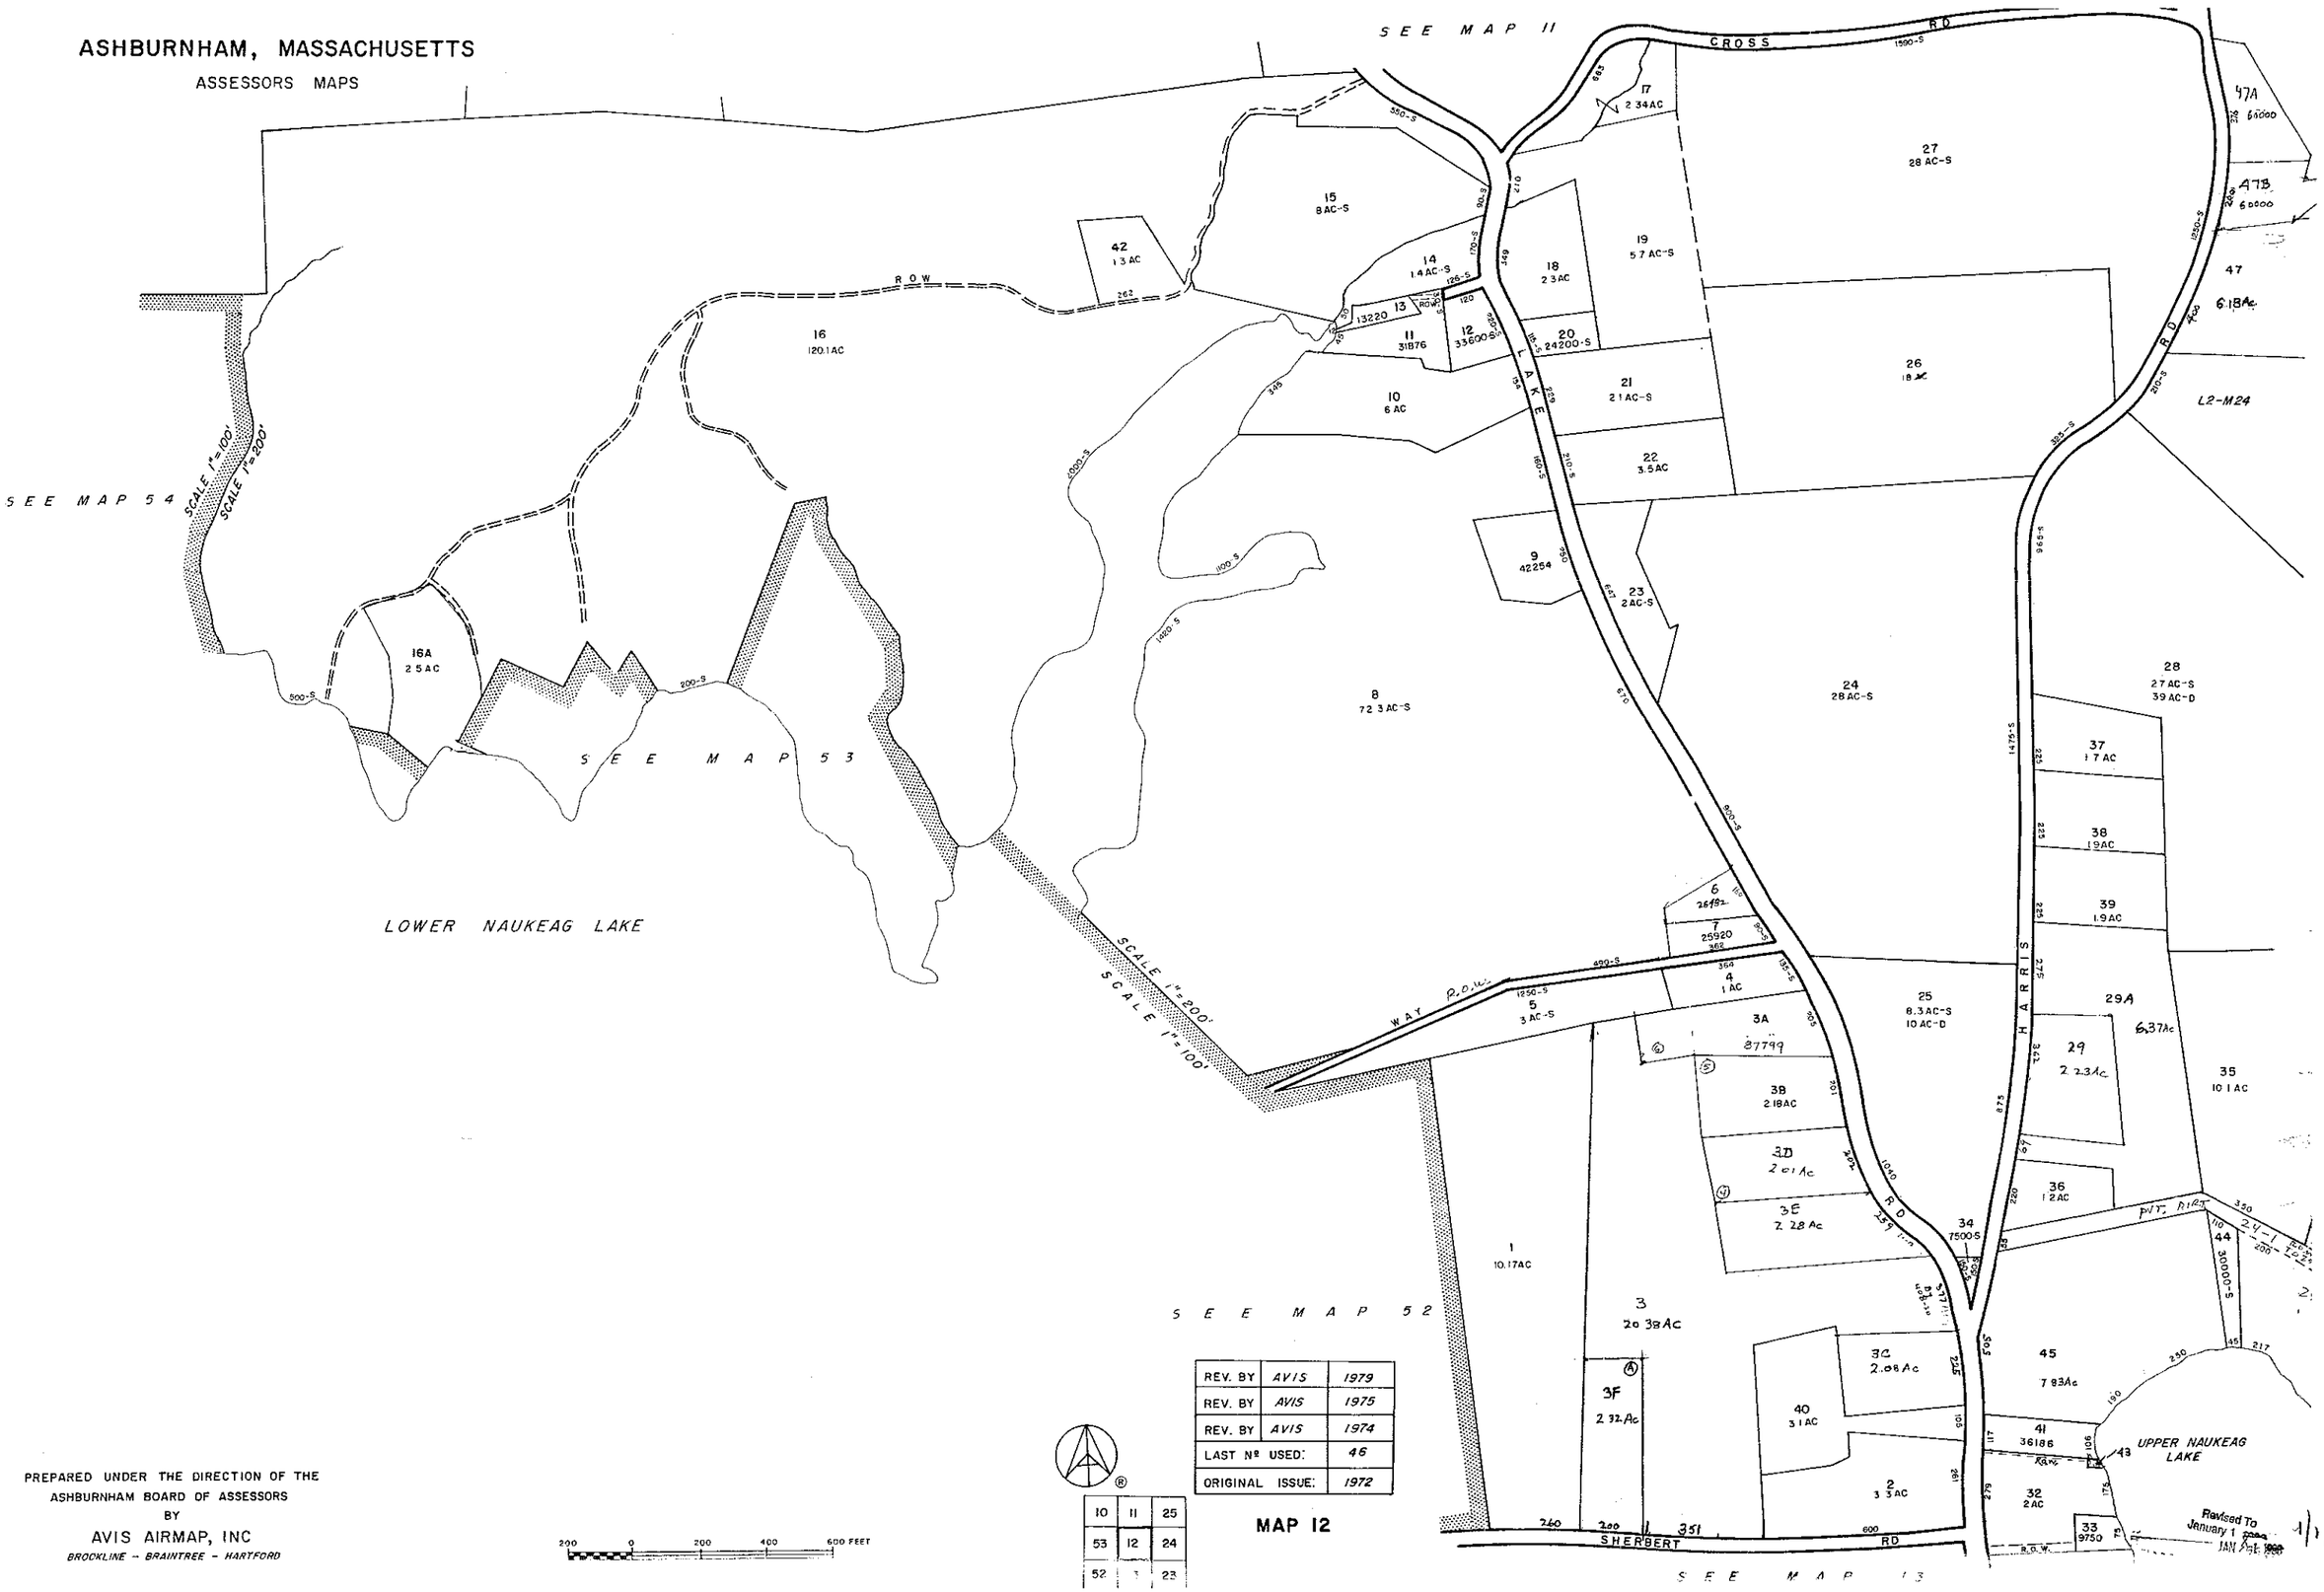


| | | |
|---|---|---|
| REV. BY | AVIS | 1979 |
| REV. BY | AVIS | 1975 |
| REV. BY | AVIS | 1974 |
| LAST Nº USED: | | 46 |
| ORIGINAL ISSUE: | | 1972 |

**MAP 12**

| | | |
|---|---|---|
| 10 | 11 | 25 |
| 53 | 12 | 24 |
| 52 | | 23 |

200 0 200 400 600 FEET

Revised To January 1 1/1/06

PREPARED UNDER THE DIRECTION OF THE
ASHBURNHAM BOARD OF ASSESSORS
BY
AVIS AIRMAP, INC
*BROCKLINE – BRAINTREE – HARTFORD*

# ASHBURNHAM, MASSACHUSETTS

ASSESSORS MAPS

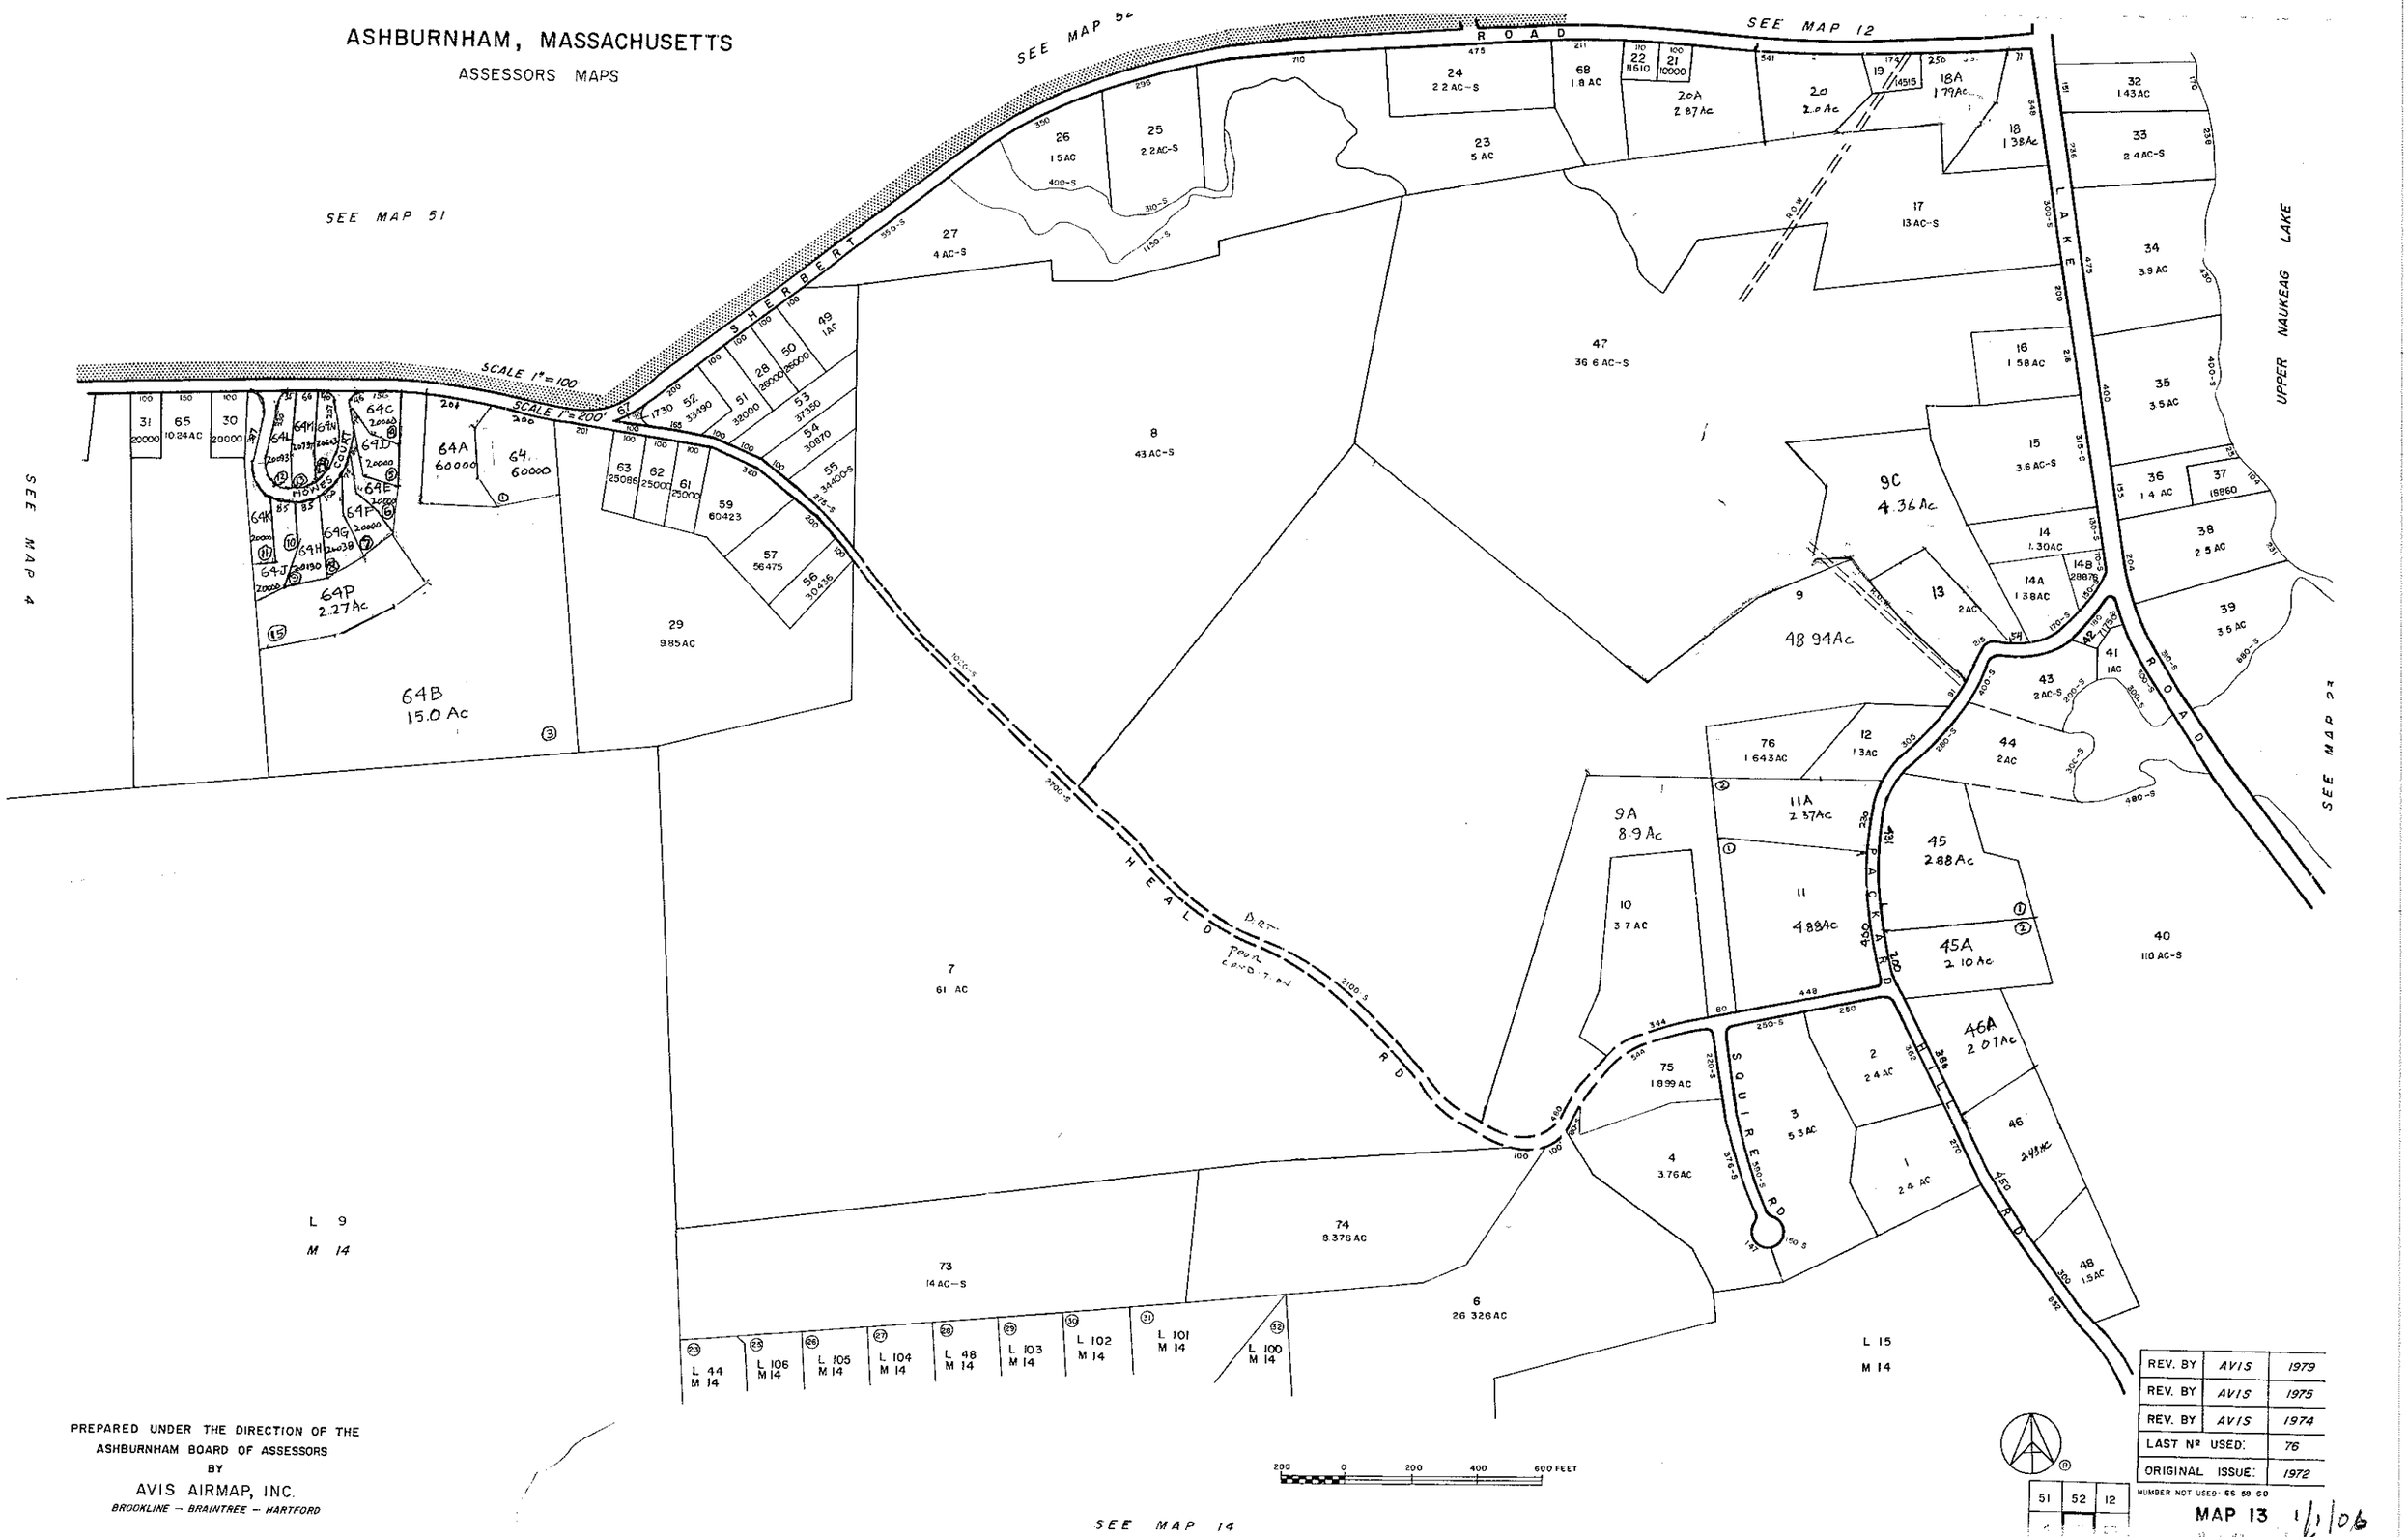


PREPARED UNDER THE DIRECTION OF THE
ASHBURNHAM BOARD OF ASSESSORS
BY
AVIS AIRMAP, INC.
*BROOKLINE — BRAINTREE — HARTFORD*

| | | |
|---|---|---|
| REV. BY | AVIS | 1979 |
| REV. BY | AVIS | 1975 |
| REV. BY | AVIS | 1974 |
| LAST Nº USED: | | 76 |
| ORIGINAL ISSUE: | | 1972 |

NUMBER NOT USED: 65 59 60

MAP 13 1/1/06

| | | |
|---|---|---|
| 51 | 52 | 12 |
| | | |

# ASHBURNHAM, MASSACHUSTTS

ASSESSORS MAPS

SEE MAP 13

SEE MAP 3

SEE MAP 15

SEE MAP 22

SIBLEY ROAD

LINCOLN AVENUE

HUNTER AVENUE

BIRCHWOOD TERRACE

PACKARD HILL ROAD

WINCHENDON ROAD

CHESHIRE POND RD.

WILLIAMS PASSAGE

COUSHLIN (HIGHWAY NO 12)

DISCONTINUED

NEW ENGLAND POWER CO EASEMENT

L 6 M 13

L 5 M 22

| | | | |
|---|---|---|---|
| 106 | 105 | 104 | 48 |
| 45028 | 50757 | 51984 | 53214 |
| 200 | 200 | 200 | 200 |

| | | | |
|---|---|---|---|
| 103 | 102 | 101 | 100 |
| 54442 | 55672 | 96601 | 97447 |
| 200 | 200 | 200 | |

| | | | |
|---|---|---|---|
| 44 | 71 | 107 | 90 |
| 89205 | 38580 | 50033 | 49984 |
| R.O.W. | | | |

| | | | |
|---|---|---|---|
| 91 | 93 | 89 | 94 |
| 59988 | 49863 | 60018 | 60176 |

| | | | |
|---|---|---|---|
| 99 | 68 | 70 | 72 |
| 82507 | 45018 | 50846 | 50846 |

| | | | |
|---|---|---|---|
| 88 | 95 | 98 | 60 |
| 69866 | 69702 | 60895 | 45095 |

| | | | |
|---|---|---|---|
| 69 | 73 | 61 | 67 |
| 50846 | 50846 | 45171 | 50846 |

| | | | |
|---|---|---|---|
| 74 | 97 | 84101 | 62 |
| 50846 | 4.9 AC | | 45021 |

| | | | |
|---|---|---|---|
| 66 | 75 | 49 | 59 |
| 50846 | 50846 | 83109 | 45081 |

| | | | |
|---|---|---|---|
| 65 | 76 | 85 | 96 |
| 50871 | 50846 | 2.14 AC | 57950 |

| | | | |
|---|---|---|---|
| 63 | 57 | 77 | 84 |
| 45142 | 50846 | 50846 | 63638 |

| | | | |
|---|---|---|---|
| 54 | 58 | 78 | 83 |
| 56509 | 50847 | 50846 | 57396 |

| | | | |
|---|---|---|---|
| 53 | 64 | 79 | 82 |
| 45274 | 50846 | 89039 | 51380 |

| | | | |
|---|---|---|---|
| 52 | 55 | 41 | |
| 49848 | 48652 | 76911 | |

| | | | |
|---|---|---|---|
| 35 | 34 | 36 | 39 |
| 62030 | 56421 | 47012 | 76300 |

| | | | |
|---|---|---|---|
| 42 | 33 | 37 | 38 |
| 45771 | 45013 | 50712 | 50712 |

| | | | |
|---|---|---|---|
| 43 | 32 | 31 | 30 |
| 45149 | 67658 | 54424 | 48491 |

| | | | |
|---|---|---|---|
| 29 | 28 | 19 | 27 |
| 45014 | 51281 | 54150 | 7500 |

| | | | |
|---|---|---|---|
| 18A | 18B | 18C | 18D |
| 1.66 AC | 1.67 AC | 1.46 AC | 53257 |

| | | | |
|---|---|---|---|
| 19B | 17C | 17 | 17A |
| 52075 | 2.99 AC | 1.53 AC | 651516 |

| | | | |
|---|---|---|---|
| 17B | 2C | 2B | 2A |
| 61724 | 67604 | 61000 | 60388 |

| | | | |
|---|---|---|---|
| 3A | 3B | 3J | 3C |
| 60064 | 60218 | 65715 | 60209 |

| | | | |
|---|---|---|---|
| 3H | 3G | 3D | 3F |
| 63632 | 61599 | 60198 | 60227 |

| | | | |
|---|---|---|---|
| 3E | 3K | 3 | 4 |
| 61805 | 1.35 AC | | 1.89 AC |

| | | | |
|---|---|---|---|
| 4A | 1.99 A | 5 | 24 AC |
| 6 | 31580 | 7 | 44 AC-S |

| | | | |
|---|---|---|---|
| 8 | 6.96 AC | 8A | 4.6 AC |
| 8B | 17.01 AC | 9 | 166.5 AC |

| | | | |
|---|---|---|---|
| 10 | 36.5 AC | 11 | 52.1 AC |
| 12 | 5.6 AC | 13 | 4.6 AC |
| 14 | 2 AC | 15 | 35.0 AC |
| 15A | 2.0 AC | | |

| | | | |
|---|---|---|---|
| 16 | 31.9 AC | 17 | 18.4 AC-S |
| 18 | 49 | 19 | 20 |
| 89.3 AC-S | | | |

| | | | |
|---|---|---|---|
| 21 | 18.4 AC-S | 22 | 4.1 AC-S |
| 23 | 59 AC-S | 24 | 5.79 AC |
| 24A | 4.28 AC | 24B | 1.048 AC |
| 24C | 1.303 AC | 25 | 4.2 AC |
| 26 | 18.95 AC | 26A | 3.046 AC |

| | | | |
|---|---|---|---|
| 1A | 2.14 Ac | 1 | 10.265 Ac |
| 2 | 6.98 Ac | | |

| | | | |
|---|---|---|---|
| 4 | 13 | 23 | |
| 3 | 14 | 22 | |
| 2 | 15 | 21 | |

18 24.32 Ac

PREPARED UNDER THE DIRECTION OF THE
ASHBURNHAM BOARD OF ASSESSORS
BY
AVIS AIRMAP, INC
*BROOKLINE – BRAINTREE – HARTFORD*

200 0 200 400 600 FEET

| | | |
|---|---|---|
| REV. BY | AVIS | 1975 |
| REV. BY | AVIS | 1975 |
| LAST Nº USED: | | 107 |
| ORIGINAL ISSUE: | | 1972 |

MAP 14 1/1/06

Revised To January 1, ~~1993~~ 1996

# ASHBURNHAM, MASSACHUSETTS

ASSESSORS MAPS

SEE MAP 14

CHESHIRE POND

L3K M14

L3 M 14

L3E M14

L 2 M 14

L 25 M 14

L 24 M 14

L 24A M 14

L1A M14

L 1 M 14

L1B M14

8
130.6 AC

6
7.3 AC-S

5
3.5 AC

7
61 AC

NEW ENGLAND POWER CO EASEMENT

9
269 AC

L 156 M 21

SEE MAP 2

L 6 M2

3
7.5 AC - S

BOSTON MAINE R.R.

OLD COUNTY RD

600-S

60-S

4
1.7 AC-S

630-S

670-S

1
6.8 AC-S

dirt w/ poor condition

L 7 M2

2
30 AC

L 11 M16

2650-S

RD

L 15A M 16

L 13 M16

SEE MAP 16

SCALE 1" = 200'

200 0 200 400 600 FEET

PREPARED UNDER THE DIRECTION OF THE
ASHBURNHAM BOARD OF ASSESSORS
BY
AVIS AIRMAP, INC.
*BROOKLINE — BRAINTREE — HARTFORD*

| | | |
|---|---|---|
| 1986 | | |
| REV. BY | AVIS | 1979 |
| LAST Nº USED: | | 9 |
| ORIGINAL ISSUE: | | 1972 |

| | | |
|---|---|---|
| 3 | 14 | 22 |
| 2 | 15 | 21 |
| 1 | 16 | 20 |

MAP 15 1/1/06

Revised To 1985

# ASHBURNHAM, MASSACHUSETTS

ASSESSORS MAPS

SEE MAP 15

L 5 M1

L 2 M 15

L 9 M15

L9 M15

15 A

OLD COUNTY

NEW ENGLAND POWER COMPANY R.O.W.

6 13 AC-S

7 30000 -S

8 13 AC

9 10000 S

WAMPANOAG

5 12 AC

4 15 AC-S

3 13 AC

12 25 85 AC

13 26 58 AC

11 122 AC

DIRT V. POOR COND. 17.0.0

1892

EATON RD

DISCONTINUED

L 12B M 20

20 14.57 AC-S

18 15 AC

17 9.5 AC

16 9 AC

19A 10 4 AC-S

L 12D M20

L12A M20

SDA 1.03 AC-S

L 11 M 20

10 16 5 AC-S

19 43 AC-S

L7-M20

SEE MAP 20

1 30000-S

2 34 AC-S

SEE MAP 1

L 49 M 17

200 0 200 400 600 FEET

SEE MAP 17

PREPARED UNDER THE DIRECTION OF THE
ASHBURNHAM BOARD OF ASSESSORS
BY
AVIS AIRMAP, INC.
*BROOKLINE - BRAINTREE - HARTFORD*

| | | |
|---|---|---|
| 1986 | | |
| REV. BY | AVIS | 197 |
| REV. BY | AVIS | 197 |
| REV. BY | AVIS | 197 |
| LAST Nº USED: | | 20 |
| ORIGINAL ISSUE: | | 197 |

| | | |
|---|---|---|
| 2 | 15 | 21 |
| 1 | 16 | 20 |
| | 17 | 19 |

**MAP 16** 1/1/06

Revised To JAN X 1
January 1,

# ASHBURNHAM, MASSACHUSETTS

ASSESSORS MAPS

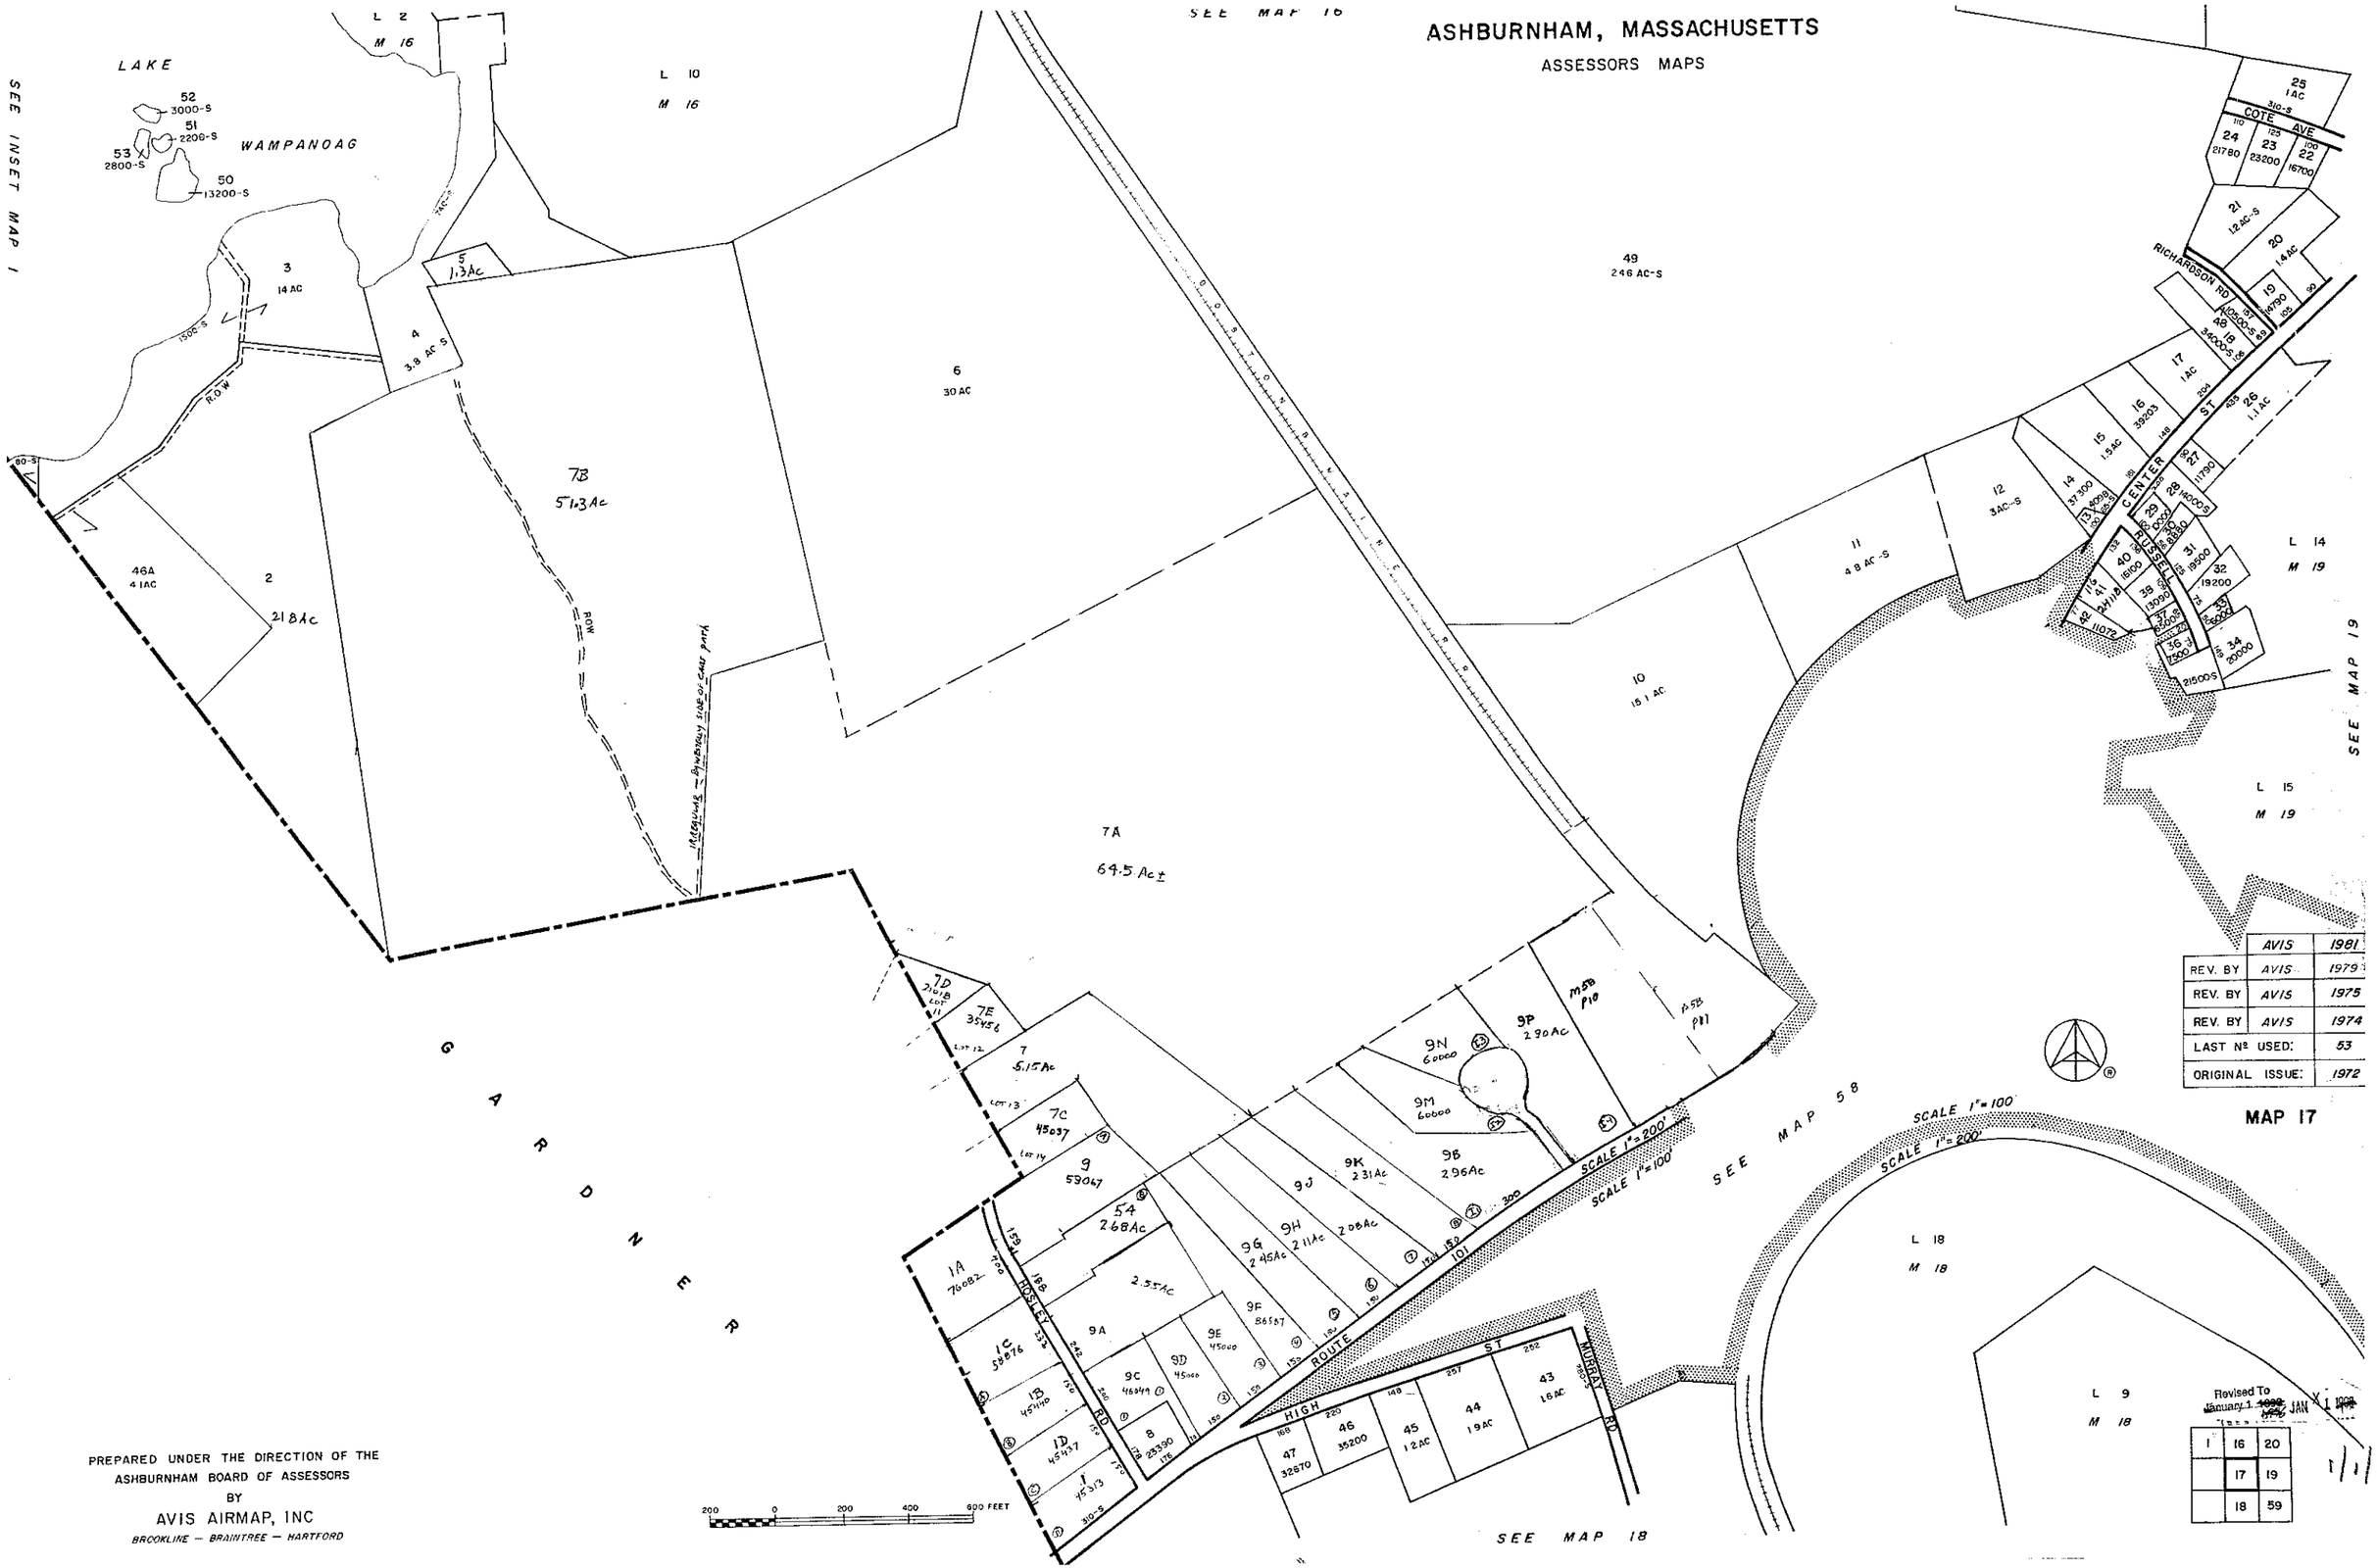


| | AVIS | 1981 |
|---|---|---|
| REV. BY | AVIS | 1979 |
| REV. BY | AVIS | 1975 |
| REV. BY | AVIS | 1974 |
| LAST Nº USED: | | 53 |
| ORIGINAL ISSUE: | | 1972 |

**MAP 17**

Revised To January 1 ~~1998~~ 1999 JAN X 1 1999

| | | |
|---|---|---|
| 1 | 16 | 20 |
| | 17 | 19 |
| | 18 | 59 |

1/1/06

PREPARED UNDER THE DIRECTION OF THE
ASHBURNHAM BOARD OF ASSESSORS
BY
AVIS AIRMAP, INC
*BROOKLINE — BRAINTREE — HARTFORD*

# ASHBURNHAM, MASSACHUSETTS

ASSESSORS MAPS

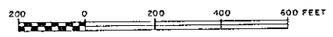


PREPARED UNDER THE DIRECTION OF THE
ASHBURNHAM BOARD OF ASSESSORS
BY

AVIS AIRMAP, INC

*BROOKLINE – BRAINTREE – HARTFORD*

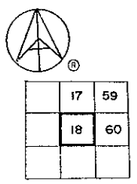


| | | |
|---|---|---|
| REV. BY | AVIS | 1979 |
| REV. BY | AVIS | 1975 |
| LAST Nº USED: | | 21 |
| ORIGINAL ISSUE: | | 1972 |

**MAP 18** 1/1/66

Revised To January 1 ~~1979~~ 1975

# ASHBURNHAM, MASSACHUSETTS

## ASSESSORS MAPS

SEE MAP 17

SEE MAP 59

SEE MAP 60

SEE MAP 36

SEE MAP 20

COTE AVE
CENTER ST
MELE AVE
WILLIAMS RD
PLATTS RD
NEW ENGLAND
POWER CO EASEMENT
WHITMAN RIVER
WESTMINSTER
NEWMAN RD

1 .89AC
2 .37500
3 .33570
4 .25000
5 .25000
6 .30000
7 43.88 Ac.
8 .30970
9 2.71 AC
10 .32830
11 .18900-S
12 .15900-S
13 1.4 AC
14 20.3 AC
15 31.1 AC
16 3.06Ac
16A
17 1.3 AC-S
17A 1.2 AC
18 7.6 AC
19 10000
20 17.5 AC
21 1.5 AC
22 5.5 AC-S
23 2.68 Ac
23A .58.05
23B 10.125Ac
24 .5360
25 1.3 AC-S
26 .2300
27 .3106
28 .6890
29 .1480
30 .7660
31 3.3 AC
31A 3.2 Ac
31B 7.65Ac
31C 2.84Ac
31D 1.93Ac
32 .2 AC
33 1.3 AC-S
34 .1 AC
35 2.8 AC
36 1.1 AC
37 1.77 AC
37A 4.1 Ac
37B 44000
37C 5000
38 0.85 AC
38A .32670
39 .52771
39A .5615
40 1.5 AC
41 23.3 AC
42 31.1 Ac ±
43 3.2 Ac
44 2 AC
45 .5555
46 .5555
47 3.6 AC
47A 3.2 AC
47B 3.02 AC
47C 2.78 AC
47D 2.55 AC
47E 3.9 AC
48 .48130
48A .47836
48B .85058
48C 7.06A
48D 2.79 Ac
48E 2.79 Ac
48F 3.65 Ac
49 55+ Ac
49A 2.88 AC
49B 4.23 AC
49C 3.81 AC
49D 1.66 AC
49E 11.69 AC
49F 3.89 Ac
50 .55183
50B 2.0 AC
51 1.4 AC-S
52 31.13 AC ±
52A 5.56 Ac
52B 5.18 Ac
52C 3.87 Ac.
53 32.9 AC
53A 1.9 AC
53B 1.3 AC
54 .5973
55 2.2 AC
56 .40690
57 .2450
58 .29490
59 .30000
60 2.11 Ac
61 .55973
62 .46083
63 .21780-S
L 41 M 20
L 44 M 20
L 49 M 20
L 63 M 20
L 1 M 36

SCALE 1"= 200'
SCALE 1"=100'

SCALE 1" = 200'

200 0 200 400 600 FEET

PREPARED UNDER THE DIRECTION OF THE
ASHBURNHAM BOARD OF ASSESSORS
BY
AVIS AIRMAP, INC
*BROCKLINE — BRAINTREE — HARTFORD*

| | | |
|---|---|---|
| REV. BY | AVIS | 1979 |
| REV. BY | AVIS | 1975 |
| REV. BY | AVIS | 1974 |
| LAST Nº USED: | | 63 |
| ORIGINAL ISSUE. | | 1972 |

NUMBER NOT USED-32,54

| | | |
|---|---|---|
| 16 | 20 | 35 |
| 17 | 19 | 36 |

**MAP 19** 1/1/06

Revised To: Y

# ASHBURNHAM, MASSACHUSETTS

ASSESSORS MAPS

SCALE 1" = 100'

SCALE 1" = 200'

SEE MAP 21

SEE MAP 16

SEE MAP 19

SEE MAP 35

NOTE: P.B. 465/P.3 THRUS R.R. BED NOW TOWN OF ASHBURNHAM MAPPING ERROR. ADJOINING LOTS HAVE CORRECT DIMENSIONS

PREPARED UNDER THE DIRECTION OF THE ASHBURNHAM BOARD OF ASSESSORS BY AVIS AIRMAP INC

SCALE 1' = 200'

| | | |
|---|---|---|
| REV. BY | AVIS | 197 |
| REV. BY | AVIS | 197 |
| REV. BY | AVIS | 19 |
| REV. BY | AVIS | 19 |
| ORIGINAL ISSUE: | | 197 |
| LAST NO USED | | 9 |

**MAP 20**

Revised To January 1, ~~1995~~ JAN 1 ~~1996~~

1/1/06

| | | |
|---|---|---|
| 15 | 21 | 61 |
| 16 | 20 | 35 |
| 17 | 19 | |

# ASHBURNHAM, MASSACHUSETTS

## ASSESSORS MAPS

SCALE 1" = 200'

SCALE 1" = 100'

SEE MAP 62

SEE MAP 61

SEE MAP 20

SEE MAP 15

PREPARED UNDER THE DIRECTION OF THE
ASHBURNHAM BOARD OF ASSESSORS
BY
AVIS AIRMAP, INC
BRAINTREE - HARTFORD

| | | |
|---|---|---|
| REV. BY | AVIS | 19 |
| REV. BY | AVIS | 19 |
| REV. BY | AVIS | 19 |
| REV. BY | AVIS | 19 |
| ORIGINAL ISSUE: | | 19 |

| | | |
|---|---|---|
| 14 | 22 | 62 |
| 15 | 21 | 61 |
| 16 | 20 | 35 |

**MAP 21**

Revised To
January 1, 1996

1/1/06

# ASHBURNHAM, MASSACHUSETTS

ASSESSORS MAPS

SEE MAP 23

UPPER NAUKEAG LAKE

PACKARD HILL ROAD

LAKE

6 13.6 AC

7A 21.780

L 40 M 13

5 20 AC-S

7 44.0 AC

7B 7.8 AC-S

R O W

COUGHLIN RD

PACKARD HILL RD

COBB

4B 2.149 Ac

L 11 M 14

8 3.9 AC

9 41700

10 28820

4E 3.01 Ac

4 63.8 Ac

17 21.2 AC-S

11 3.9 AC-S

4D 48619

12 1.2 AC

13 1.2 AC

14 31780

15 35100

16 4 AC

17A 1.9 AC-S

18 4.2 AC-S

4C 9.92 AC

4A 49089

3 16650

2 36482

1D 45037

28 26750

31 10000-S

32 1.2 AC

33 23250

35 23750

36 17800

30 40500

SEE MAP 14

M14-P19 25.43 Ac

1E 17.749

1E 2.01 Ac

1A 3.15 Ac

1B 1.76 AC

1C 1.38 AC

1 2.3 AC

HIGHWAY

PREPARED UNDER THE DIRECTION OF THE ASHBURNHAM BOARD OF ASSESSORS BY AVIS AIRMAP, INC.

BROOKLINE – BRAINTREE – HARTFORD

SCALE 1" = 200'

L 2 M 24

19 62.5 AC

L 2 M 33

21B 26.2 AC

21F 3.62 Ac

21E 3.16 Ac

21D 2.58 AC

21 2.1 AC

21C 2.1 AC

21G 1.2 AC

21H 1.1 AC

20 1.3 AC

21A 39.6 AC

44A 3 AC

44 2.8 AC

22 1 AC

HASTINGS RD

MARSHALL HILL RD DISCONTINUED DIRT RD

43 9.6 AC

42 9.6 AC

23A 1.44 AC

23B 14.0 AC

23 5.8 AC

26600-S 26

25 36000-S

39 1 AC-S

27 1.8 AC

24 5.636 Ac

24A 8.679 Ac

29 10.5 AC

37 1 AC

40 1.4 AC

48 1.274 C

L 119F M 21

L 119G M 21

L 134 M 21

L 135 M 21

SEE MAP 21

41A 20 AC

45 10 AC

47 9943403

ASHBY RD (RTE 101)

46A 9.96 A

46 45000

| REV. BY | AVIS | 198 |
|---|---|---|
| REV. BY | AVIS | 19 |
| REV. BY | AVIS | 19 |
| REV. BY | AVIS | 19 |
| ORIGINAL ISSUE: | | 19 |

| | | |
|---|---|---|
| 13 | 23 | 32 |
| 14 | 22 | 33 |
| 15 | 21 | 63 |

LAST NUMBER USED:
NUMBERS NOT USED:

**MAP 22**

Revised To January 1, 1990

1/1/06

# ASHBURNHAM, MASSACHUSETTS

ASSESSORS MAPS

SEE MAP 24

L 5 M 25

UPPER NAUKEAG LAKE

LAKE FRONTAGE - 1¾ MILES

27 19600- LOON ISLAND

26 26000-S CALUMET ISLAND

4 2 AC

GREENWOOD ISLAND

25 7200S TEE ISLAND

24 20400-S COOLIDGE ISLAND

23 26800-S ADAMS ISLAND

LAKE

1 3 AC

2 5.5AC-S

3 6350-S

L40 M13

L6 M22

L 2 M24

8 30 AC

7 6 AC

6 40000

SEE MAP 13

SEE MAP 22

SEE MAP 32

L2-M33

L 21B M 22

| | | |
|---|---|---|
| REV. BY | AVIS | 1980 |
| REV. BY | AVIS | 1975 |
| REV. BY | AVIS | 1974 |
| LAST Nº USED: | | 37 |
| ORIGINAL ISSUE: | | 1972 |

LOT NUMBERS NOT USED - 5, 21

**MAP 23**

PREPARED UNDER THE DIRECTION OF THE
ASHBURNHAM BOARD OF ASSESSORS
BY
AVIS AIRMAP, INC
*BROOKLINE – BRAINTREE – HARTFORD*

200 0 200 400 600 FEET

11 42.78 Ac

10A 2.190 AC

10B 75020

10 4.307AC

11E 1.781AC

11F 3.316AC

11D 1.919AC

11C 2.345AC

11B 84567

11A 73961

22 1AC

9 1.1AC

12C 61207

12G 60000

12F 60000

12E 60000

12D 60000

12 4.60Ac

12B 2.00Ac.

12H 4.69Ac

12A 2.00Ac.

13 2.0 Ac

17B 60000

17 1.8AC

14 8 AC-5

15 4.2 AC

16 6.8 AC

17A 2.7 AC

19A 10.36Ac

19 6.1 Ac

18 40000

28 4.0Ac

20 10 AC

STOWELL RD

KRAETZER RD

HASTINGS RD

Revised To January 1, 1975

| | | |
|---|---|---|
| 12 | 24 | 31 |
| 13 | 23 | 32 |
| 14 | 22 | 33 |

1/1/06

# ASHBURNHAM, MASSACHUSETTS

ASSESSORS MAPS

SEE MAP 25

L 10 M 25

L 7A M 12

L 7B M 12

L 8 M 25

3
36 AC-S

SEE MAP 12

L 5 M 25

2
465 AC-S

L 35 M 12

1

ROW TO 24-2

UPPER NAUKEAG LAKE

8
37 Ac ±

L 1F M 31

L 1E M 31

L 1D M31

L 1C M 31

L 1B M31

L 1A M31

L 1 M 31

SEE MAP 31

LINCOLN POND

5
11 AC-S

15
49 91 Ac

7
1 8 AC

13
2 9 AC

14
43 AC

4
7 AC-S

L 11 M 23

L 2 M 23

L 33 M 23

L 34 M 23

| | | | | |
|---|---|---|---|---|
| 11 | 25 | 30 | | |
| 12 | 24 | 31 | L 10 M 23 | |
| 13 | 23 | 32 | | |

STOWELL RD

| | | |
|---|---|---|
| 1986 | | |
| REV. BY | AVIS | 1979 |
| LAST Nº USED: | | 27 |
| ORIGINAL ISSUE: | | 1972 |

NUMBER NOT USED: 6

**MAP 24**

PREPARED UNDER THE DIRECTION OF THE
ASHBURNHAM BOARD OF ASSESSORS
BY
AVIS AIRMAP, INC
*BROOKLINE - BRAINTREE - HARTFORD*

200 0 200 400 600 FEET

Revised To X 1 1993

1/1/06

# ASHBURNHAM, MASSACHUSETTS

ASSESSORS MAPS

SEE MAP 56

SCALE 1"=100'

SCALE 1"=200'

RD

PVT RD DIRT

BROOK

HILLTOP

PVT RD DIRT RD.

SEE MAP 11

DR

SEE MAP 26

LIC M 26

11
3 AC

4
3.8AC

3
42.9 AC

1A
46± Ac

RD

2B
60033

2A
60078

1B
6.57Ac

2
60261

12
4.80A

1
1.57A

SLED ROAD

DIRT RD

HARRIS

9
2.3AC-S

7
3.65Ac

7A
2.10Ac

7B
2.26Ac

10A
5 AC

10C
5.59Ac

10
4.88Ac

10B
1.41 Ac

8
124AC-S

MUD POND

6
65AC

5
53.43 AC-S

OLD PIERCE RD

STOWELL

SEE MAP 30

13
1.495 Ac

M30-P16

M30-P15

M30-P14

M30-P13

L 1
M 30

L 8
M 24

L 8A
M 24

| | | |
|---|---|---|
| 56 | 26 | 29 |
| 11 | 25 | 30 |
| 12 | 24 | 31 |

Revised To January 1, 1988 Split

1/1/06

SEE MAP 25

200 0 200 400 800 FEET

| | | |
|---|---|---|
| REV. BY | AVIS | 1981 |
| REV. BY | AVIS | 1980 |
| LAST Nº USED: | | 11 |
| ORIGINAL ISSUE: | | 1972 |

MAP 25

PREPARED UNDER THE DIRECTION OF THE
ASHBURNHAM BOARD OF ASSESSORS
BY

AVIS AIRMAP, INC

*BROOKLINE — BRAINTREE — HARTFORD*

# ASHBURNHAM, MASSACHUSETTS

ASSESSORS MAPS

SEE MAP 27

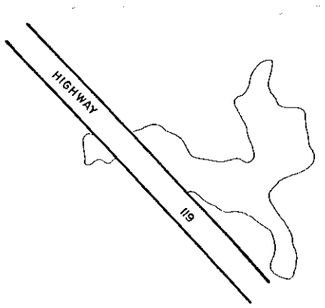


SEE MAP 9

FERRIN

4
19.6AC-S

3C
2.7AC

38
3.9AC

3A
4.6AC

3
3.4AC

L12
M9

2
3.2AC

54
2.3AC

53
2.3AC

52
3AC

L1
M27

DIRT RT
GRADED
FAIR COND.

5B
2.8Ac±

5A
3.0Ac

OLD

STEARNS

5
39.18Ac

6
554 AC

SHORE DR

1B
2 AC

L4

PVT. DIRT RD

928±

51A
16.4 AC

51B
17.5 AC

51D
10.75Ac

51E
2.05Ac

51C
11.2 AC

RD

SEE MAP 29

44
16500

43
12500

1D
12500

1A
2.32 AC

SEE MAP 57

LAKEHAVEN

37
12500

36
12875

35
12500

34
12500

33
12500

25000

31

23
25500

28
12500

SCALE 1"=100'
SCALE 1"=200'

1
11.03Ac±

1C
7.00 AC

57
6.2 AC-S
5.3 AC-P

56
5.9-P
7.5-S

L1A-M25

55
4 AC

PIERCE

3700-S

SEE MAP 25

SCALE 1"=200'

200 0 200 400 500 FEET

REPARED UNDER THE DIRECTION OF THE
ASHBURNHAM BOARD OF ASSESSORS
BY
AVIS AIRMAP, INC.
*BROOKLINE – BRAINTREE – HARTFORD*

| | | |
|---|---|---|
| REV. BY | *AVIS* | *1981* |
| REV. BY | *AVIS* | *1980* |
| REV. BY | *AVIS* | *1979* |
| REV. BY | *AVIS* | *1975* |
| REV. BY | *AVIS* | *1974* |
| LAST Nº USED: | | *57* |
| ORIGINAL ISSUE: | | *1972* |

Revised To January 1, 1981

LOT Nº NOT USED- 7-27, 38-42, 45-50

| | | |
|---|---|---|
| 9 | 27 | 28 |
| 57 | 26 | 29 |

**MAP 26**

*1/1/06*

# ASHBURNHAM, MASSACHUSETTS

ASSESSORS MAPS

R I N D G E

N E W I P S W I C H

NEW HAMPSHIRE

MASSACHUSETTS

4
1.5 AC

2
36.5Ac

1
155 AC

5
329.1 AC

L 6
M 26

L 6
M 26

L 4 M 26

SEE MAP 8

SEE MAP 28

STEARNS RD

ABANDONED

HIGHWAY 119

WALLACE POND

SCALE 1" = 200'

200 0 200 400 600 FEET

PREPARED UNDER THE DIRECTION OF THE
ASHBURNHAM BOARD OF ASSESSORS
BY
AVIS AIRMAP, INC.
*BROOKLINE – BRAINTREE – HARTFORD*

Revised To: X 1/1/06
January 1, 1969 / 1976

| | |
|---|---|
| REV. BY | |
| LAST Nº USED: | 5 |
| ORIGINAL ISSUE: | 1972 |

MAP 27 1/1/06

# ASHBURNHAM, MASSACHUSETTS

ASSESSORS MAPS

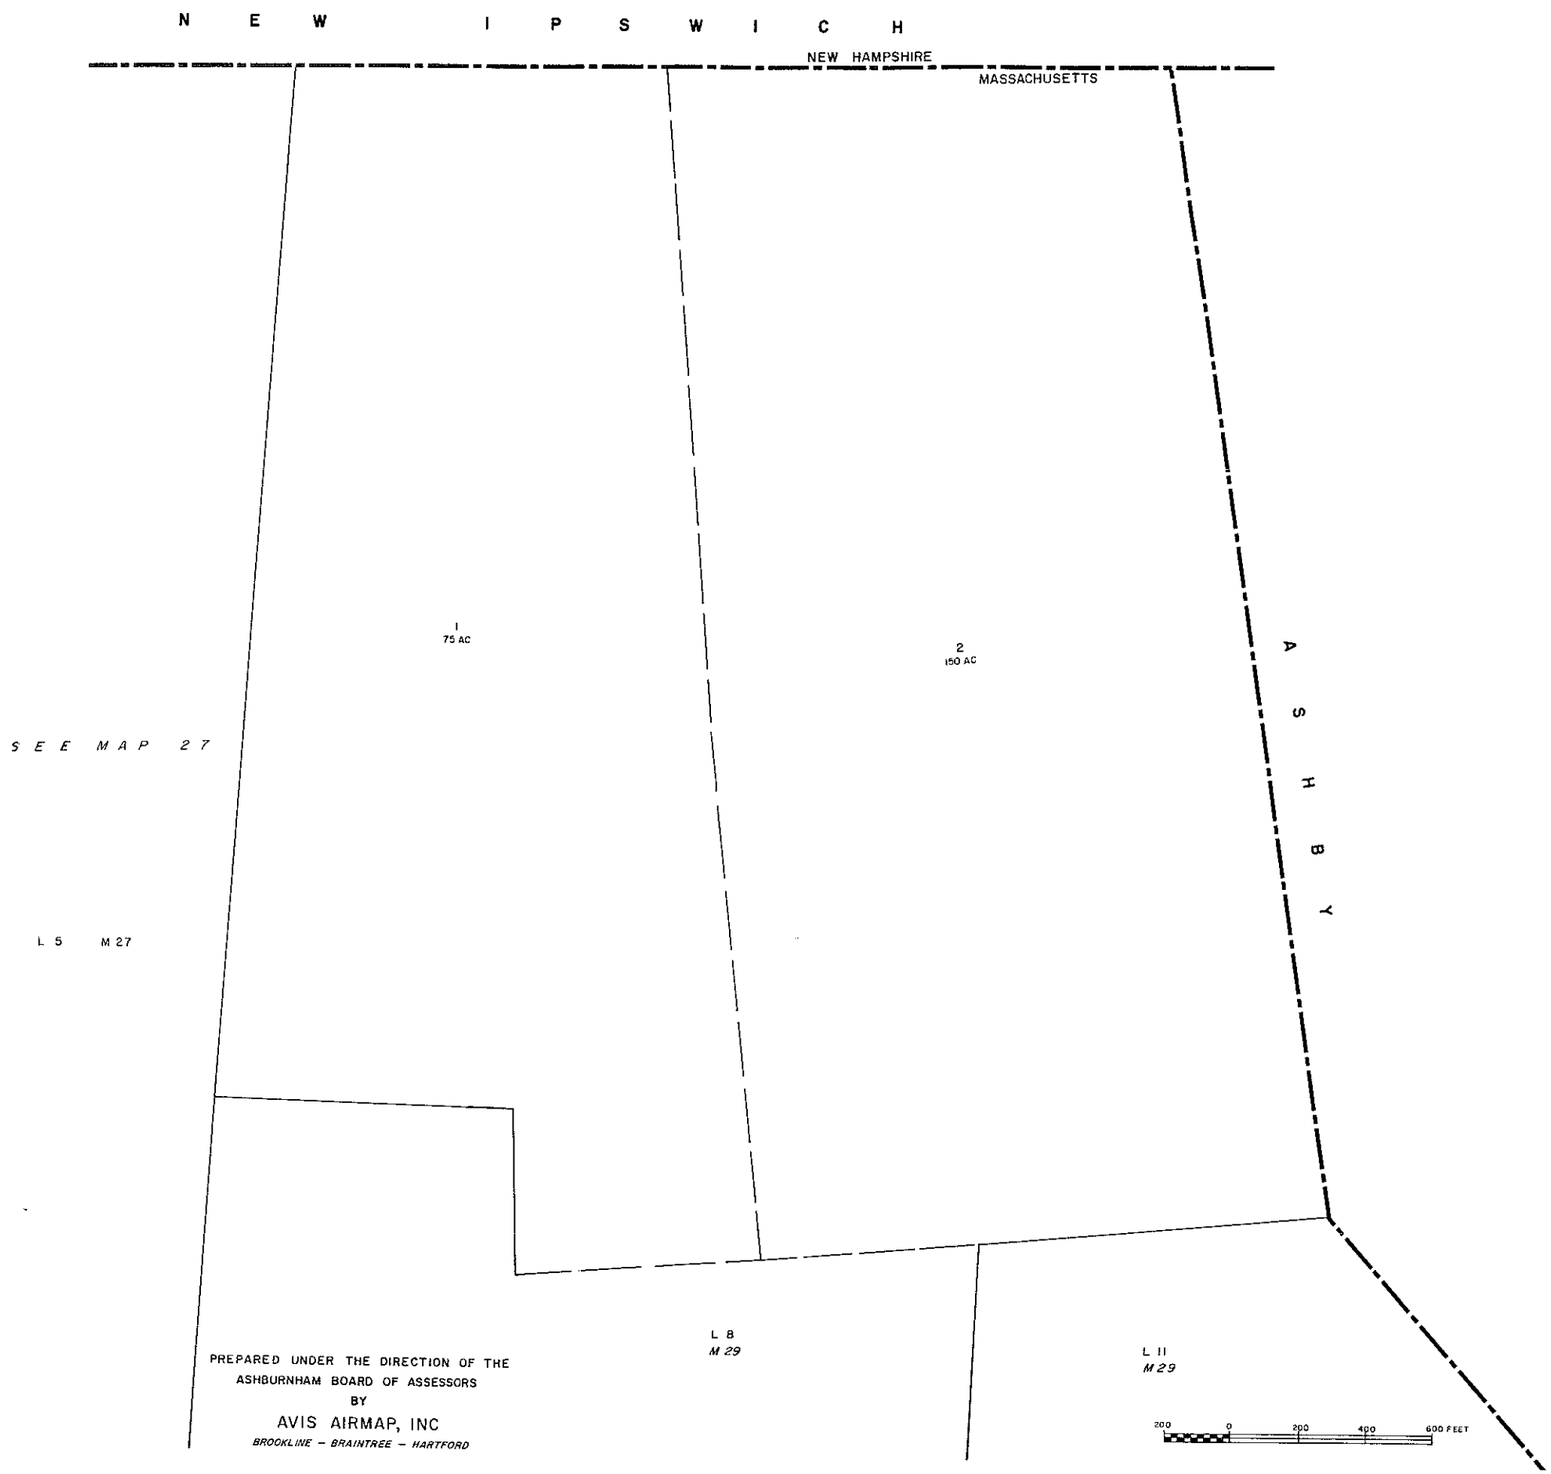


PREPARED UNDER THE DIRECTION OF THE
ASHBURNHAM BOARD OF ASSESSORS
BY
AVIS AIRMAP, INC
*BROOKLINE – BRAINTREE – HARTFORD*

| | | |
|---|---|---|
| REV. BY | | |
| LAST Nº USED: | 2 | |
| ORIGINAL ISSUE: | 1972 | |

27 | 28

**MAP 28**

1/1/06

# ASHBURNHAM, MASSACHUSETTS

ASSESSORS MAPS

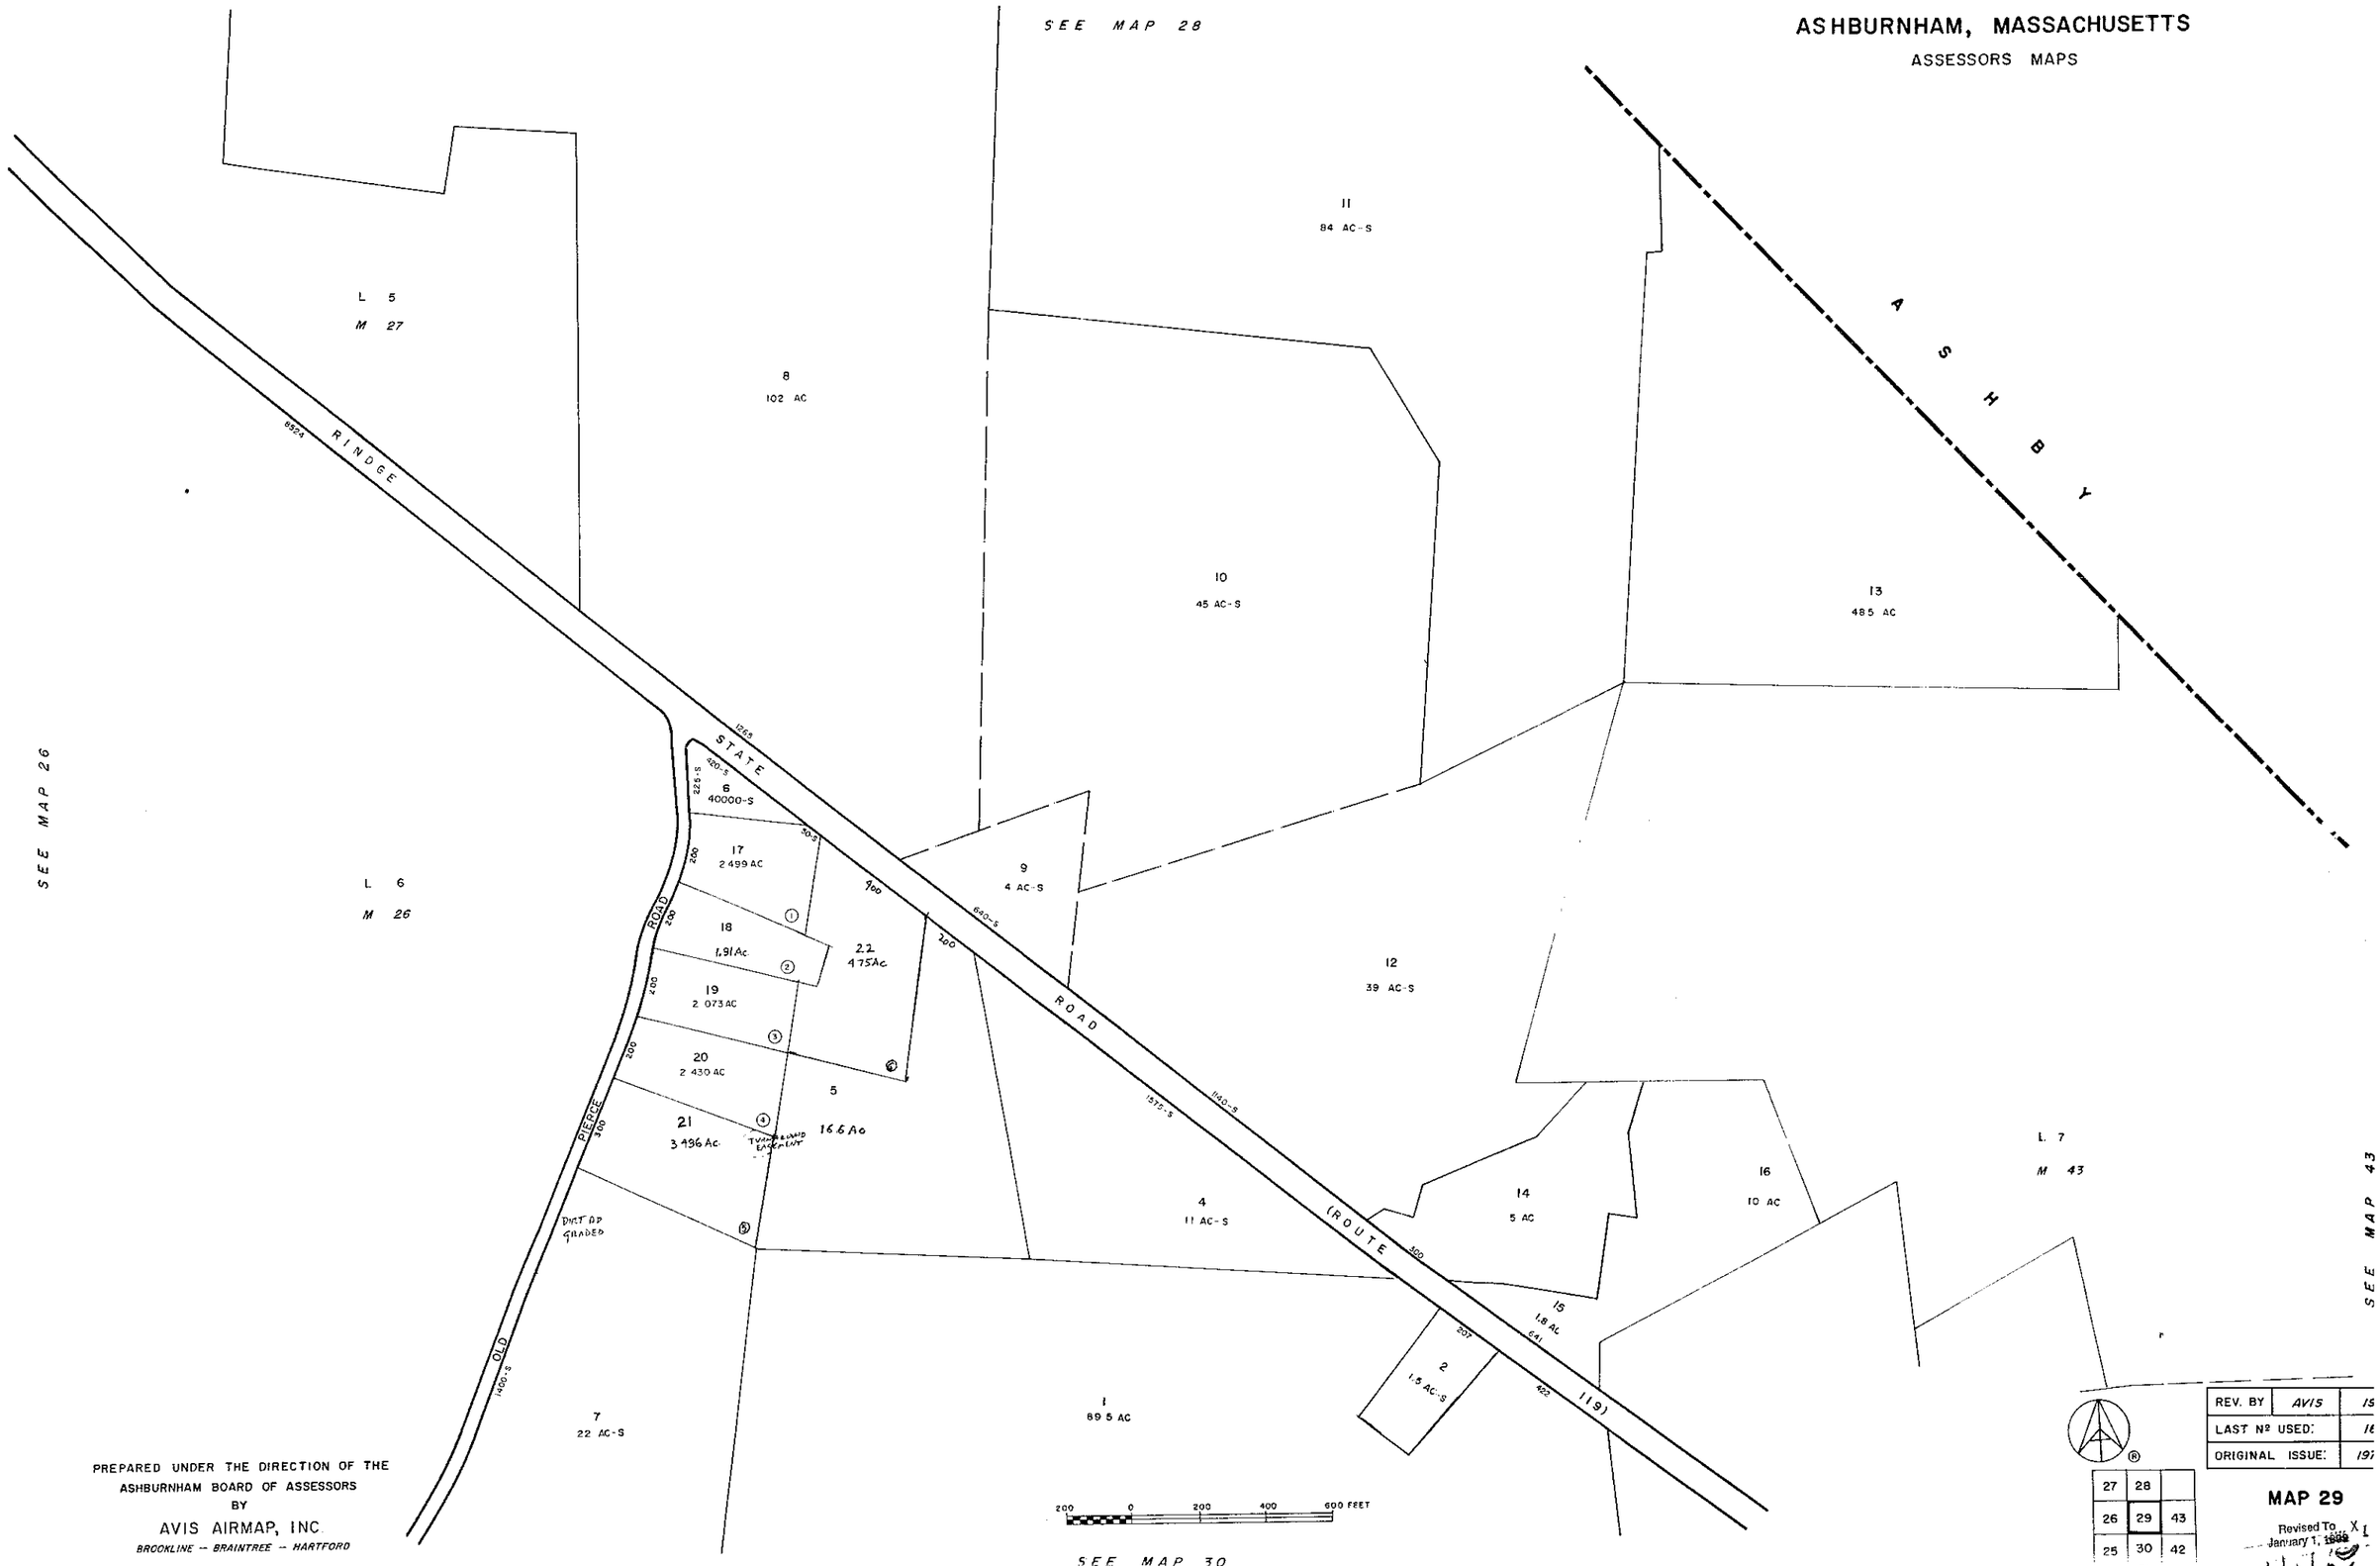


PREPARED UNDER THE DIRECTION OF THE
ASHBURNHAM BOARD OF ASSESSORS
BY
AVIS AIRMAP, INC
*BROOKLINE -- BRAINTREE -- HARTFORD*

| | | |
|---|---|---|
| 27 | 28 | |
| 26 | 29 | 43 |
| 25 | 30 | 42 |

| | | |
|---|---|---|
| REV. BY | AVIS | IS |
| LAST Nº USED: | | 16 |
| ORIGINAL ISSUE: | | 197 |

**MAP 29**

Revised To January 1, 1988

1/1/06

# ASHBURNHAM, MASSACHUSETTS

ASSESSORS MAPS

L6 M26

L7 M29

L1 M29

OLD STEELE RD 4050-S 3360-S 1300-S

DIRT RD POOR CONDITION

STOWELL 3100-S 3050-S

DIRT RD GRADED

L5 M25

2 210 AC

9 60 AC-S

3 13 AC-S

4A 26.89 AC

4 26.89 AC

5 62 AC-S

16 3.20Ac

15 3.11 Ac

14 3.10Ac

13 3.92Ac

12 1.58AC

1 2.05Ac

M25 P13

L8 M24

M31-P3 2.5830

L16 M31

SEE MAP 31

PREPARED UNDER THE DIRECTION OF THE ASHBURNHAM BOARD OF ASSESSORS BY AVIS AIRMAP, INC BROOKLINE – BRAINTREE – HARTFORD

200 0 200 400 600 FEET

| | | |
|---|---|---|
| 1986 | | |
| REV. BY | AVIS | 1981 |
| REV. BY | AVIS | 1980 |
| REV. BY | AVIS | 1975 |
| LAST Nº USED: | | 10 |
| ORIGINAL ISSUE: | | 1972 |

**MAP 30**

SEE MAP 43

RINDGE STATE ROAD (RT 119) 200 257 310 510 356 272 217 202 202 308

7D 4.28Ac

7C 8.27Ac

7A 44.55Ac

7 12.1 Ac

22 3.52Ac

21 74743

20 68668

1.093Ac

17 82909

23 2.868Ac

M42-P2.B

M42-P2C

M42-P2F

M42-P1F

M42-P1E

L 1B M 42

11 1.58AC

L1A M42

10 67754

6 11268

ASHBY RD 239 143 902-S

SEE MAP 70

Revised To January 1 1970

26 29 43

25 30 42

1" = 70'

1/1/06

# ASHBURNHAM, MASSACHUSETTS

ASSESSORS MAPS

SEE MAP 30

SEE MAP 70

SEE MAP 24

SEE MAP 41

SEE MAP 67

SEE MAP 66

SEE MAP 65

M41
P17

3
2.5890

28A
3.50 Ac

2
2 AC

2A
3 5AC

28
38.97 Ac

28B
5.66 Ac

1F
10.8AC

1G
2.0 AC

1E
10.75 AC

6J
60000

1D
10.85 AC

1C
10.9 AC

1B
10.88 AC

1A
10.8 AC

1
9.0 AC

5
6.6 AC

6K
20012

6D
1.45 AC

31
7 AC

6C
1.68 AC

6B
1.47 AC

6H
1.575 AC

6A
1.54 AC

6G
1.658 AC

35
2.50 AC

32
2.5 AC

6
99 AC-S

6F
60199

6E
1.474 AC

33
2.3 AC

34
3 AC

8
4 AC

9
1.1 AC

10
2.5 AC-S

16
130.93 Ac

15
9.8 AC

14
11.4 AC

29
11.4 AC

4
5 Ac

36
25 AC

13
10 AC

12
11 AC

23
4.5 AC

37
1.91 Ac

21
20.5 AC

18
8.5 AC-S

19
13.3 AC

17
19200 S

22A
1.5 AC

22F
4.19 Ac

22D
3.7 AC

25C
5.22 Ac

26
3 AC

25A
2.12 Ac

25B
2.01 Ac

25
2.53 Ac

22
68.3 Ac ±

22C
1.71 AC

22B
1.85 AC

30A
1.37 AC

30
29620

7
1.4 AC

24
30000

22E
2.0 AC

27C
2.934 Ac

27B
2.541 Ac

27A
3.37 Ac

ROUTE 101

ASHBY ROAD

OLD ASHBY ROAD

OLD STEELE RD

STOWELL ROAD

WINNECOWETT DRIVE

HOLT ROAD

HAYDEN ROW

N.O.W.

L 5B
M 32

SCALE 1"=200'

SCALE 1"= 100'

SCALE 1"= 200

200 0 200 400 600 FEET

PREPARED UNDER THE DIRECTION OF THE
ASHBURNHAM BOARD OF ASSESSORS
BY
AVIS AIRMAP, INC.
*BROOKLINE – BRAINTREE – HARTFORD*

| | | |
|---|---|---|
| REV BY | AVIS | 1981 |
| REV BY | AVIS | 1980 |
| REV. BY | AVIS | 1975 |
| REV. BY | AVIS | 1974 |
| REV. BY | AVIS | 1986 |
| ORIGINAL ISSUE: | | 1972 |

LAST NUMBER USED: 36
NUMBER NOT USED: 29

**MAP 31**

~~Revised To JAN X 1 19~~
~~January 1 1993~~
1/1/06

| | | |
|---|---|---|
| 25 | 30 | 70 |
| 24 | 31 | 41 |
| 32 | 65 | 67 |

# ASHBURNHAM, MASSACHUSETTS

ASSESSORS MAPS

PREPARED UNDER THE DIRECTION OF THE
ASHBURNHAM BOARD OF ASSESSORS
BY
AVIS AIRMAP, INC
*BROOKLINE – BRAINTREE – HARTFORD*

SCALE 1"= 100'
SCALE 1"= 200'

| | | |
|---|---|---|
| 1986 | | |
| REV. BY | AVIS | 1980 |
| REV. BY | AVIS | 1975 |
| LAST Nº USED: | | 26 |
| ORIGINAL ISSUE: | | 1972 |

**MAP 32**

SEE MAP 31
SEE MAP 65
SEE MAP 66
SEE MAP 68
SEE MAP 64
SEE MAP 33
SEE MAP 40

WINNECOWETT DR
MASSASOIT DR
PVT
DIRT RD. GRADED
STOWELL
PINE TRAIL
ROW
WINNEKEAG
LAKE
ROUTE 101
ASHBY RD
STODGE MEADOW POND
House
MUST SHEAR BE NEARLY 90°
L2-M33
L 10
M 33
L 2B
M 40
M 40

5A 6.6AC
5 3.2AC
5B 4.7AC
5C 53600
5D 54000
6 1.7AC
7 25.4AC-S
7A 1.55A
8 4AC-S
9 12AC-S
10 7.8 AC
10A 7.7 AC
11 23.94 Ac
12 32400
13 1.4AC
14 28984
15 16400
16 2.6AC
17 53 AC
18 1.3AC
19 71860
20 64230
21 71 AC-S
22 24AC-S 4.0AC-D
23 9.1 AC-S 1.6 AC-D
24 3.1 AC-S
25 3 AC-S
26 2.4AC-S
1 4 AC
2 13AC-S
3 10AC

200 0 200 400 600 FEET

Revised to Jan. 1, 1986
X 1
L 3
M 40

1/1/06

# ASHBURNHAM, MASSACHUSETTS

ASSESSORS MAPS

SEE MAP 32

SEE MAP 22

SEE MAP 63

SEE MAP 39

L 17
M 32

L 3
M 40

L 1
M 34

L 6
M 34

L 10
M 34

L 11

L 29
M 39

L 28
M 39

| | | |
|---|---|---|
| 1986 | | |
| REV. BY | AVIS | 1980 |
| REV. BY | AVIS | 1978 |
| REV. BY | AVIS | 1974 |
| LAST Nº USED: | | 43 |
| ORIGINAL ISSUE: | | 1972 |

MAP 33

| | | |
|---|---|---|
| 23 | 32 | 40 |
| 22 | 33 | 39 |
| 21 | 34 | 38 |

1/1/06

Revised To January 1, 1998

PREPARED UNDER THE DIRECTION OF THE ASHBURNHAM BOARD OF ASSESSORS BY

AVIS AIRMAP, INC

*BROOKLINE - BRAINTREE - HARTFORD*

200 0 200 400 600 FEET

# ASHBURNHAM, MASSACHUSETTS

ASSESSORS MAPS

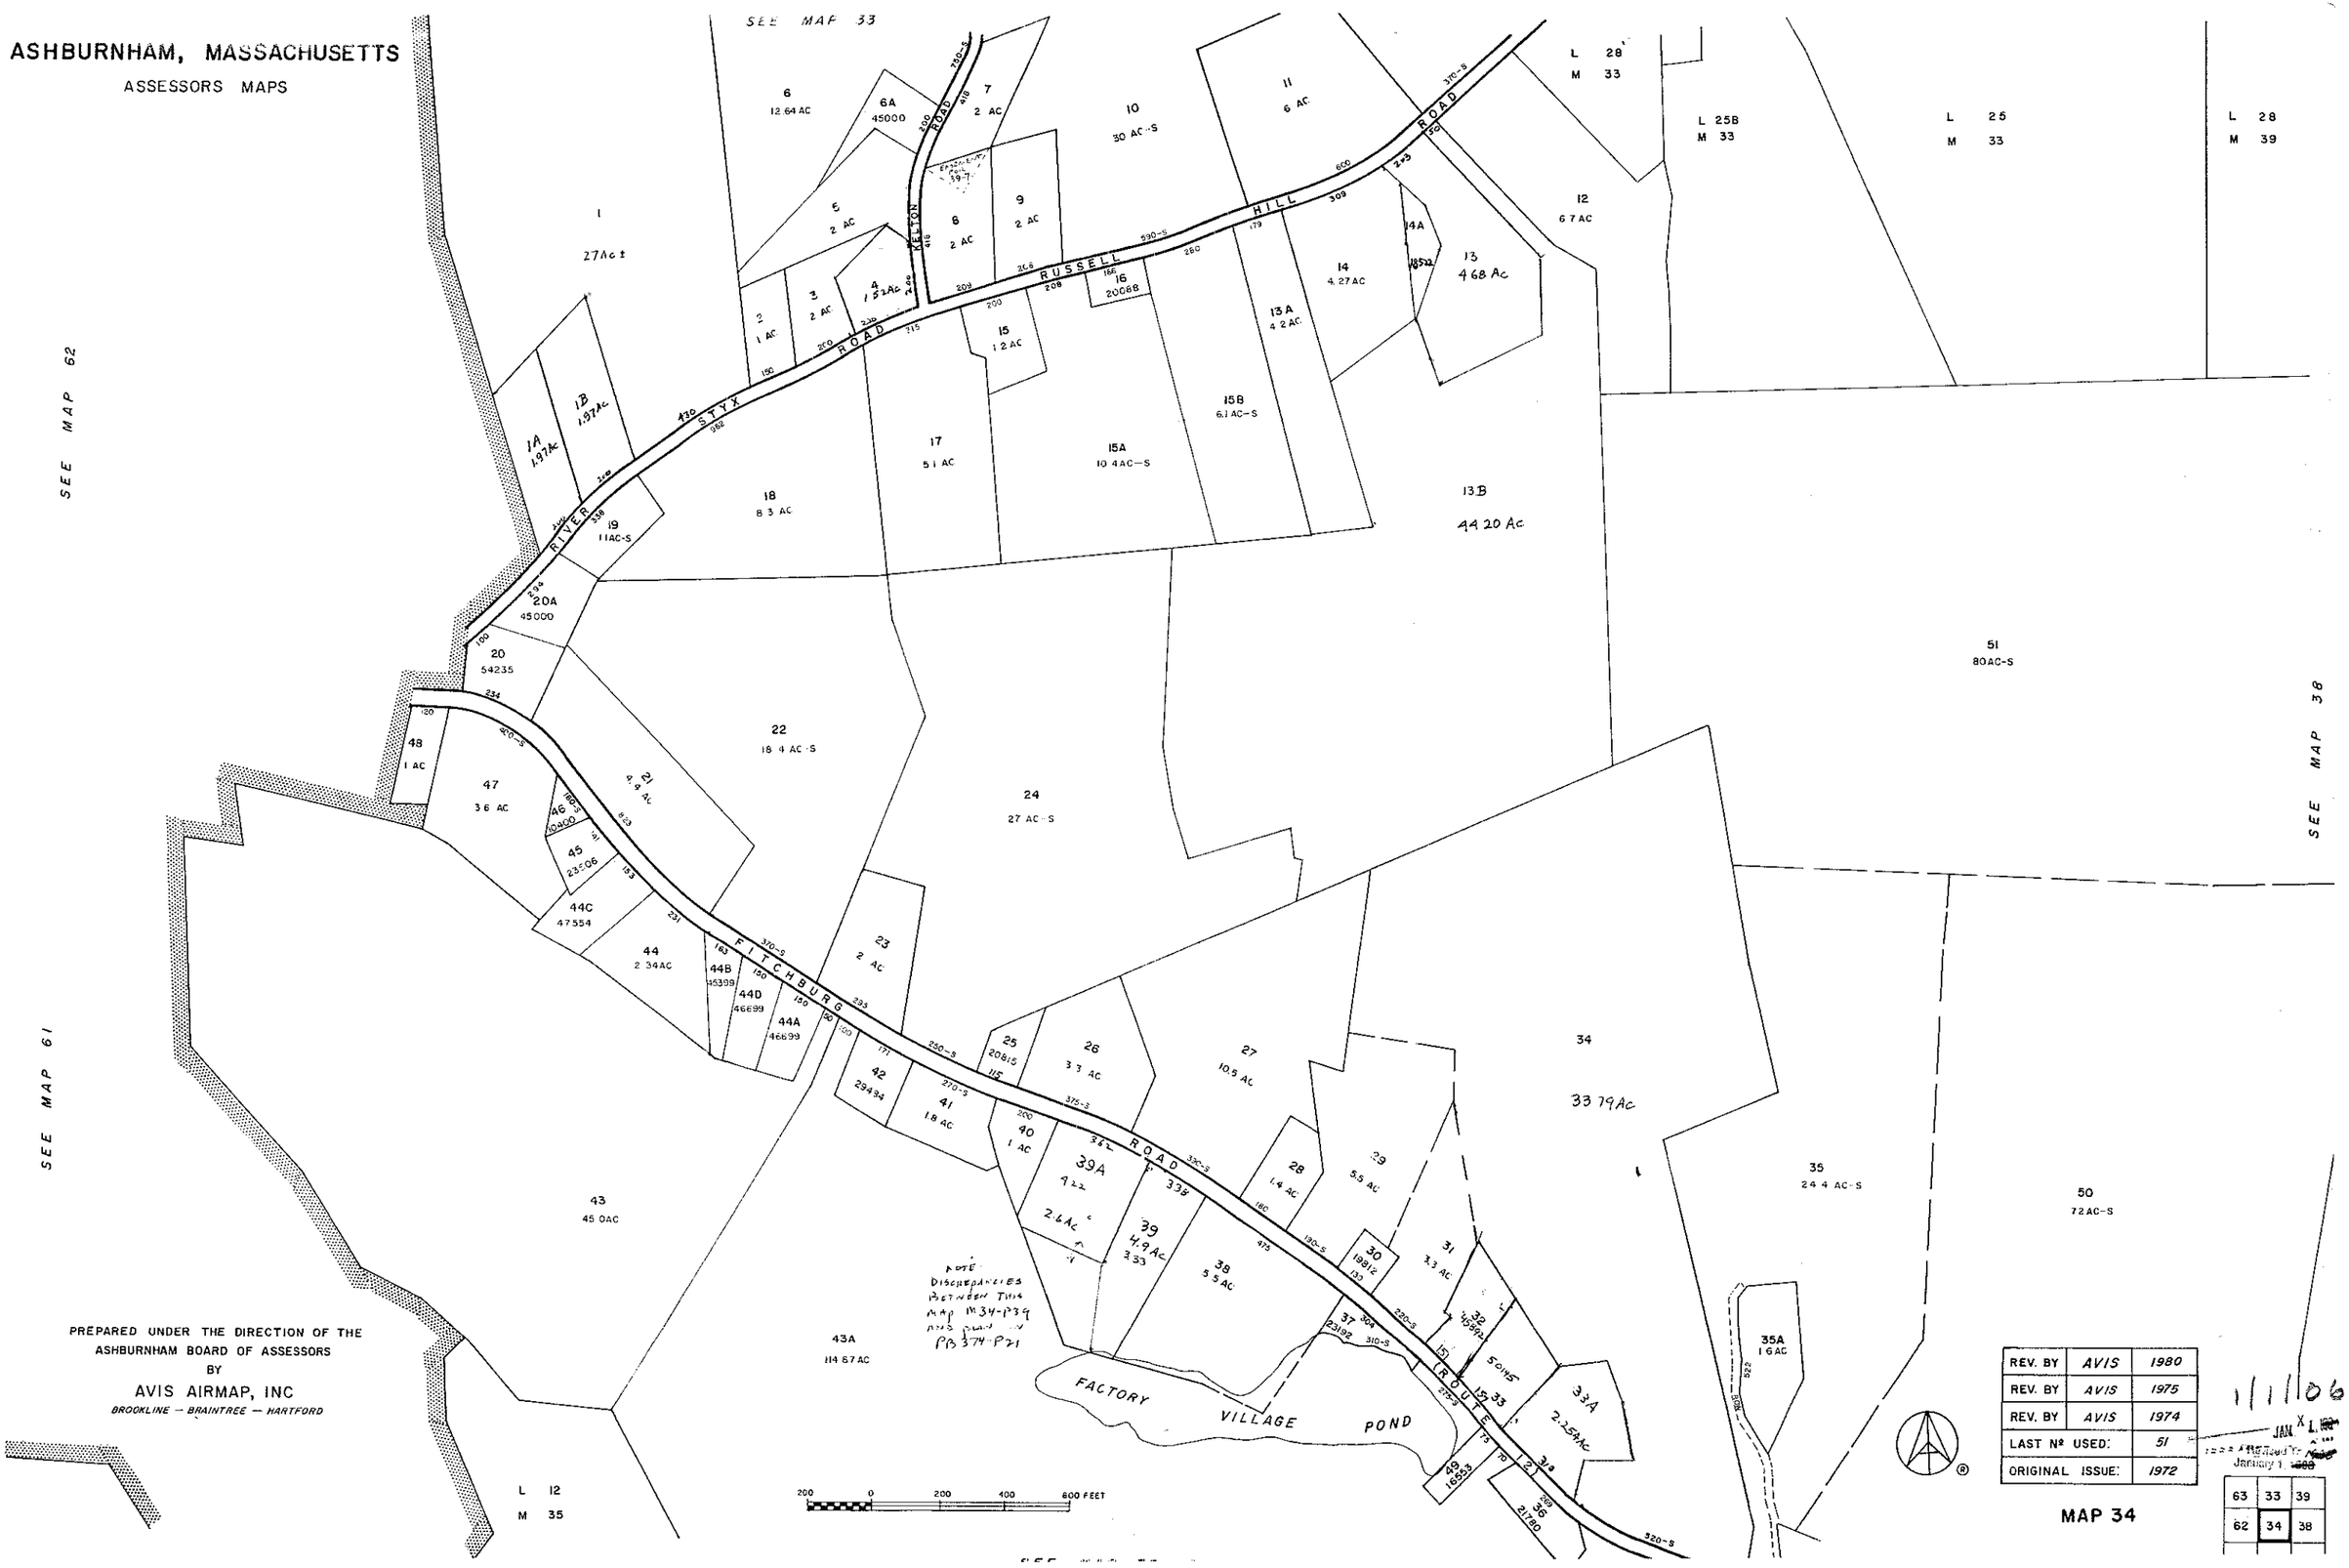


PREPARED UNDER THE DIRECTION OF THE
ASHBURNHAM BOARD OF ASSESSORS
BY
AVIS AIRMAP, INC
*BROOKLINE — BRAINTREE — HARTFORD*

| | | |
|---|---|---|
| REV. BY | AVIS | 1980 |
| REV. BY | AVIS | 1975 |
| REV. BY | AVIS | 1974 |
| LAST Nº USED: | | 51 |
| ORIGINAL ISSUE: | | 1972 |

**MAP 34**

1/1/06

| | | |
|---|---|---|
| 63 | 33 | 39 |
| 62 | 34 | 38 |

# ASHBURNHAM, MASSACHUSETTS

ASSESSORS MAPS

L 43A
M 34

SEE MAP 34

SEE MAP 20

SEE MAP 37

L 32
M 20
SEE M20-P100

L 33
M 20

L 43A
M 34

L 50
M 34

L 35 M34

L 2
M 37

L 1
M 36

8
28.5 AC-S

12
28 Ac ±

12A
10.36 Ac

12B
5.03 Ac

13
87.5 AC

16
8.3 AC

17
340
29678

18
36093

18A
14400-S

19
38800-S

21
80574

22
9.6 AC-S

7A
31000

7
2.9 AC

8A
2.097AC

9
$2187

10
2.41 Ac

11
2 AC-S

6
1.3 AC

9A
1975

5A
5.6 AC

4A
1.5 AC

4B
1.5 AC

4
50 AC-S

3A
45137

3

20.88 Ac

1A
1.5 AC-S

1B
1.5 AC-S
1.962 Ac

1C
5.0 AC-S
4.634c

1D
4.89

14
23 AC

14A
45114

23
1 AC

15
60 AC

1
84.84

5
86.4 AC-S

2
33.53 Ac

FITCHBURG ROAD (ROUTE 12)

WILLARD ROAD

WHITNEY ROAD

HILL ROAD

DISCONTINUED DIRT RD V POOR COND.

200 0 200 400 600 FEET

| | | |
|---|---|---|
| REV. BY | AVIS | 1981 |
| REV. BY | AVIS | 1975 |
| REV. BY | AVIS | 1974 |
| LAST Nº USED: | | 23 |
| ORIGINAL ISSUE: | | 1972 |

| | | |
|---|---|---|
| 61 | 34 | 38 |
| 20 | 35 | 37 |

MAP 35

Revised To January 1, 1981

WESTMINSTER 1/1/06

PREPARED UNDER THE DIRECTION OF THE
ASHBURNHAM BOARD OF ASSESSORS
BY
AVIS AIRMAP, INC
*BROOKLINE - BRAINTREE - HARTFORD*

# ASHBURNHAM, MASSACHUSETTS

ASSESSORS MAPS

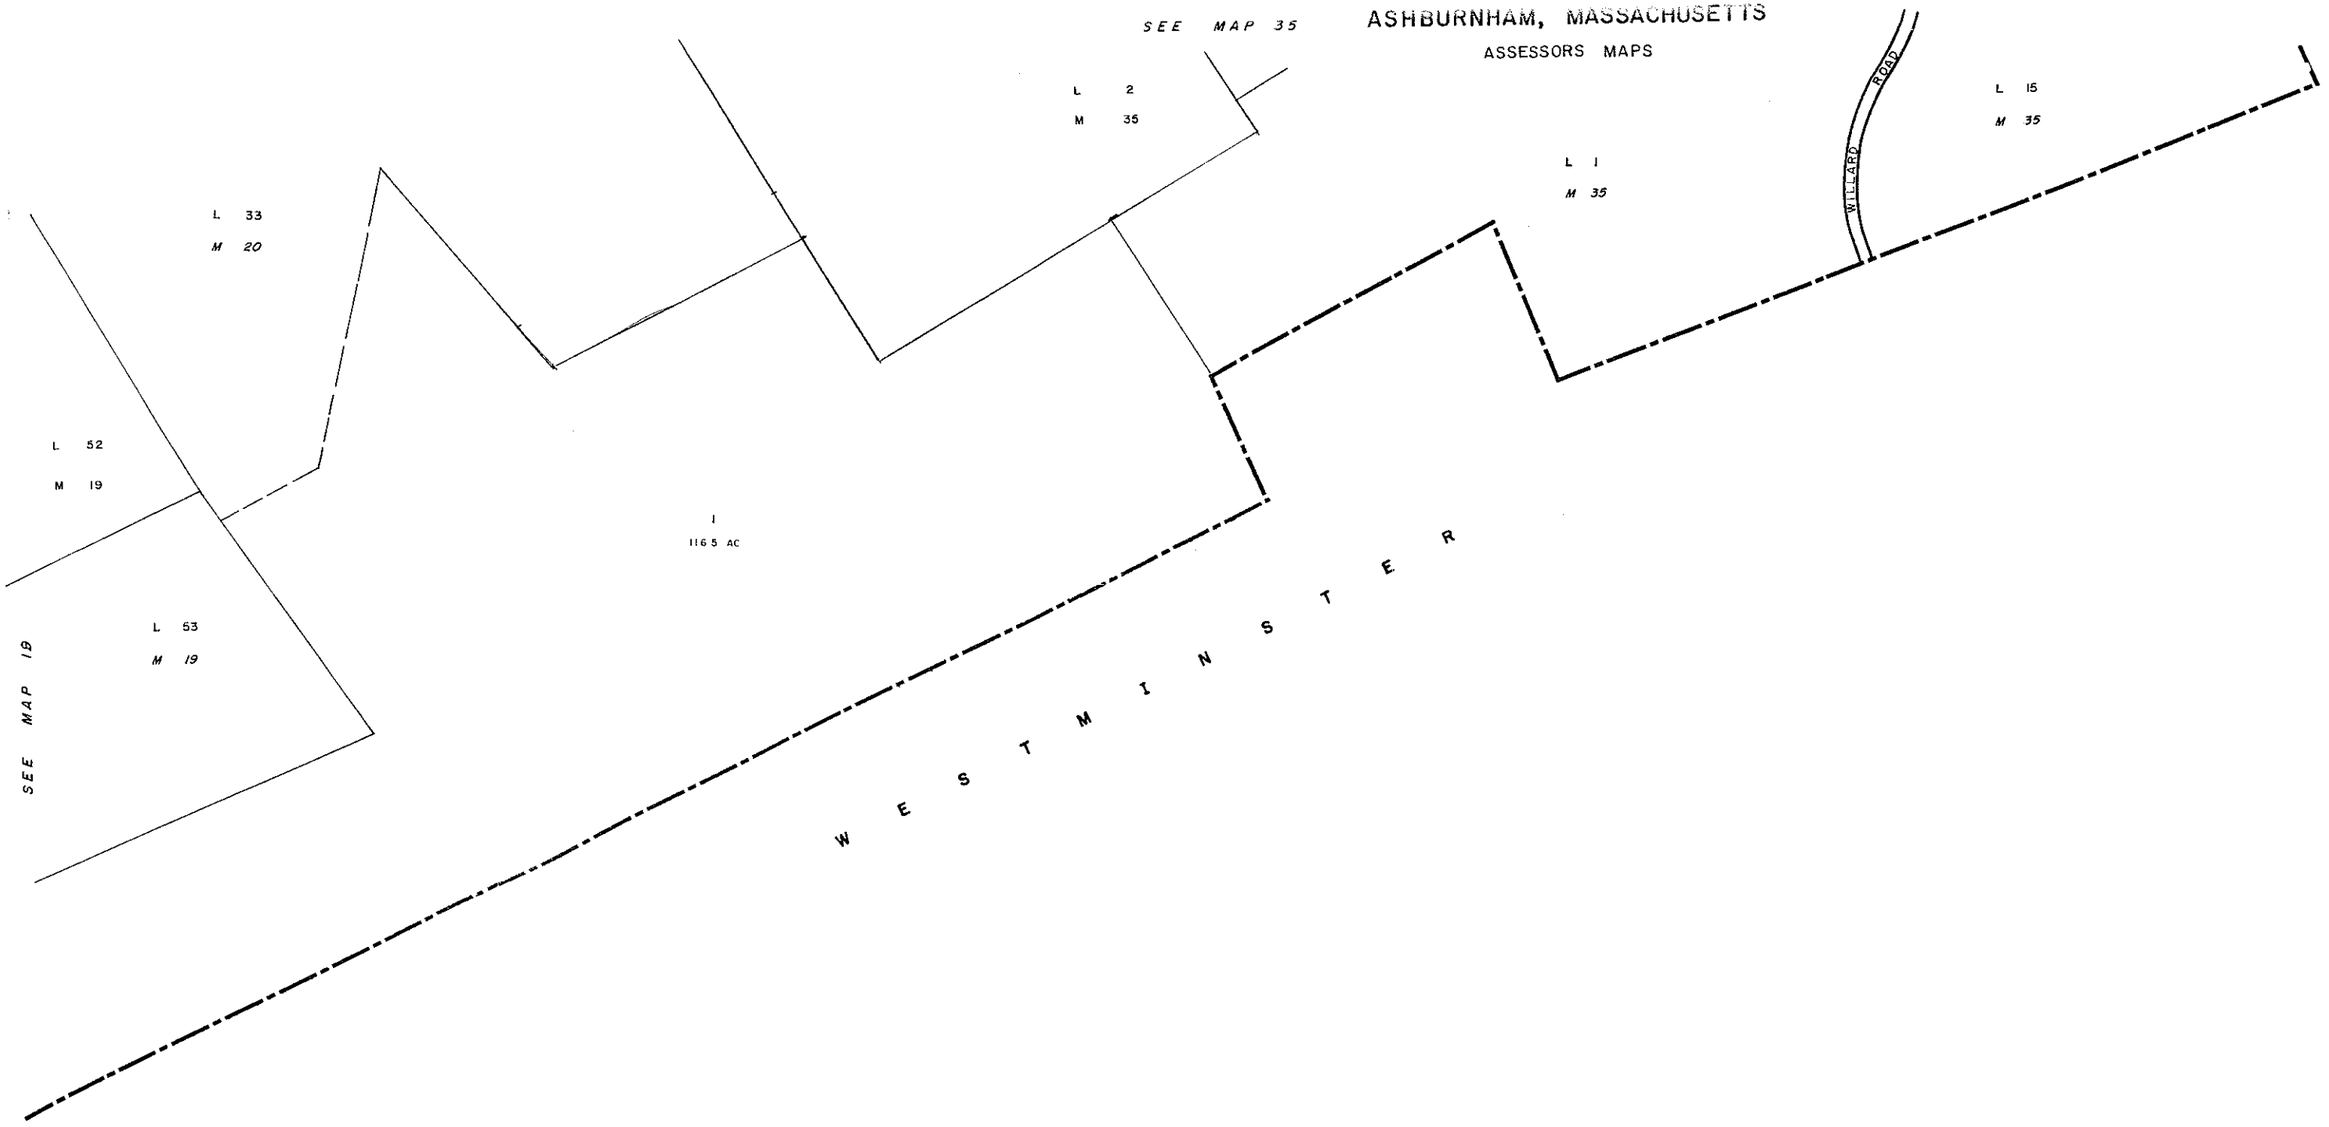


PREPARED UNDER THE DIRECTION OF THE
ASSESSORS BOARD OF ASSESSORS
BY
AVIS AIRMAP, INC
*BROOKLINE — BRAINTREE — HARTFORD*

200 0 200 400 600 FEET

| | | |
|---|---|---|
| 20 | 35 | 37 |
| 19 | 36 | |

1/1/06

~~Revised To January 1, 1966~~ X 1-1988

| | | |
|---|---|---|
| REV. BY | AVIS | 1975 |
| LAST Nº USED: | | 1 |
| ORIGINAL ISSUE: | | 1972 |

**MAP 36**

# ASHBURNHAM, MASSACHUSETTS

ASSESSORS MAPS

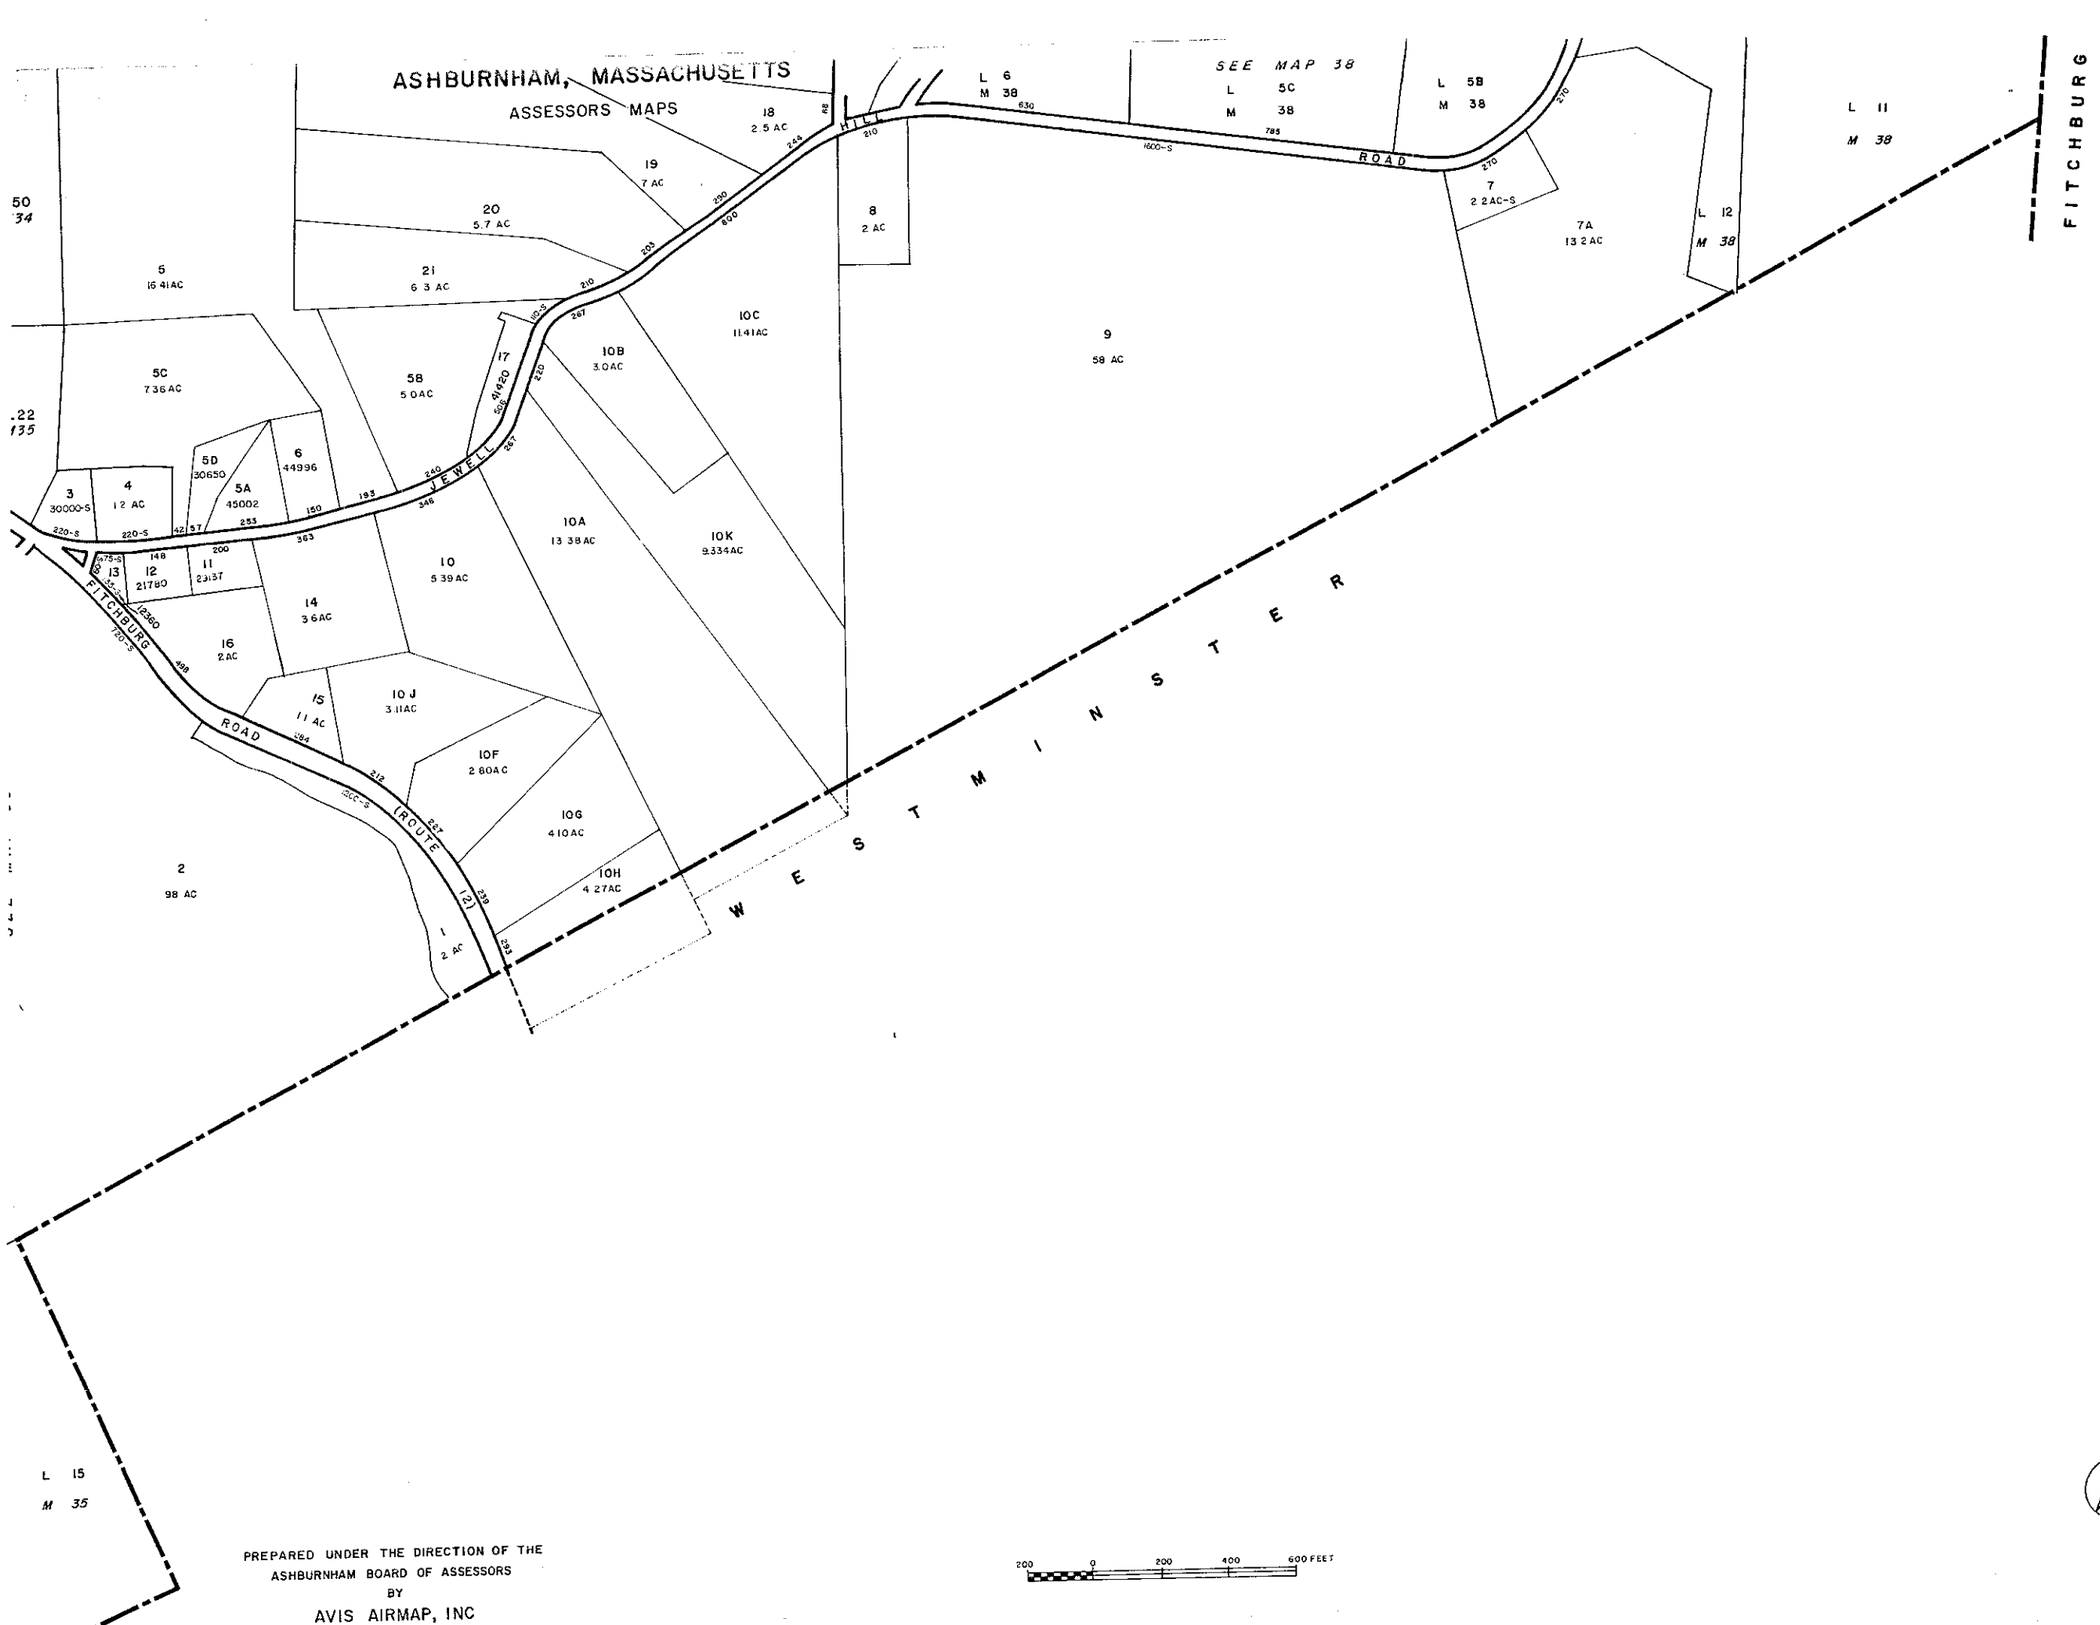


PREPARED UNDER THE DIRECTION OF THE
ASHBURNHAM BOARD OF ASSESSORS
BY
AVIS AIRMAP, INC
BROOKLINE – BRAINTREE – HARTFORD

200 0 200 400 600 FEET

| | | |
|---|---|---|
| REV. BY | AVIS | 1981 |
| REV. BY | AVIS | 1974 |
| LAST Nº USED: | | 21 |
| ORIGINAL ISSUE: | | 1972 |

| | | |
|---|---|---|
| 34 | 38 | |
| 35 | 37 | |
| 36 | | |

MAP 37
Revised 1981
January 1, 1974
1/1/05

# ASHBURNHAM, MASSACHUSETTS

ASSESSORS MAPS

SEE MAP 39

L 26
M 39

3
12.3 Ac

L 20
M 39

L 28
M 39

L 24
M 39

L 22
M 39

L51
M34

2A
41.8 AC

2
53.3 AC

9
96 AC S

ASHBY

SEE MAP 34

2B
4.75 AC

2C
18 AC-S

1
7.4 AC

17
7.7 AC

18
7.8 AC

19
7.6 AC

20
9 AC

21
18.77 Ac

5D
19.13 Ac

5
14.12 Ac

L50
M34

14
Goold

14A

14C
2.76 Ac

15
5.1 AC

22A
1.5 AC

5A
17.7 AC

7
20.74 AC-S

8
1.6 AC-S

10
10 AC-S

7A
3.76 AC

11
49.2 AC-S

23
5.2 AC

24
3.9 AC

25
2.5 AC

26
8.8 AC

27
10.1 AC

16
5 AC

28
5.4 AC

5C
2.5 AC-S

5B
9.5 AC

12
8.1 AC-S

6
3.3 AC-S

1 AC-S

KALLINEN ROAD

PVT DIRT

JEWELL HILL ROAD

ITCHBURG

200 0 200 400 600 FEET

L 5 M 37

L 19 M 37

L 18 M 37

PREPARED UNDER THE DIRECTION OF THE
ASHBURNHAM BOARD OF ASSESSORS
BY
AVIS AIRMAP, INC.
BROOKLINE – BRAINTREE – HARTFORD

| | | |
|---|---|---|
| REV. BY | AVIS | 1981 |
| REV. BY | AVIS | 1975 |
| REV. BY | AVIS | 1974 |
| LAST Nº USED: | | 28 |
| ORIGINAL ISSUE: | | 1972 |

NUMBER NOT USED: 13

| | | |
|---|---|---|
| 33 | 39 | |
| 34 | 38 | |

MAP 38 1/1/06

Revised January 1 1988

# ASHBURNHAM, MASSACHUSETTS

ASSESSORS MAPS

SEE MAP 40

L 3
M 40

L 18.B/D/E/g
M 33

MAP 33

L 19
M 33

L 22
M 33

2
227 AC-S
217.91

3
40 AC

14A
28.5 AC-S

14
43 AC-S

32
6.97 AC

33
2.0 Ac

33A
3.53 Ac

15
6.2 AC

16
40 AC-S

17
10.5 AC

13
6 AC

4
42 AC-S

PVT. DIRT

11A
14.4 Ac ±

11
5.00 Ac

12
6.1 AC

10
3.1 AC-S

31
42690

5
1.8 AC-S

7
2 AC

8
2 AC

18A
1.41 AC

18
C
9.29 Ac

18B
4.31 Ac

19
5.3 AC

20
62 AC-S

21
7.8 AC

22
51.13 Ac

2C
9.25 Ac

23
3.90 Ac

23A
5.07A

23B
43561

34
3.0 AC

24
3.575 Ac

25
4.3 AC

26
2.8 AC

27
2.8 AC-S

28
6.5 AC

28A
26.0 AC-S

29
5.3 AC-S

30
5.6 AC

35
2.93 AC

36
3.41 AC

1
13504

2A
2.78±
444

RUSSELL

WILKER ROAD

RIDGE TURNPIKE

HILL

ROAD

PREPARED UNDER THE DIRECTION OF THE
ASHBURNHAM BOARD OF ASSESSORS
BY
AVIS AIRMAP, INC

L 3 M 38

200 0 200 400 600 FEET

| REV. BY | AVIS | 1981 |
|---|---|---|
| REV. BY | AVIS | 1975 |
| LAST Nº USED: | | 31 |
| ORIGINAL ISSUE: | | 1972 |

NUMBER NOT USED: 6,9

MAP 39

Revised To 1/1/06

| | | |
|---|---|---|
| 32 | 40 | |
| 33 | 39 | |

# ASHBURNHAM, MASSACHUSETTS

## ASSESSORS MAPS

SEE MAP 41

L 23 M 41

L 22 M 41

L 21 M 41

L20 M41

L19 M41

SEE MAP 69

SCALE 1"=100'

SCALE 1"=200'

PART OF M68-P32

1
23.98Ac

8G
14.47 AC

8F
13.8 AC

8E
24.1 AC

8D
2.3 AC

8C
5.1 AC

8B
4.6 AC

8A
5.1 AC

8
8.4AC

9
4.9 AC

10
5.8 AC

L29
M41

8H
5.9 AC

DIRT

12
53Ac±

P.T.&T. EASEMENT

RINDGE

22
12.4 AC

21
26AC

23
12.9 AC

BYFIELD

13
3.5 AC

14
2.5 AC-S

DIRT ROAD

11
26.8 AC

16
2.5 AC

15
15 AC-S

ROAD

17
9.7AC

18
15 AC

17A
42078

TURNPIKE

6A
6.00AC

R.O.W.

6
21.5AC-S

5
10.3 AC-S

19
18 AC

20
6.4 AC

WILKER

4
10.3AC

L 15
M 39

L 33
M 39

STODGE MEADOW POND

SEE MAP 68

2A
6.94AC

2C
1.1Ac

2
9.22Ac

2B
8.73AC

SEE MAP 32

3
47 AC-S

L 2
M 39

7
20.76 AC

CH.61

EXCLUDED
19.7Ac

200 0 200 400 600 FEET

ASHBURNHAM BAY

PREPARED UNDER THE DIRECTION OF THE
ASHBURNHAM BOARD OF ASSESSORS
BY
AVIS AIRMAP, INC.
*BROOKLINE – BRAINTREE – HARTFORD*

| | | |
|---|---|---|
| | | AVIS 1981 |
| REV. BY | AVIS | 1975 |
| REV. BY | AVIS | 197 |
| LAST Nº USED: | | 23 |
| ORIGINAL ISSUE: | | 197 |

| | | |
|---|---|---|
| 69 | 41 | |
| 68 | 40 | |

**MAP 40**

Revised To January 1, 19

1/1/06

# ASHBURNHAM, MASSACHUSETTS

ASSESSORS MAPS

SEE MAP 42

SEE MAP 70

ASHBY ROAD 1550-S

OLD ASHBY 170

6
36.28 Ac

6A
2.9 AC-S

4
24000-S
160-S

27500
250

3
28000-S
2 AC

2A
17000
220

OLD MARBLE ROAD 300-S

MARBLE ROAD 1350-S 1100-S

17

2
29800
350

HOLT ROAD 1850-S 330-S

27A
M 31

350-S

ROW

L 7A
M 67

POND
(15AC-S)

MARBLE

ROW

L7A
M67

STODGE MEADOW POND

SEE MAP 69

16
20AC

17
LAND
112.17Ac INCL POND

14
48.36 Ac.

DILAPIDATED NOT MAINTAINED

1800-S 1700-S 2600-S

BYFIELD 1200-S 1000-S

RINDGE 1480-S

7
52Ac

7A
3.0 Ac

8
3.7 AC

9
70 AC-S

32
3.49 AC

13A
1.4 AC

13D

13C
5.02 AC

13B
2.6 AC

13G
4.86 AC

13F
3.36 AC

13E
2.37 AC

13H
354 Ac

13
69260

WAGES (PRIVATE) ROAD 337

12
7.4 AC

12B
3.8 AC

10A
2.01 AC

10B
2.25 AC

10C
2.64 Ac

ROAD 2350-S

11A
10.57 AC

11
2.845 AC

10
72.8 AC-S

A.T.&T. EASEMENT

DIRT ROAD (CONDITION)

TURNPIKE 2250-S

26
12.5 AC

24
12.6 AC

23
12.5 AC

22
13.1 AC

21
13 AC

20
16.1 AC

19
14.7 AC

26
23.7 AC

27
9.3 AC

31
5 AC

30
4.2 Ac

28
3.8 AC

29
3.8 AC

L 12
M 40

SEE MAP 40

SCALE 1"= 200'

200 0 200 400 600 FEET

| | | |
|---|---|---|
| REV. BY | AVIS | 1981 |
| REV. BY | AVIS | 1980 |
| REV. BY | AVIS | 1975 |
| REV. BY | AVIS | 1974 |
| LAST Nº USED: | | 32 |
| ORIGINAL ISSUE: | | 1972 |

NUMBER NOT USED: 1

MAP 41

| | | |
|---|---|---|
| 31 | 42 | |
| 67 | 41 | |
| 69 | 40 | |

MAP 41
Revised To JAN 1 1981
January 1, 1980

1/1/06

PREPARED UNDER THE DIRECTION OF THE
ASHBURNHAM BOARD OF ASSESSORS
BY
AVIS AIRMAP, INC.
BROOKLINE — BRAINTREE — HARTFORD

# ASHBURNHAM, MASSACHUSETTS

ASSESSORS MAPS

SEE MAP 43

RINGE STATE ROAD (ROUTE 119)

2L 3.560 Ac

2J 2.572 Ac

2A 3.50 Ac

2 8.357 Ac

3.063 Ac 2K

2G 2.86 Ac

2E 3.05 Ac

2B 8.94 Ac.

2C 5.60 Ac

2F 14.27 Ac

1 2.1 Ac

1D 2.52 Ac

1F 3.99 Ac.

1E 5.73 Ac

1B 2.01 AC

L 11 M 30

SEE MAP 30

ASHBY ROAD (ROUTE 101)

SEE MAP 71

WATATIC POND

BILLY WARD POND

SEE MAP 70

7 14 AC-S

4 22 AC-S

6A 2.75 Ac.

6 2.37 Ac

6B 2.31 Ac

5A 61.779

5 4.36 Ac

10 5 AC

RINGE ROAD

ASHBY ROAD

OLD TURNPIKE

11 77.3 AC

13 17.66 Ac

12 3.99 AC

DETERIORATED NOT MAINTAINED

BYFIELD ROAD

L 6 M 41

L 7 M 41

8 3.9 Ac E

8A 60.387

8B 85509

9 3.3 AC-S

11B 2.10 AC

11A 27.60 AC

ASHBY ROAD

200 0 200 400 600 FEET

SEE MAP 41

PREPARED UNDER THE DIRECTION OF THE
ASHBURNHAM BOARD OF ASSESSORS
BY
AVIS AIRMAP, INC
*BROOKLINE — BRAINTREE — HARTFORD*

| | | |
|---|---|---|
| REV. BY | AVIS | 1981 |
| REV. BY | AVIS | 1980 |
| REV. BY | AVIS | 1975 |
| LAST Nº USED: | | 12 |
| ORIGINAL ISSUE: | | 1972 |

LOT NO NOT USED: 3

| | | |
|---|---|---|
| 29 | 43 | |
| 30 | 42 | |
| 31 | 41 | |

**MAP 42**

Revised To January 1, 1982

1/1/06

# ASHBURNHAM, MASSACHUSETTS

ASSESSORS MAPS

PREPARED UNDER THE DIRECTION OF THE
ASHBURNHAM BOARD OF ASSESSORS
BY
AVIS AIRMAP, INC

| | | |
|---|---|---|
| REV. BY | AVIS | 1981 |
| REV. BY | AVIS | 1974 |
| LAST Nº USED: | | 12 |
| ORIGINAL ISSUE: | | 1972 |

| | | |
|---|---|---|
| 29 | 43 | |
| 30 | 42 | 71 |

**MAP 43**
Revised To
January 1, 1999
JAN 91 1999

1/1/06

# ASHBURNHAM, MASSACHUSETTS

ASSESSORS MAPS

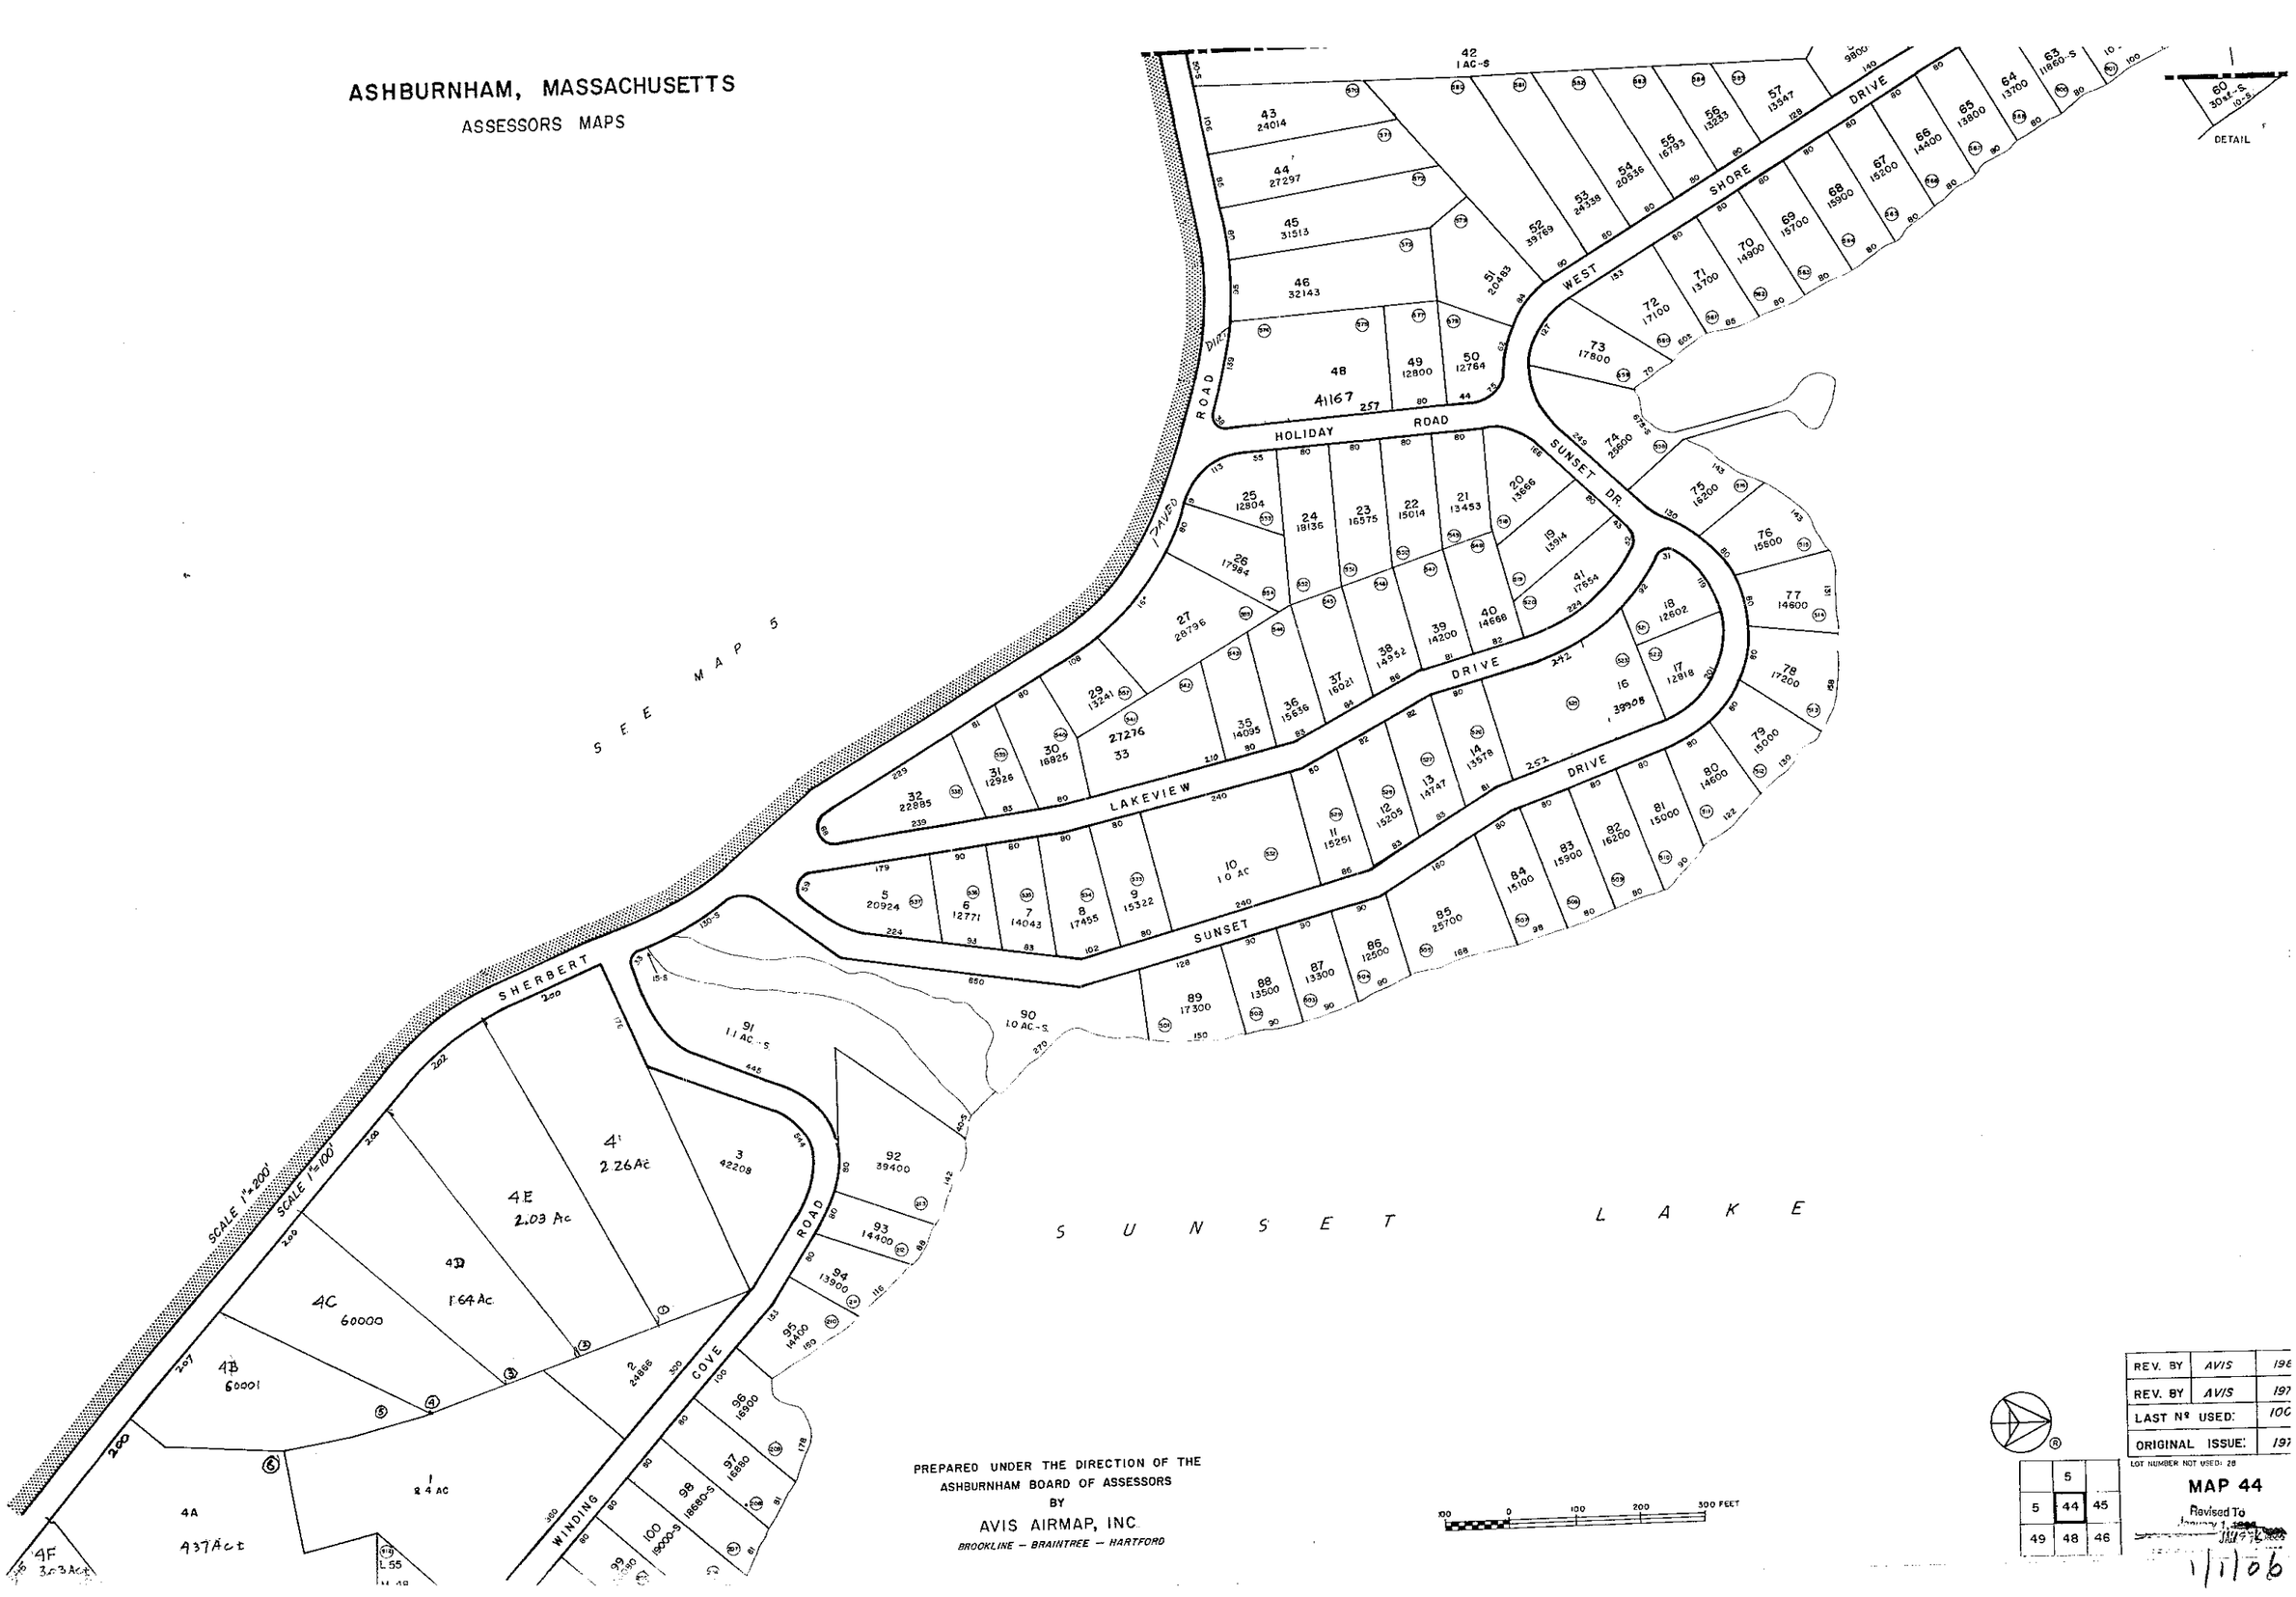


PREPARED UNDER THE DIRECTION OF THE
ASHBURNHAM BOARD OF ASSESSORS
BY
AVIS AIRMAP, INC.
*BROCKLINE — BRAINTREE — HARTFORD*

100 0 100 200 300 FEET

| | | |
|---|---|---|
| REV. BY | AVIS | 196 |
| REV. BY | AVIS | 197 |
| LAST Nº USED: | | 100 |
| ORIGINAL ISSUE: | | 197 |

LOT NUMBER NOT USED: 28

| | | |
|---|---|---|
| | 5 | |
| 5 | 44 | 45 |
| 49 | 48 | 46 |

**MAP 44**

Revised To
January 1, 2006

1/1/06

# ASHBURNHAM, MASSACHUSETTS

ASSESSORS MAPS

SUNSET LAKE

SEE MAP 6

PREPARED UNDER THE DIRECTION OF THE
ASHBURNHAM BOARD OF ASSESSORS
BY
AVIS AIRMAP, INC.
*BROOKLINE — BRAINTREE — HARTFORD*

100 0 100 200 300 FEET

| | | |
|---|---|---|
| REV. BY | AVIS | 1981 |
| REV. BY | AVIS | 1975 |
| REV. BY | AVIS | 1974 |
| LAST Nº USED: | | 119 |
| ORIGINAL ISSUE: | | 1972 |

NUMBERS NOT USED: 108 THRU 115

| | | |
|---|---|---|
| | | |
| 44 | 45 | 6 |
| 48 | 46 | |

MAP 45 1/1/06

Revised To January 1 1975

# ASHBURNHAM, MASSACHUSETTS

ASSESSORS MAPS

PREPARED UNDER THE DIRECTION OF THE
ASHBURNHAM BOARD OF ASSESSORS
BY
AVIS AIRMAP, INC
*BROOKLINE — BRAINTREE — HARTFORD*

| | | |
|---|---|---|
| REV. BY | AVIS | 1981 |
| REV. BY | AVIS | 1975 |
| REV. BY | AVIS | 1974 |
| LAST Nº USED: | | 65 |
| ORIGINAL ISSUE: | | 1972 |

NUMBER NOT USED: 53 64

| | | |
|---|---|---|
| 44 | 45 | |
| | 46 | 6 |
| 48 | 47 | |

**MAP 46**

Revised To ~~January 1, 1988~~ 1/1/06

# ASHBURNHAM, MASSACHUSETTS

ASSESSORS MAPS

100 0 100 200 300 FEET

PREPARED UNDER THE DIRECTION OF THE
ASHBURNHAM BOARD OF ASSESSORS
BY
AVIS AIRMAP, INC
*BROOKLINE — BRAINTREE — HARTFORD*

| | |
|---|---|
| REV. BY | AVIS 1976 |
| LAST Nº USED: | 93 |
| ORIGINAL ISSUE: | 1972 |

NUMBER NOT USED: 86

| | | |
|---|---|---|
| | 46 | |
| 48 | 47 | 6 |

**MAP 47** 1/1/06

Revised to January 1, X 1 1985

# ASHBURNHAM, MASSACHUSETTS

ASSESSORS MAPS

| | | |
|---|---|---|
| REV. BY | AVIS | 1975 |
| LAST Nº USED: | | 168 |
| ORIGINAL ISSUE: | | 1972 |

**MAP 48**

SEE MAP 44

SEE MAP 49

SEE MAP 54

SEE MAP 46

SEE MAP 47

SEE INSET

INSET

| | | |
|---|---|---|
| 5 | 44 | 45 |
| | 48 | 47 |
| 49 | 10 | |

PREPARED UNDER THE DIRECTION OF THE
ASHBURNHAM BOARD OF ASSESSORS
BY
AVIS AIRMAP, INC

MAP 48
Revised To
January 1, 1972

1/1/06

# ASHBURNHAM, MASSACHUSETTS

ASSESSORS MAPS

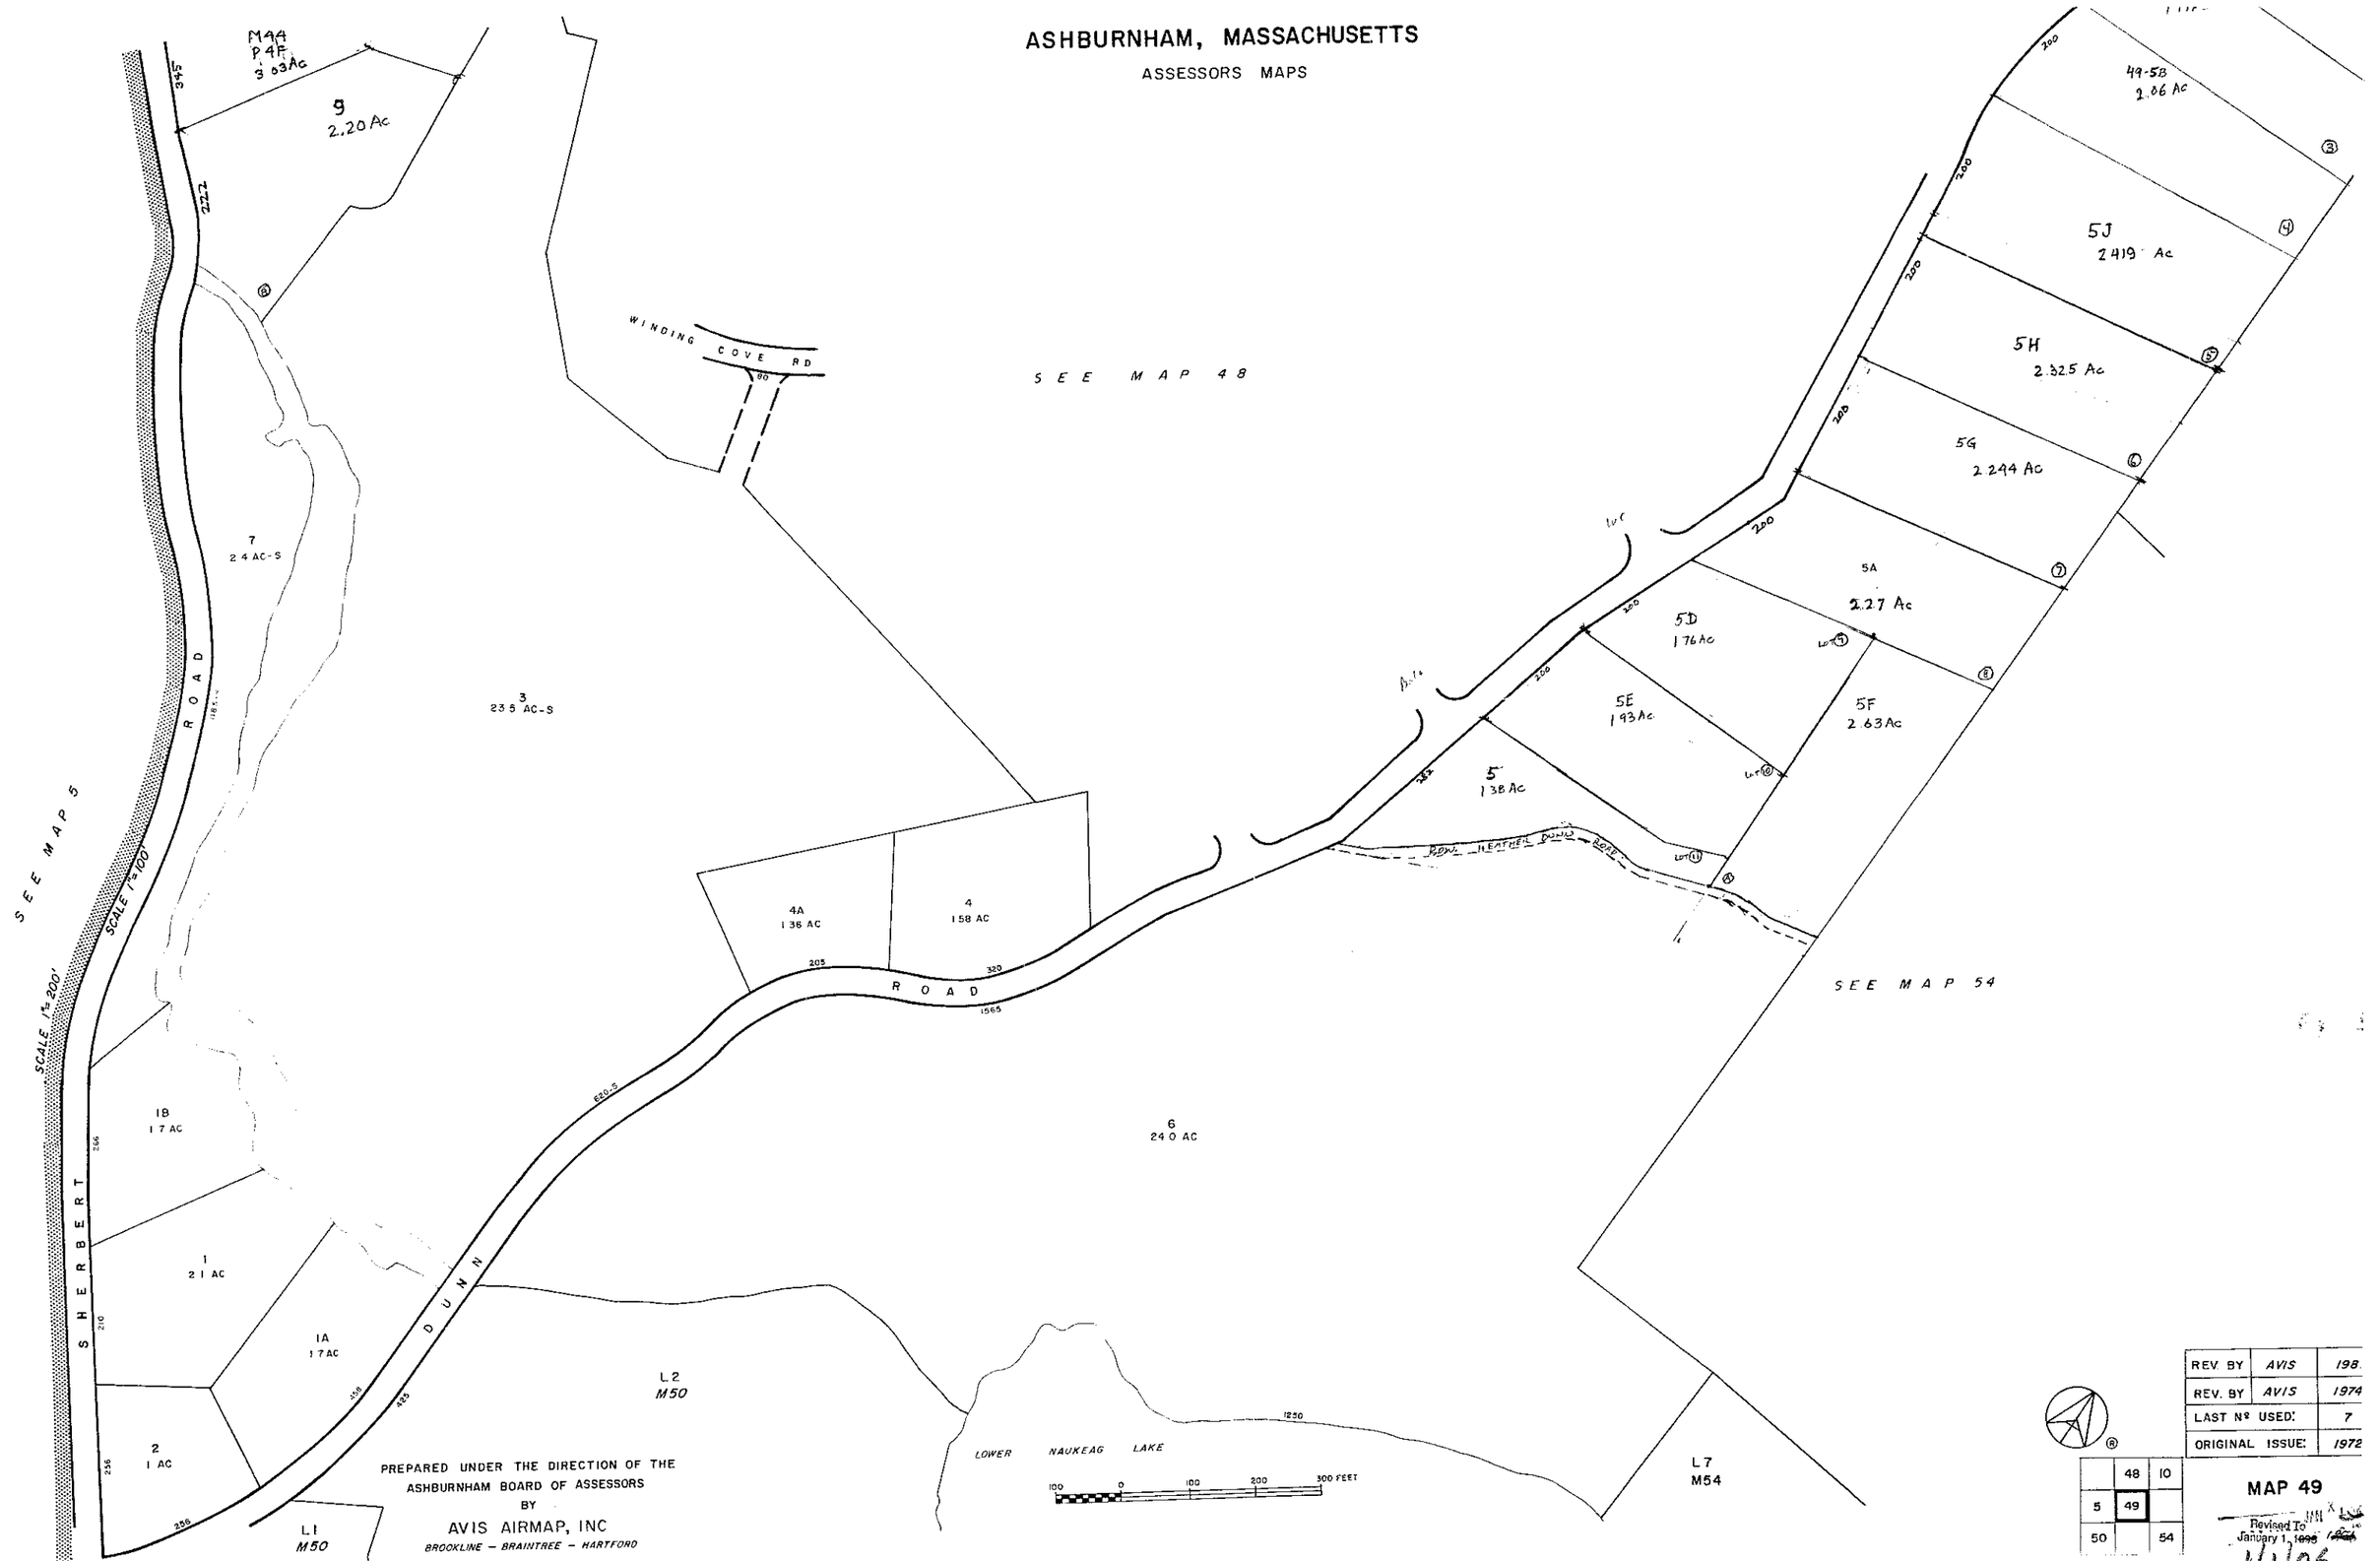


| | | |
|---|---|---|
| REV. BY | AVIS | 198 |
| REV. BY | AVIS | 1974 |
| LAST Nº USED: | | 7 |
| ORIGINAL ISSUE: | | 1972 |

| | | |
|---|---|---|
| | 48 | 10 |
| 5 | 49 | |
| 50 | | 54 |

**MAP 49**

Revised To:
January 1, ~~1998~~ 2006
1/1/06

# ASHBURNHAM, MASSACHUSETTS

ASSESSORS MAPS

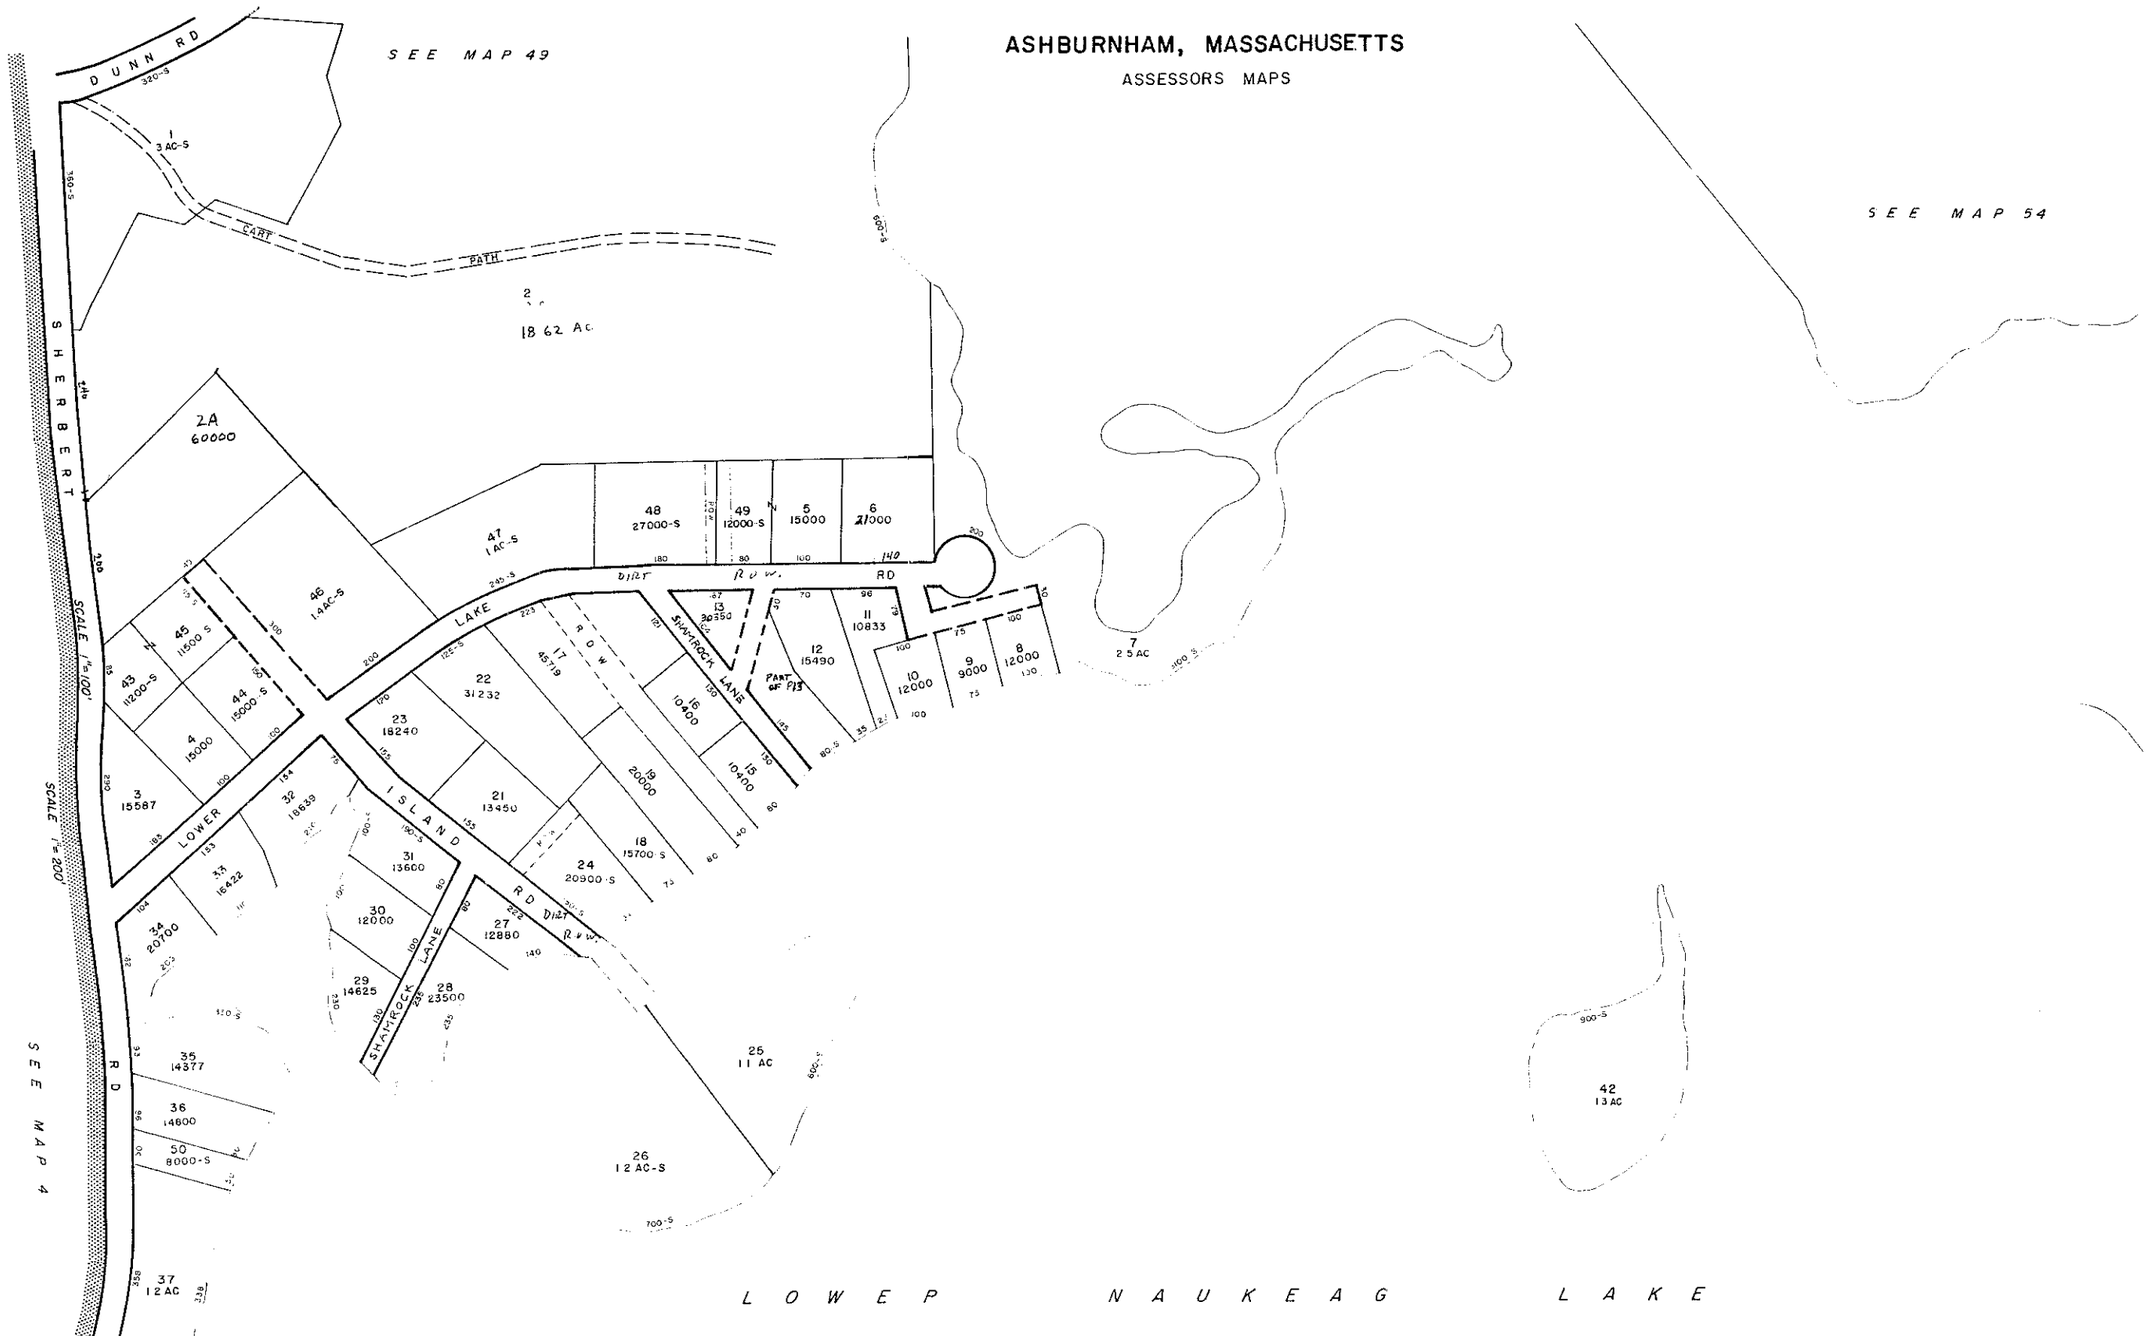


SCALE 1" = 100'

SCALE 1" = 200'

PREPARED UNDER THE DIRECTION OF THE
ASHBURNHAM BOARD OF ASSESSORS
BY
AVIS AIRMAP, INC
*BROOKLINE — BRAINTREE — HARTFORD*

100 0 100 200 300 FEET

| | | |
|---|---|---|
| REV. BY | AVIS | 1981 |
| REV. BY | AVIS | 1975 |
| REV. BY | AVIS | 1974 |
| LAST Nº USED: | | 50 |
| ORIGINAL ISSUE: | | 1972 |

| | | |
|---|---|---|
| 5 | 49 | 54 |
| 4 | 50 | 53 |
| | 51 | |

MAP 50 1/1/06

Revised To January 1 1963 X 1 1996

# ASHBURNHAM, MASSACHUSETTS

ASSESSORS MAPS

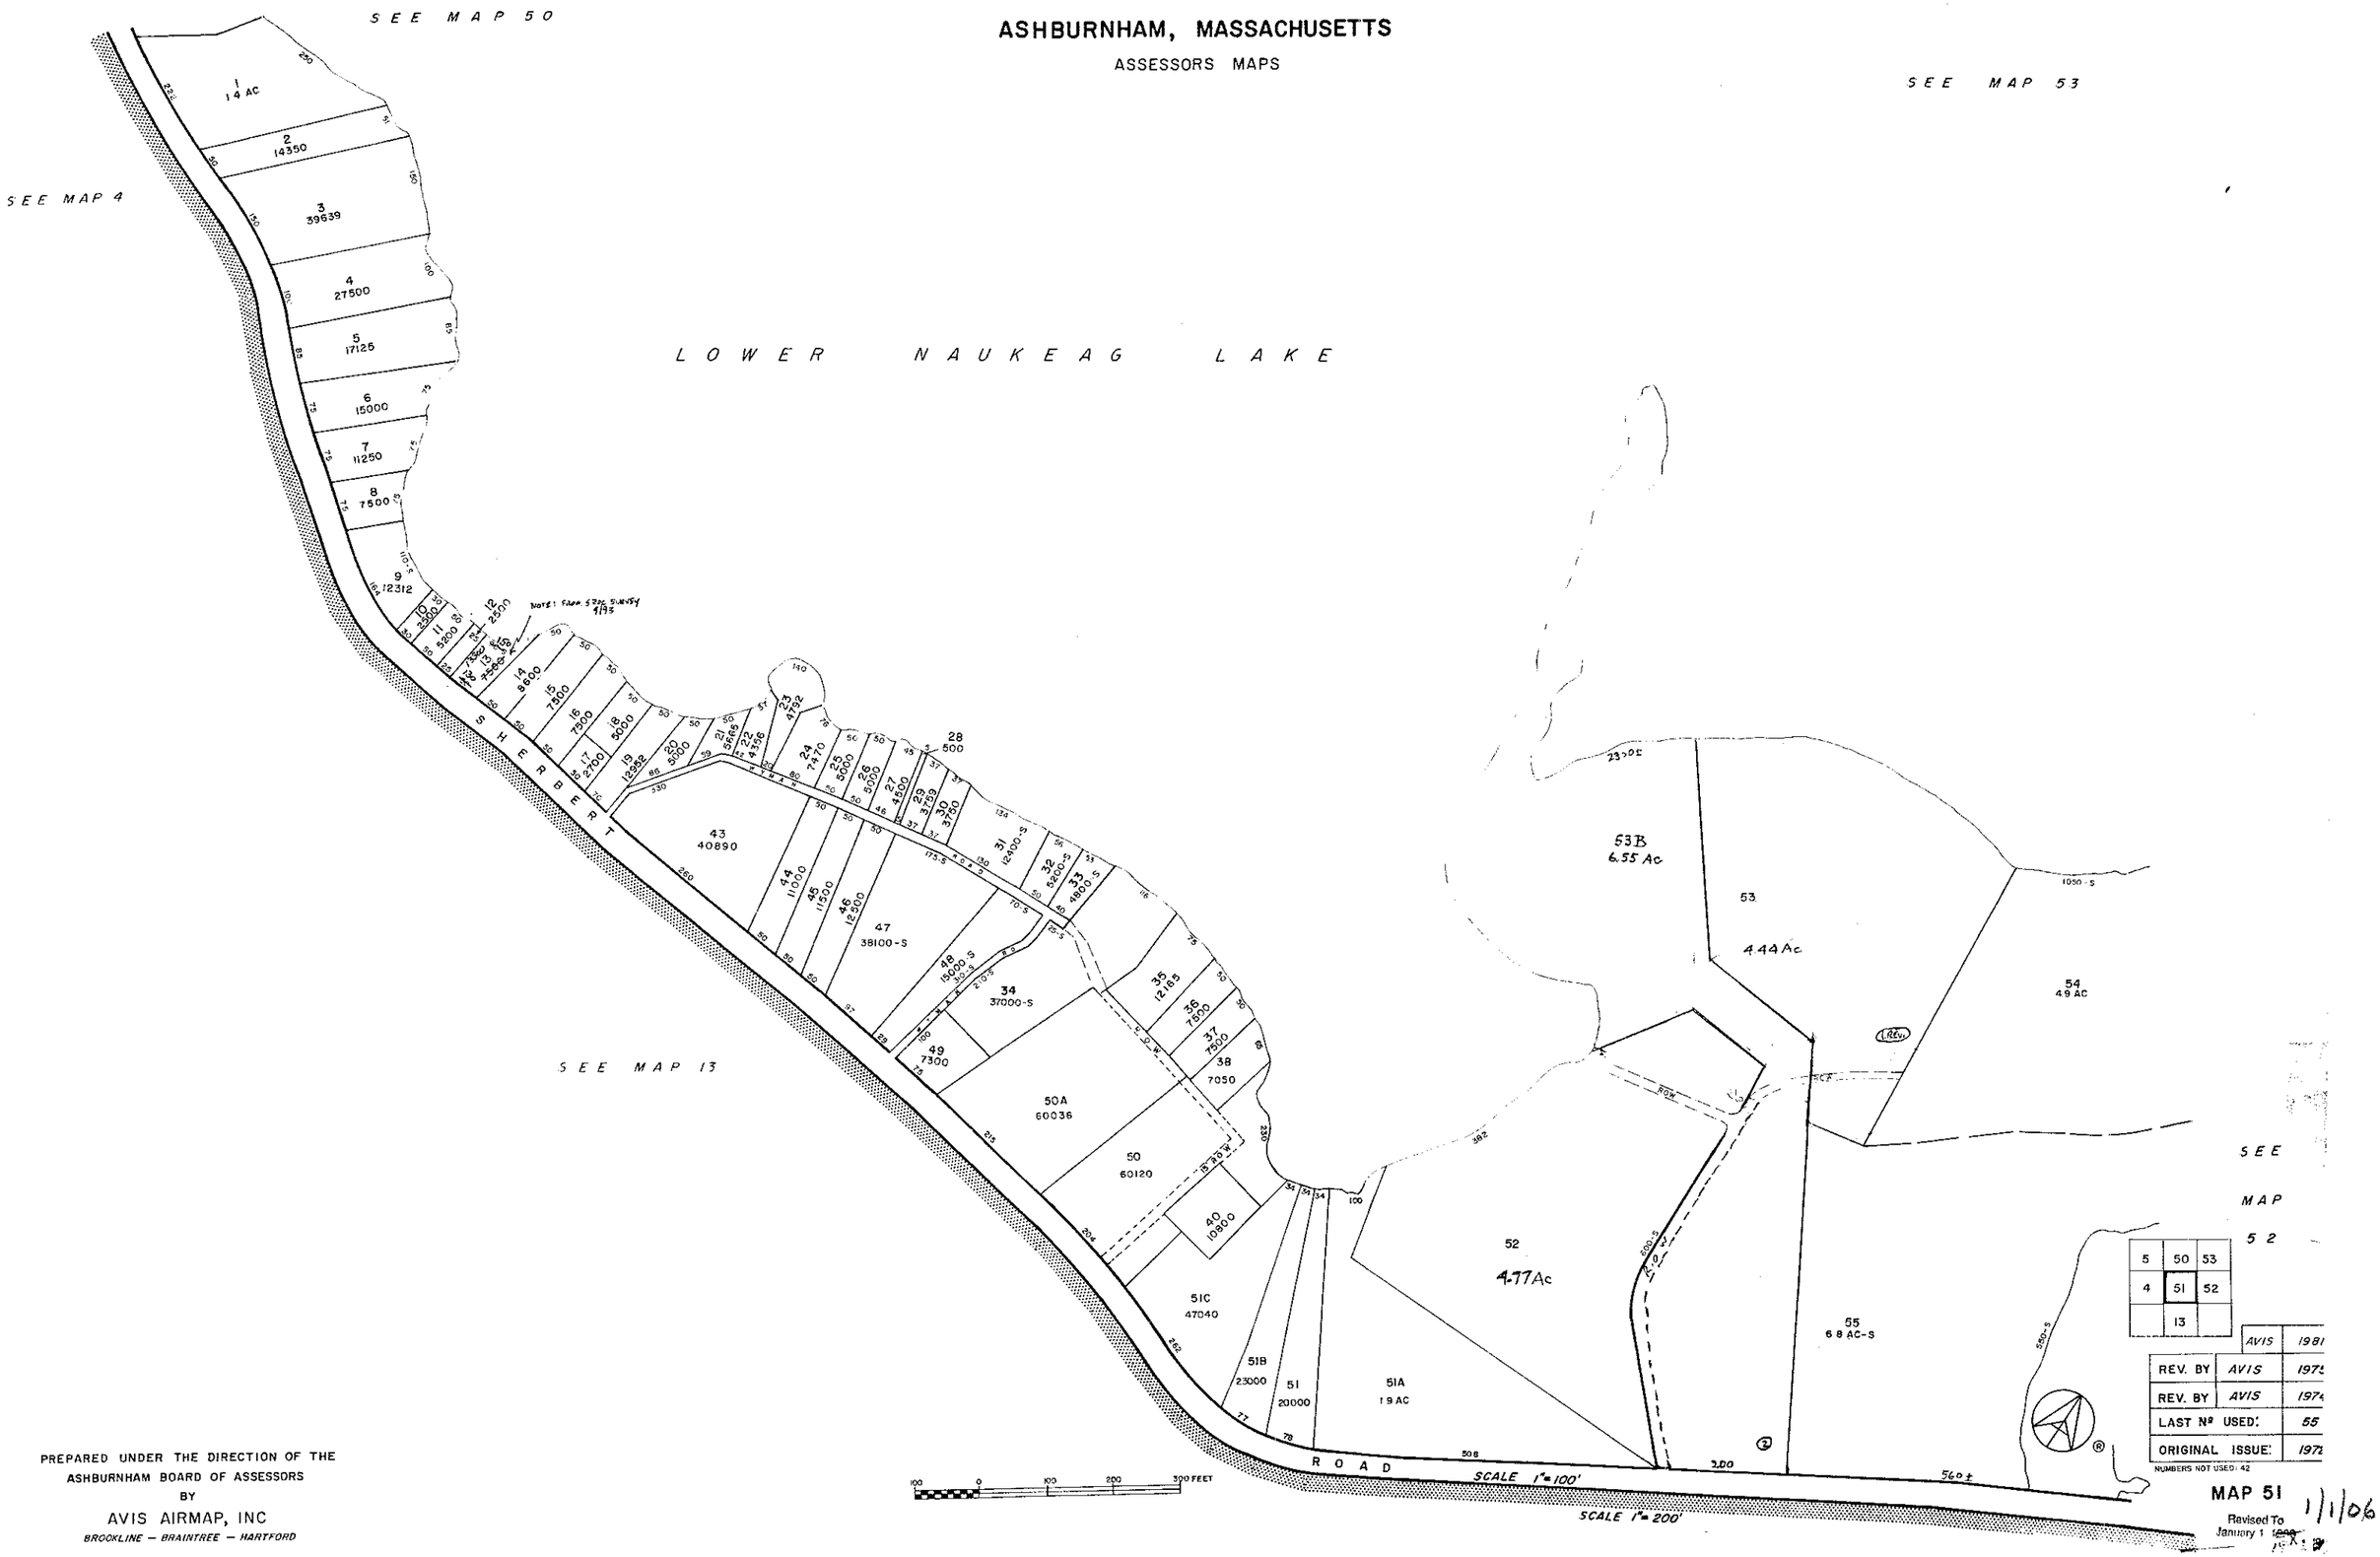


| | | |
|---|---|---|
| 5 | 50 | 53 |
| 4 | 51 | 52 |
| | 13 | |

| | | |
|---|---|---|
| | AVIS | 1981 |
| REV. BY | AVIS | 1975 |
| REV. BY | AVIS | 1974 |
| LAST Nº USED: | | 55 |
| ORIGINAL ISSUE: | | 1972 |

NUMBERS NOT USED: 42

**MAP 51**

Revised To January 1 1980

1/1/06

PREPARED UNDER THE DIRECTION OF THE
ASHBURNHAM BOARD OF ASSESSORS
BY
AVIS AIRMAP, INC
*BROOKLINE — BRAINTREE — HARTFORD*

# ASHBURNHAM, MASSACHUSETTS

ASSESSORS MAPS

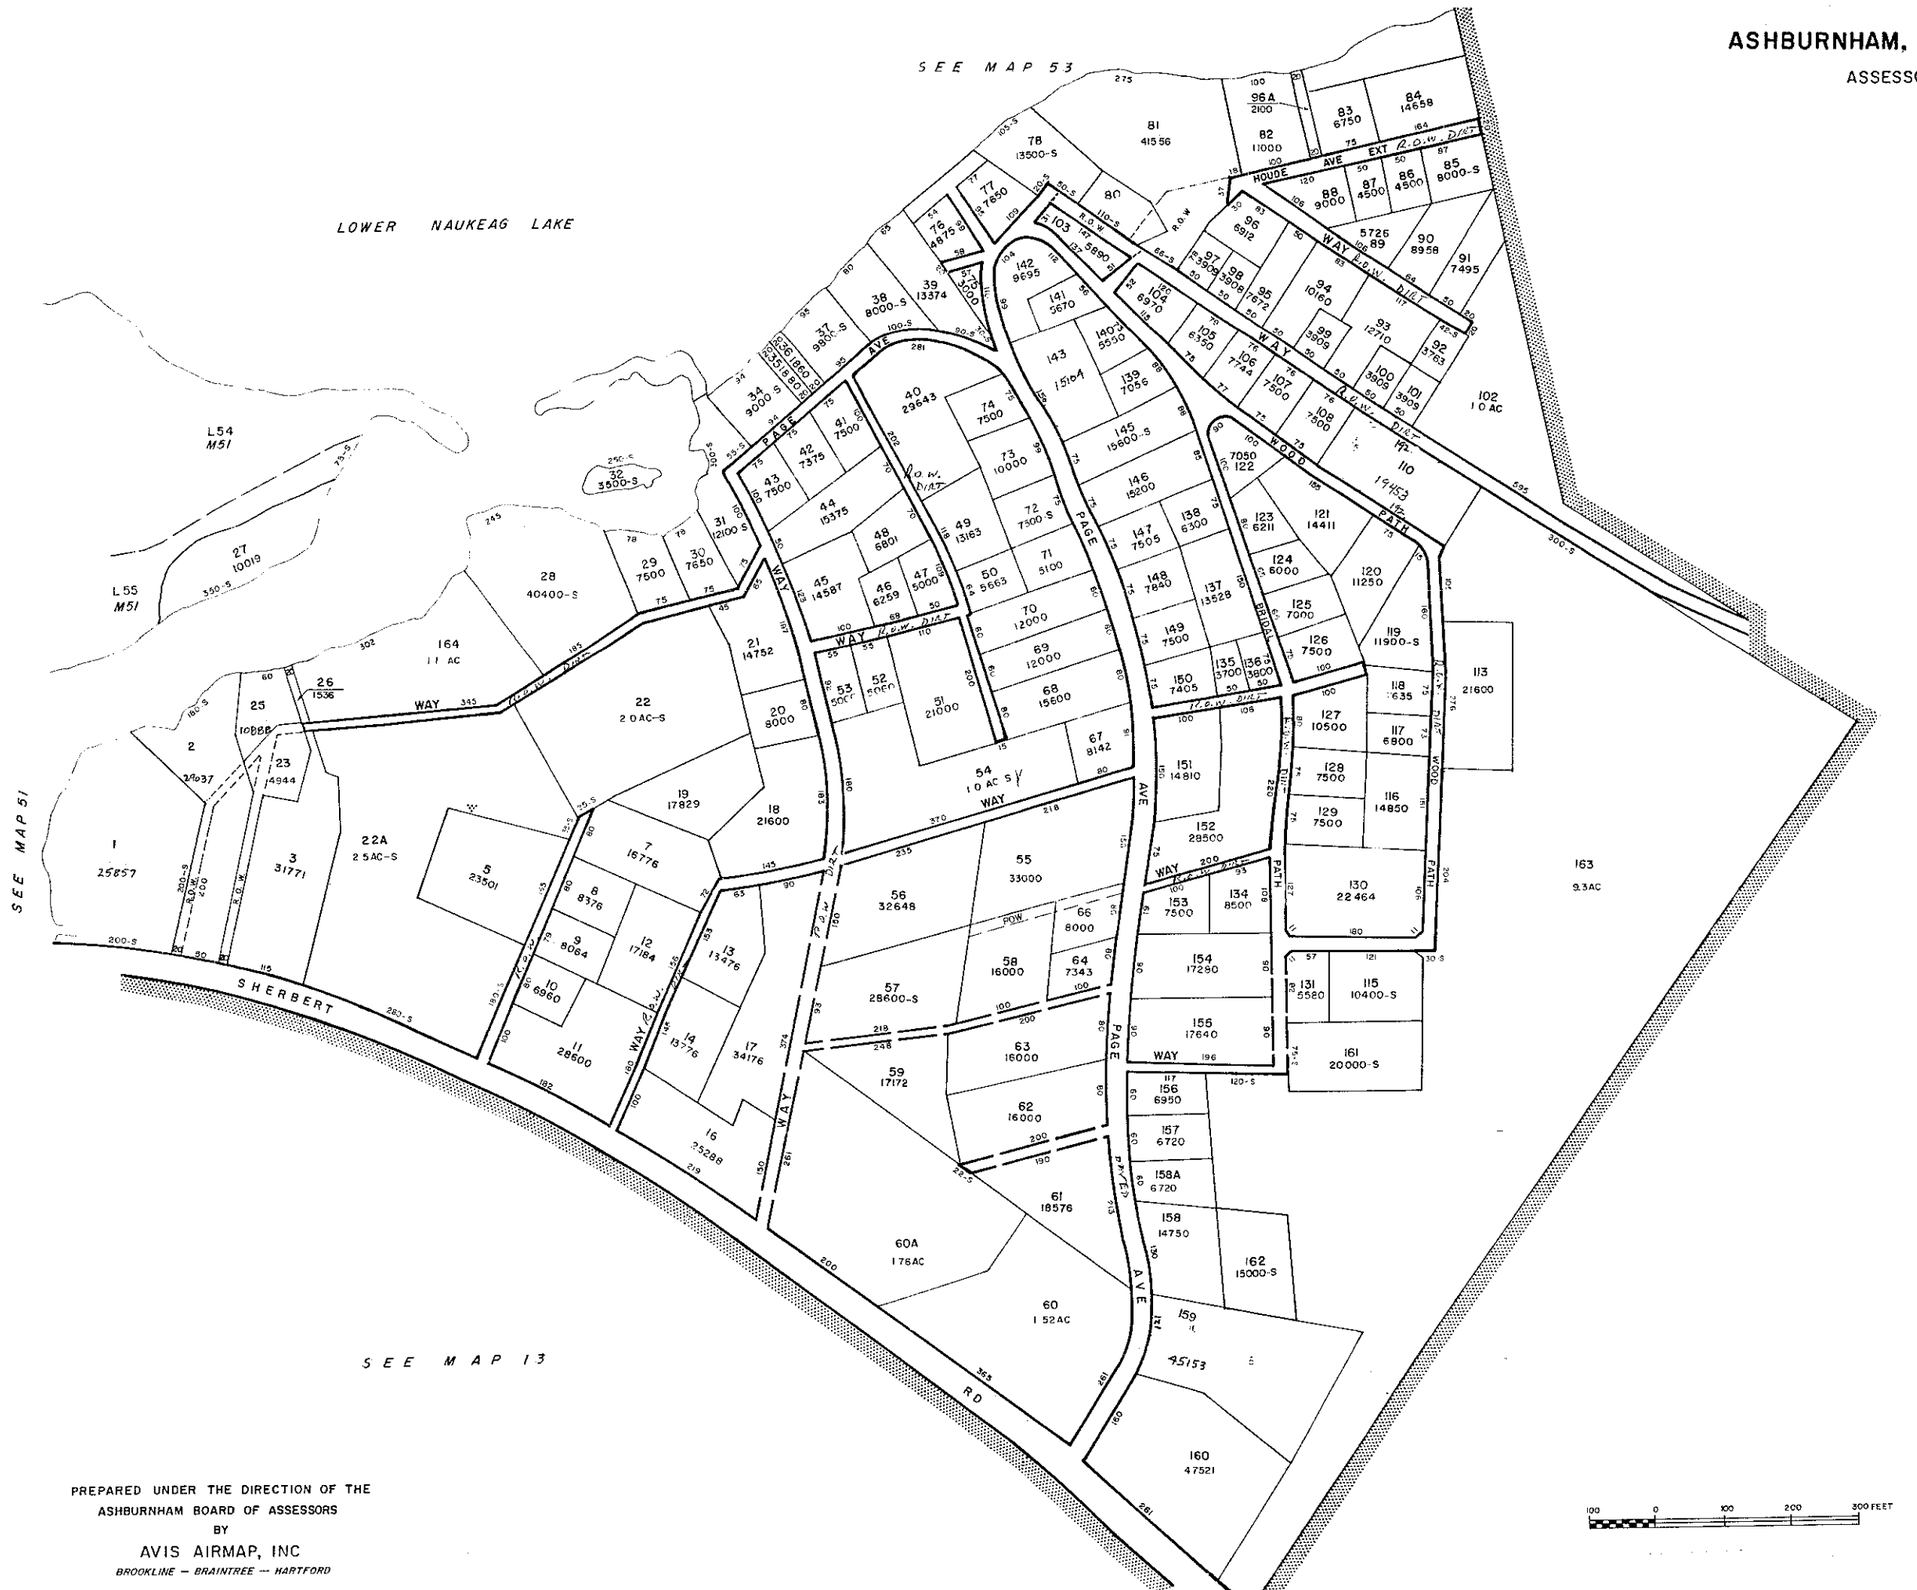


PREPARED UNDER THE DIRECTION OF THE
ASHBURNHAM BOARD OF ASSESSORS
BY
AVIS AIRMAP, INC
*BROOKLINE — BRAINTREE — HARTFORD*

| | | |
|---|---|---|
| REV. BY | AVIS | 1981 |
| REV. BY | AVIS | 1975 |
| REV. BY | AVIS | 1974 |
| LAST Nº USED: | | 164 |
| ORIGINAL ISSUE: | | 1972 |

LOT NUMBERS NOT USED: 4,6,15,26,33,71,80,84,132,134,165,166,171

| | | |
|---|---|---|
| 50 | 53 | |
| 51 | 52 | 12 |
| | 13 | |

**MAP 52**

Revised To 1/1/06

# ASHBURNHAM, MASSACHUSETTS

ASSESSORS MAPS

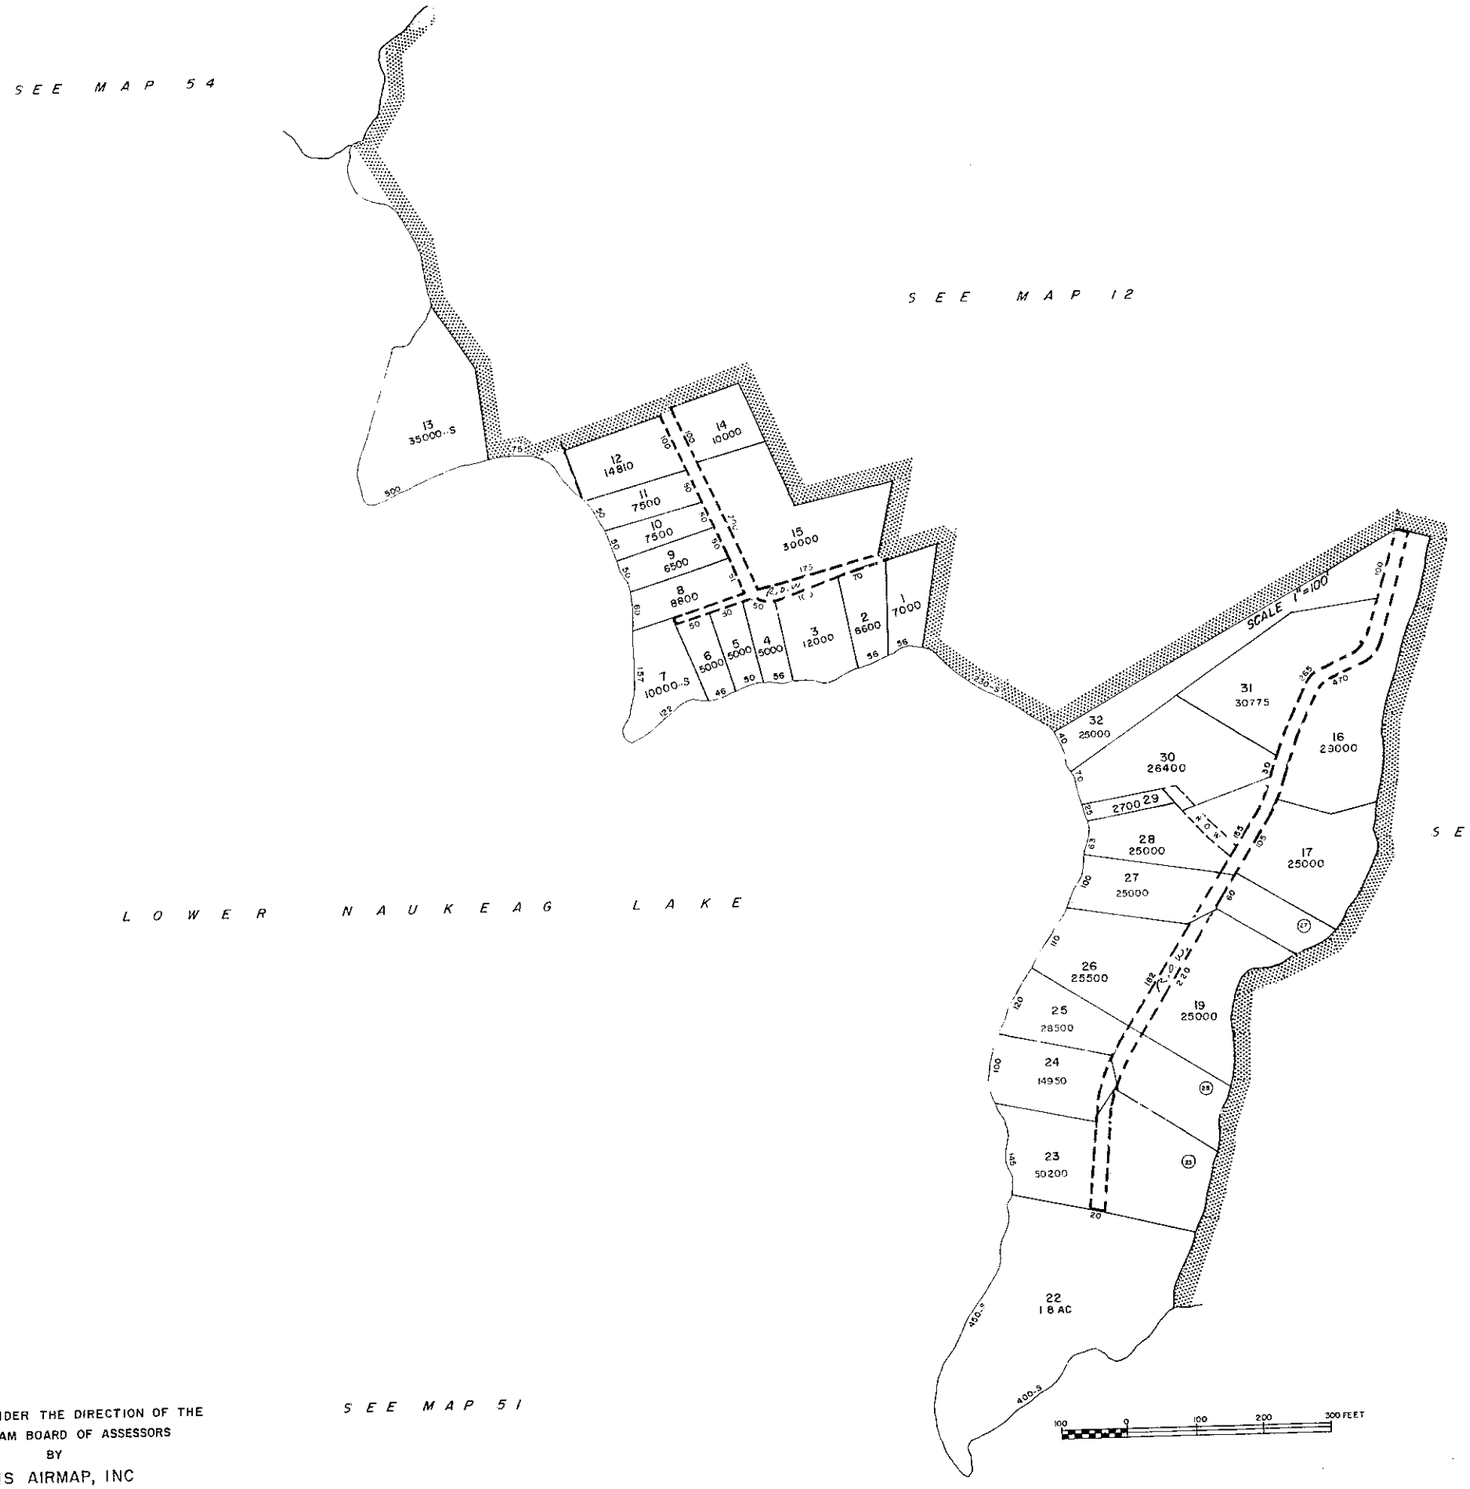


PREPARED UNDER THE DIRECTION OF THE
ASHBURNHAM BOARD OF ASSESSORS
BY
AVIS AIRMAP, INC
*BROOKLINE – BRAINTREE – HARTFORD*

| | | |
|---|---|---|
| 54 | 12 | |
| 50 | 53 | 12 |
| 51 | 52 | |

| | |
|---|---|
| REV. BY | AVIS |
| LAST Nº USED: | |
| ORIGINAL ISSUE: | |

NOT USED: 18 20 21

**MAP 53**

Revised To January 1 ~~1999~~ 1/1/06

# ASHBURNHAM, MASSACHUSETTS

ASSESSORS MAPS

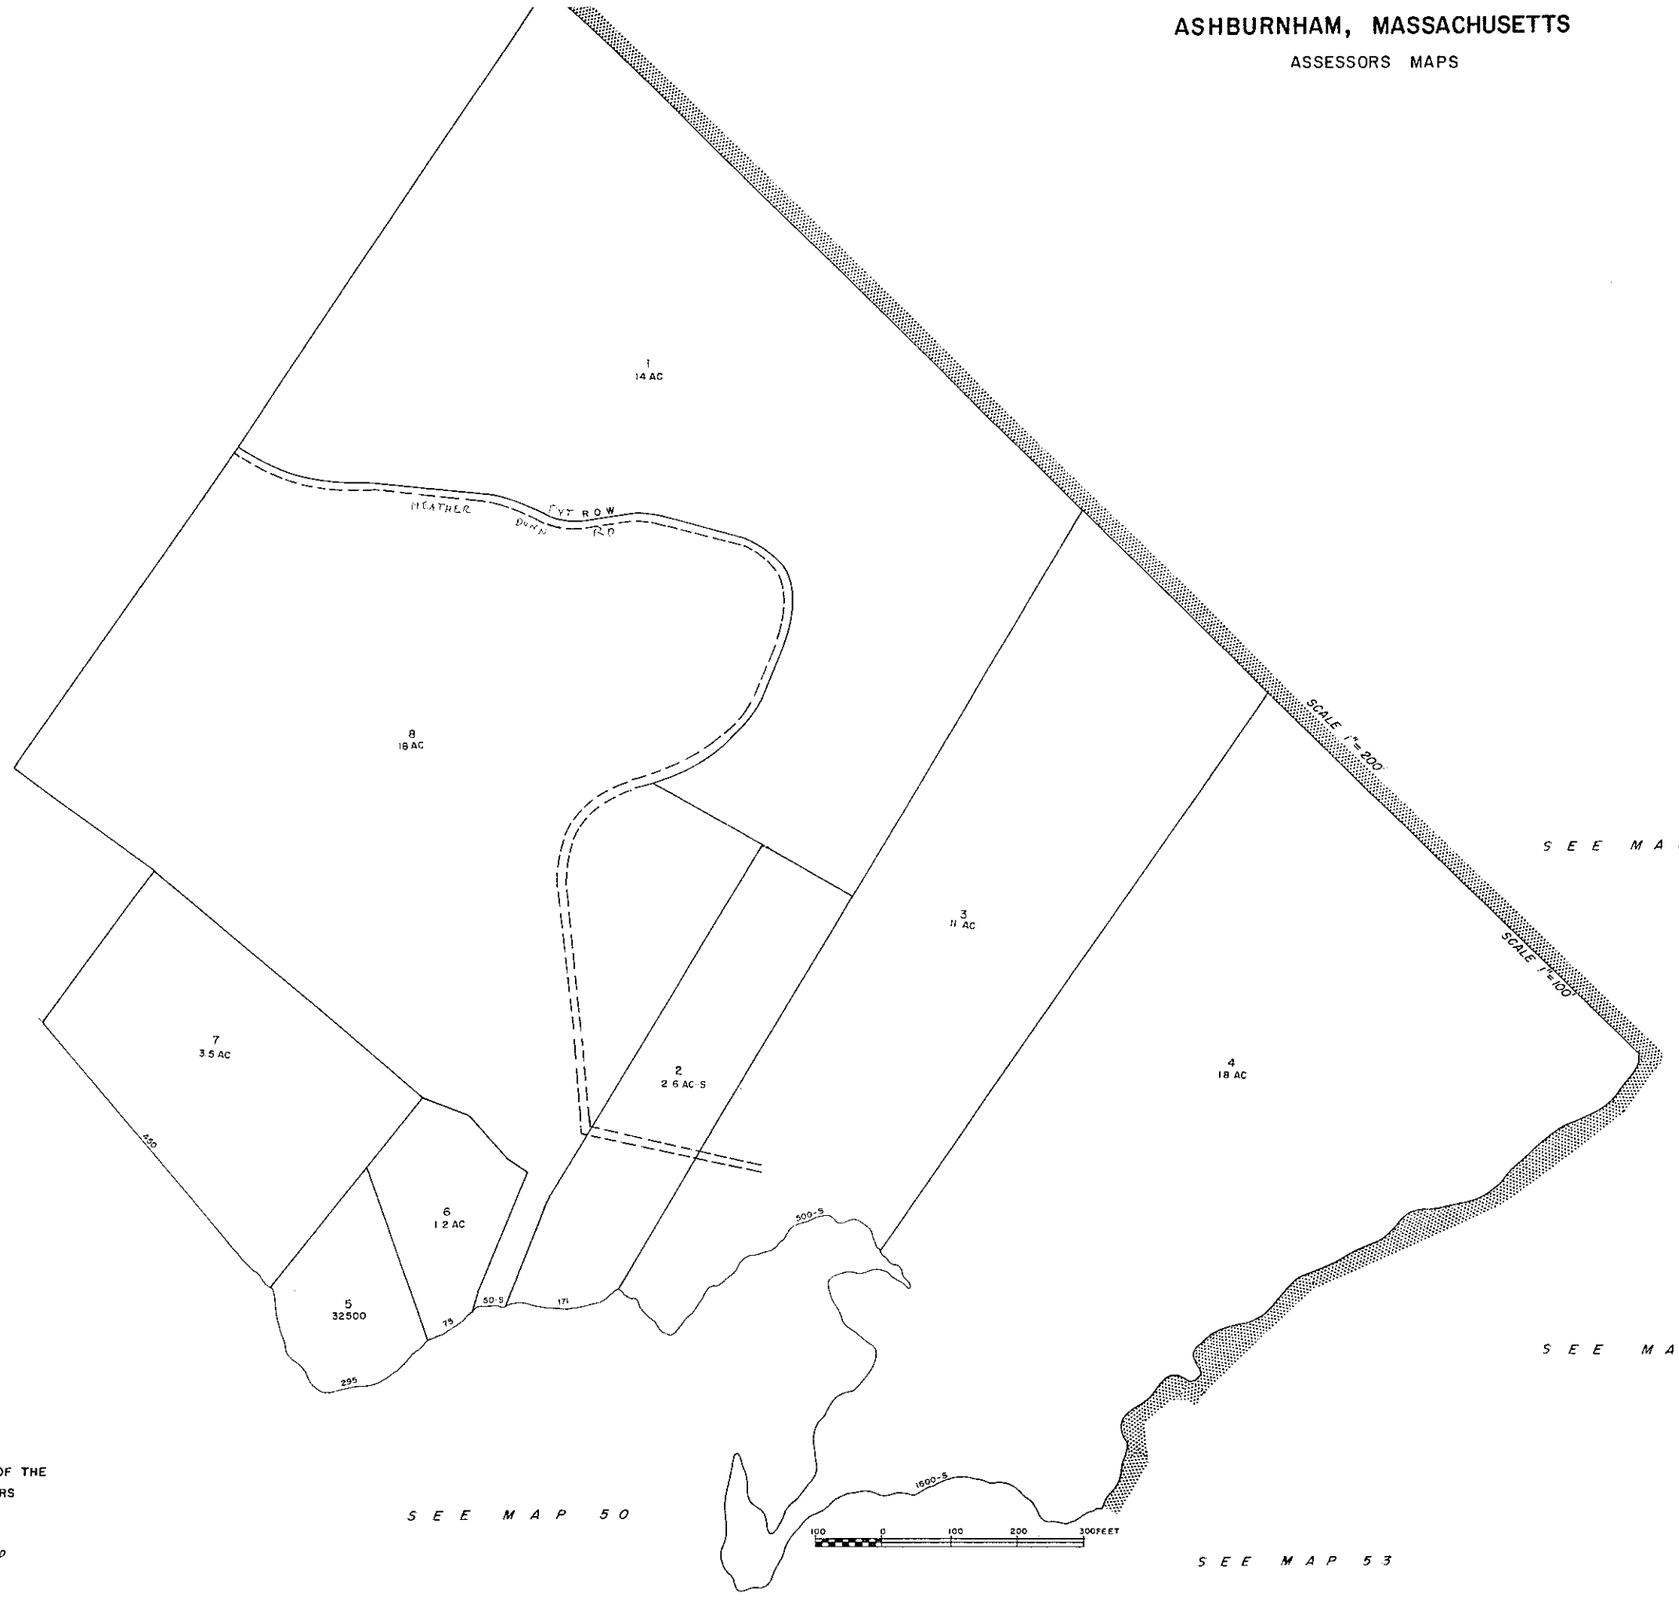


PREPARED UNDER THE DIRECTION OF THE
ASSESSORS OF ASHBURNHAM
BY
AVIS AIRMAP, INC
*BROOKLINE — BRAINTREE — HARTFORD*

| | | |
|---|---|---|
| REV. BY | AVIS | 1981 |
| REV. BY | AVIS | 1975 |
| LAST Nº USED: | | 8 |
| ORIGINAL ISSUE: | | 1972 |

| | | |
|---|---|---|
| 49 | 10 | |
| | 54 | 12 |
| 50 | | 53 |

MAP 54 1/1/06

Revised To Year End
January 1, 2006

# ASHBURNHAM, MASSACHUSETTS

ASSESSORS MAPS

SEE MAP 9

SEE MAP 56

SEE MAP 11

SEE MAP 10

SCALE 1"=200'
SCALE 1" = 100'

LAKE WATATIC

PEARL RD
KANE RD
CHARM RD
CRANDOR RD
SHORE DRIVE
PVT DIRT RD
PEARL RD
PEARL RD
ROAD
PVT DIRT
SHORE DR

MIDWAY AVE
PINK BEACH AVE
OAK AVE
SUNSET AVE
VIEW AVE
SPRUCE AVE
BALSAM AVE
WESTWOOD AVE
BANK AVE
ALL DIRT R.D.W.'S

| | | |
|---|---|---|
| REV. BY | AVIS | 1981 |
| REV. BY | AVIS | 1975 |
| REV. BY | AVIS | 1974 |
| LAST Nº USED: | | 128 |
| ORIGINAL ISSUE: | | 1972 |

NOT USED: 56

| | | |
|---|---|---|
| 9 | 56 | |
| | 55 | 11 |
| 10 | | |

MAP 55 1/1/06

Revised To
January 1, 1999

100 0 100 200 300 FEET

PREPARED UNDER THE DIRECTION OF THE
ASHBURNHAM BOARD OF ASSESSORS
BY
AVIS AIRMAP, INC.
*BROOKLINE — BRAINTREE — HARTFORD*

# ASHBURNHAM, MASSACHUSETTS

ASSESSORS MAPS

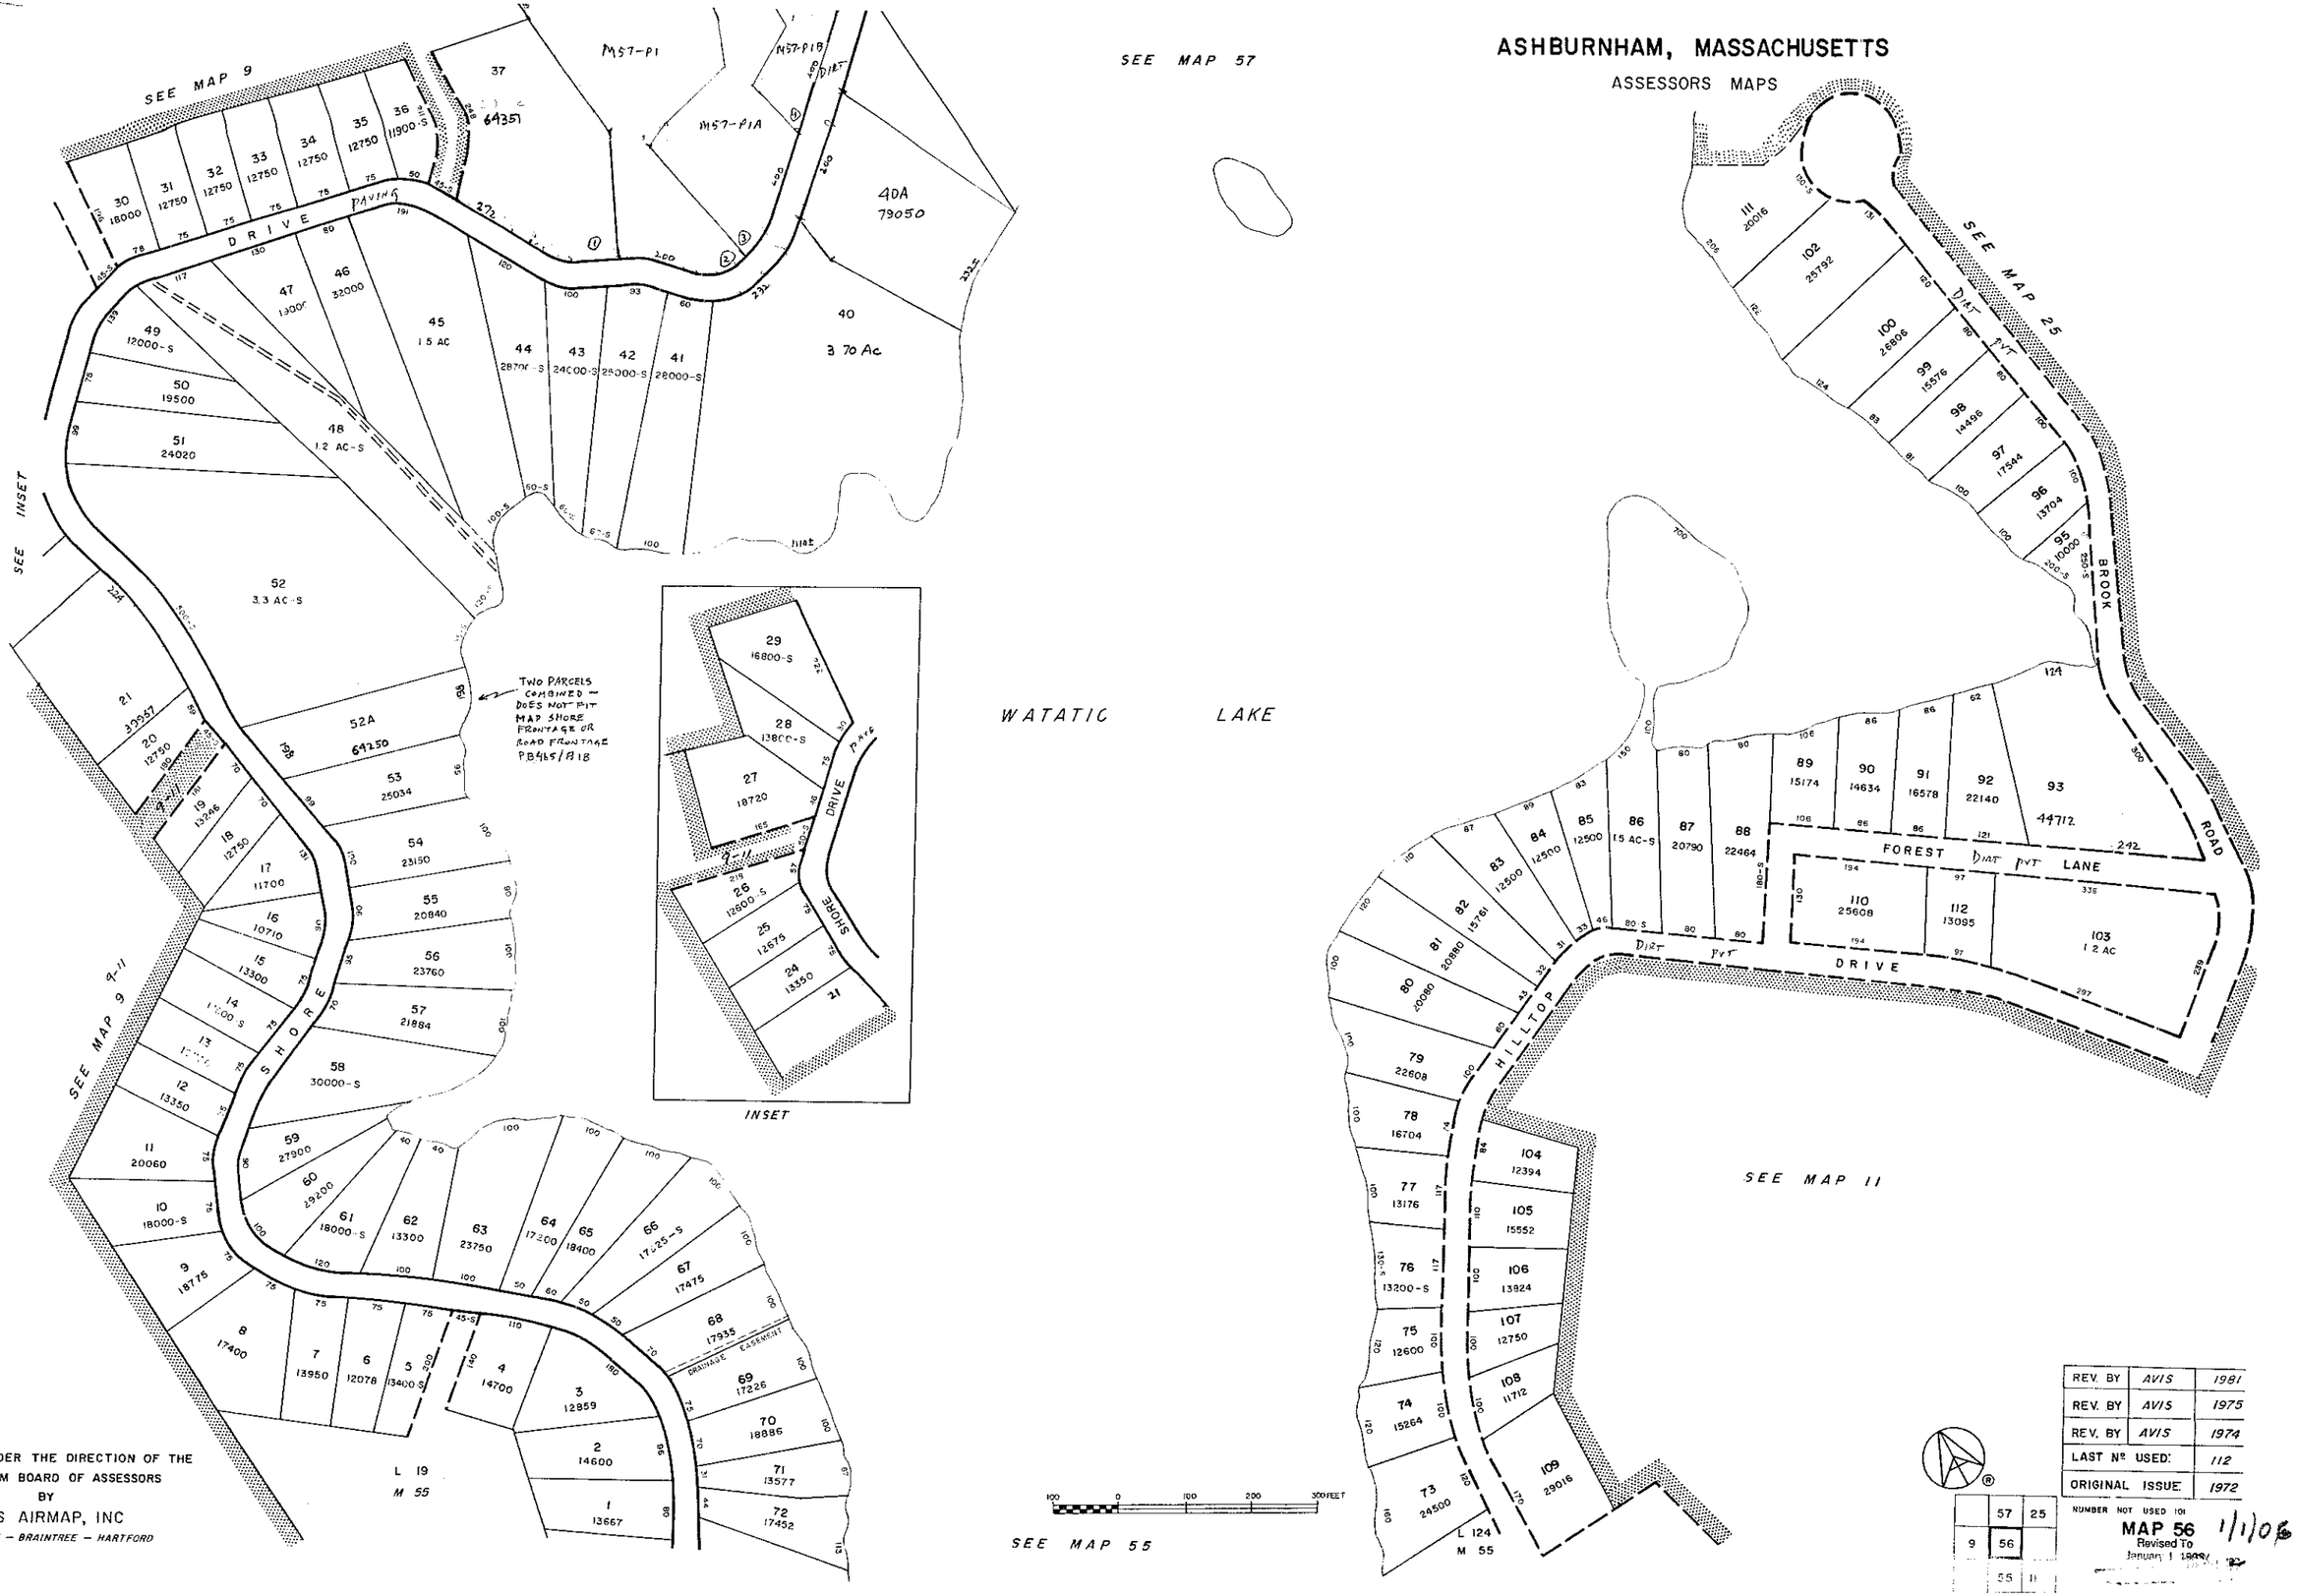


PREPARED UNDER THE DIRECTION OF THE ASHBURNHAM BOARD OF ASSESSORS BY

AVIS AIRMAP, INC

*BROOKLINE — BRAINTREE — HARTFORD*

| | |
|---|---|
| REV. BY AVIS | 1981 |
| REV. BY AVIS | 1975 |
| REV. BY AVIS | 1974 |
| LAST Nº USED: | 112 |
| ORIGINAL ISSUE: | 1972 |

NUMBER NOT USED 101

**MAP 56** 1/1/06

Revised To January 1 1982

| | | |
|---|---|---|
| | 57 | 25 |
| 9 | 56 | |
| | 55 | 11 |

# ASHBURNHAM, MASSACHUSETTS

ASSESSORS MAPS

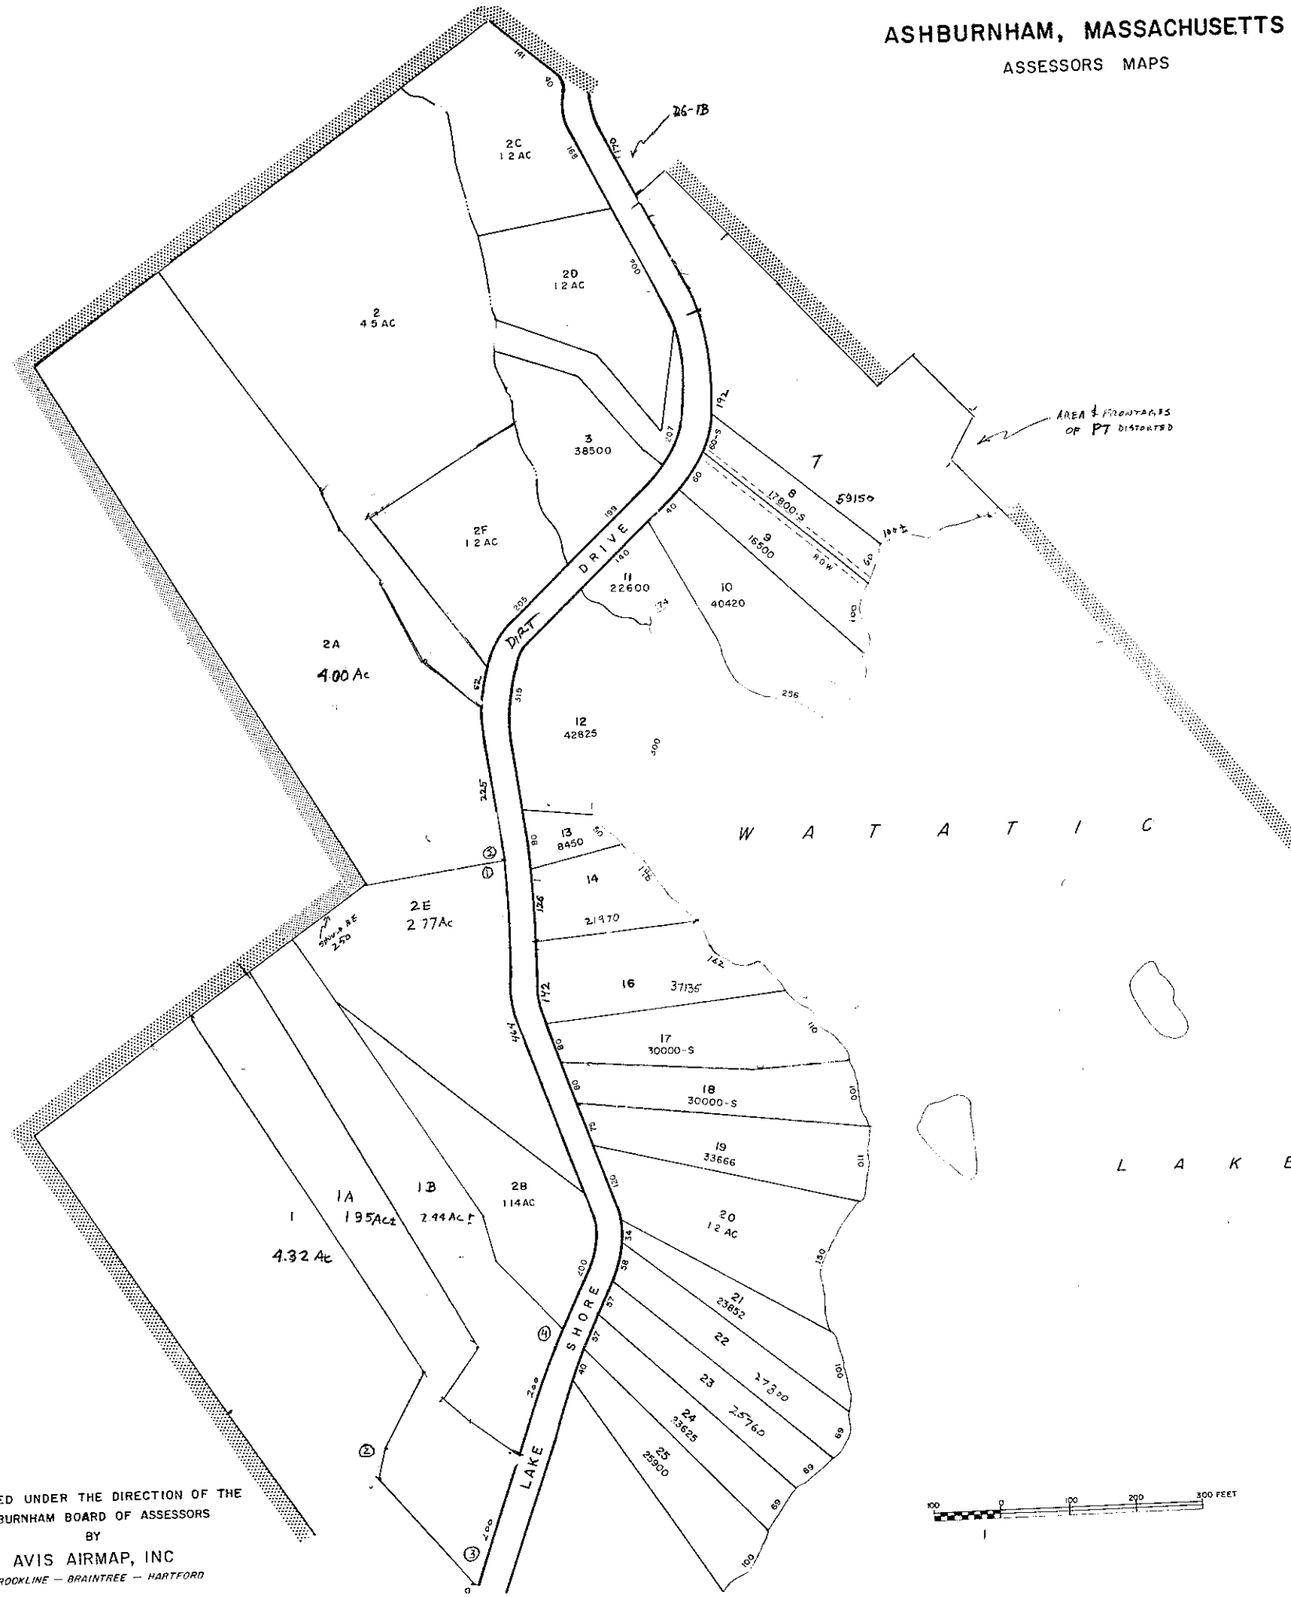


PREPARED UNDER THE DIRECTION OF THE
ASHBURNHAM BOARD OF ASSESSORS
BY
AVIS AIRMAP, INC
*BROOKLINE — BRAINTREE — HARTFORD*

| | | |
|---|---|---|
| REV. BY | AVIS | 1S |
| REV. BY | AVIS | 1S |
| REV. BY | AVIS | 1S |
| ORIGINAL ISSUE: | | 1S |

LAST NUMBER USED 25

**MAP 57**

Revised To January 1, 2006

| | | |
|---|---|---|
| | | 26 |
| 9 | 57 | |
| | 56 | |

# ASHBURNHAM, MASSACHUSETTS

ASSESSORS MAPS

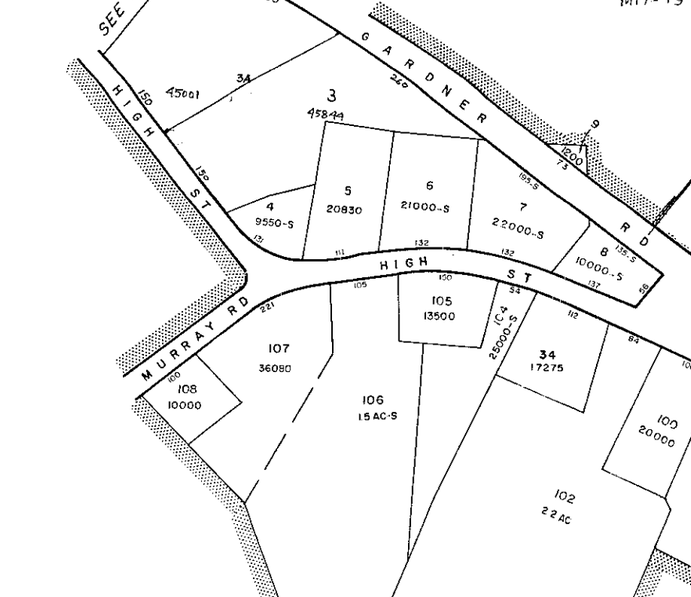


PREPARED UNDER THE DIRECTION OF THE
ASHBURNHAM BOARD OF ASSESSORS
BY
AVIS AIRMAP, INC
*BROOKLINE – BRAINTREE – HARTFORD*

| | | |
|---|---|---|
| REV. BY | AVIS | 1981 |
| REV. BY | AVIS | 1975 |
| REV. BY | AVIS | 1974 |
| LAST Nº USED: | | 115 |
| ORIGINAL ISSUE: | | 1972 |

NUMBERS NOT USED: 83, 84, 92, 93, 58, 70

| | | |
|---|---|---|
| | | 19 |
| 17 | 58 | |

MAP 58 1/1/06

Revised To JAN 1 1990

# ASHBURNHAM, MASSACHUSETTS

ASSESSORS MAPS

| | | |
|---|---|---|
| REV BY | AVIS | 1981 |
| REV. BY | AVIS | 1975 |
| REV. BY | AVIS | 1974 |
| LAST Nº USED: | | 57 |
| ORIGINAL ISSUE: | | 1972 |

NUMBER NOT USED: 28

## MAP 59

SEE MAP 17

SEE MAP 18

SEE MAP 19

SEE MAP 60

GARDNER

SCHOOL STREET

MAIN STREET

WHITNEY DRIVE

WILLIAMS ROAD

R.O.W.

SCALE 1" = 100'

PREPARED UNDER THE DIRECTION OF THE
ASHBURNHAM BOARD OF ASSESSORS
BY
AVIS AIRMAP, INC
*BROOKLINE — BRAINTREE — HARTFORD*

1/1/06

MAP 59

# ASHBURNHAM, MASSACHUSETTS

ASSESSORS MAPS

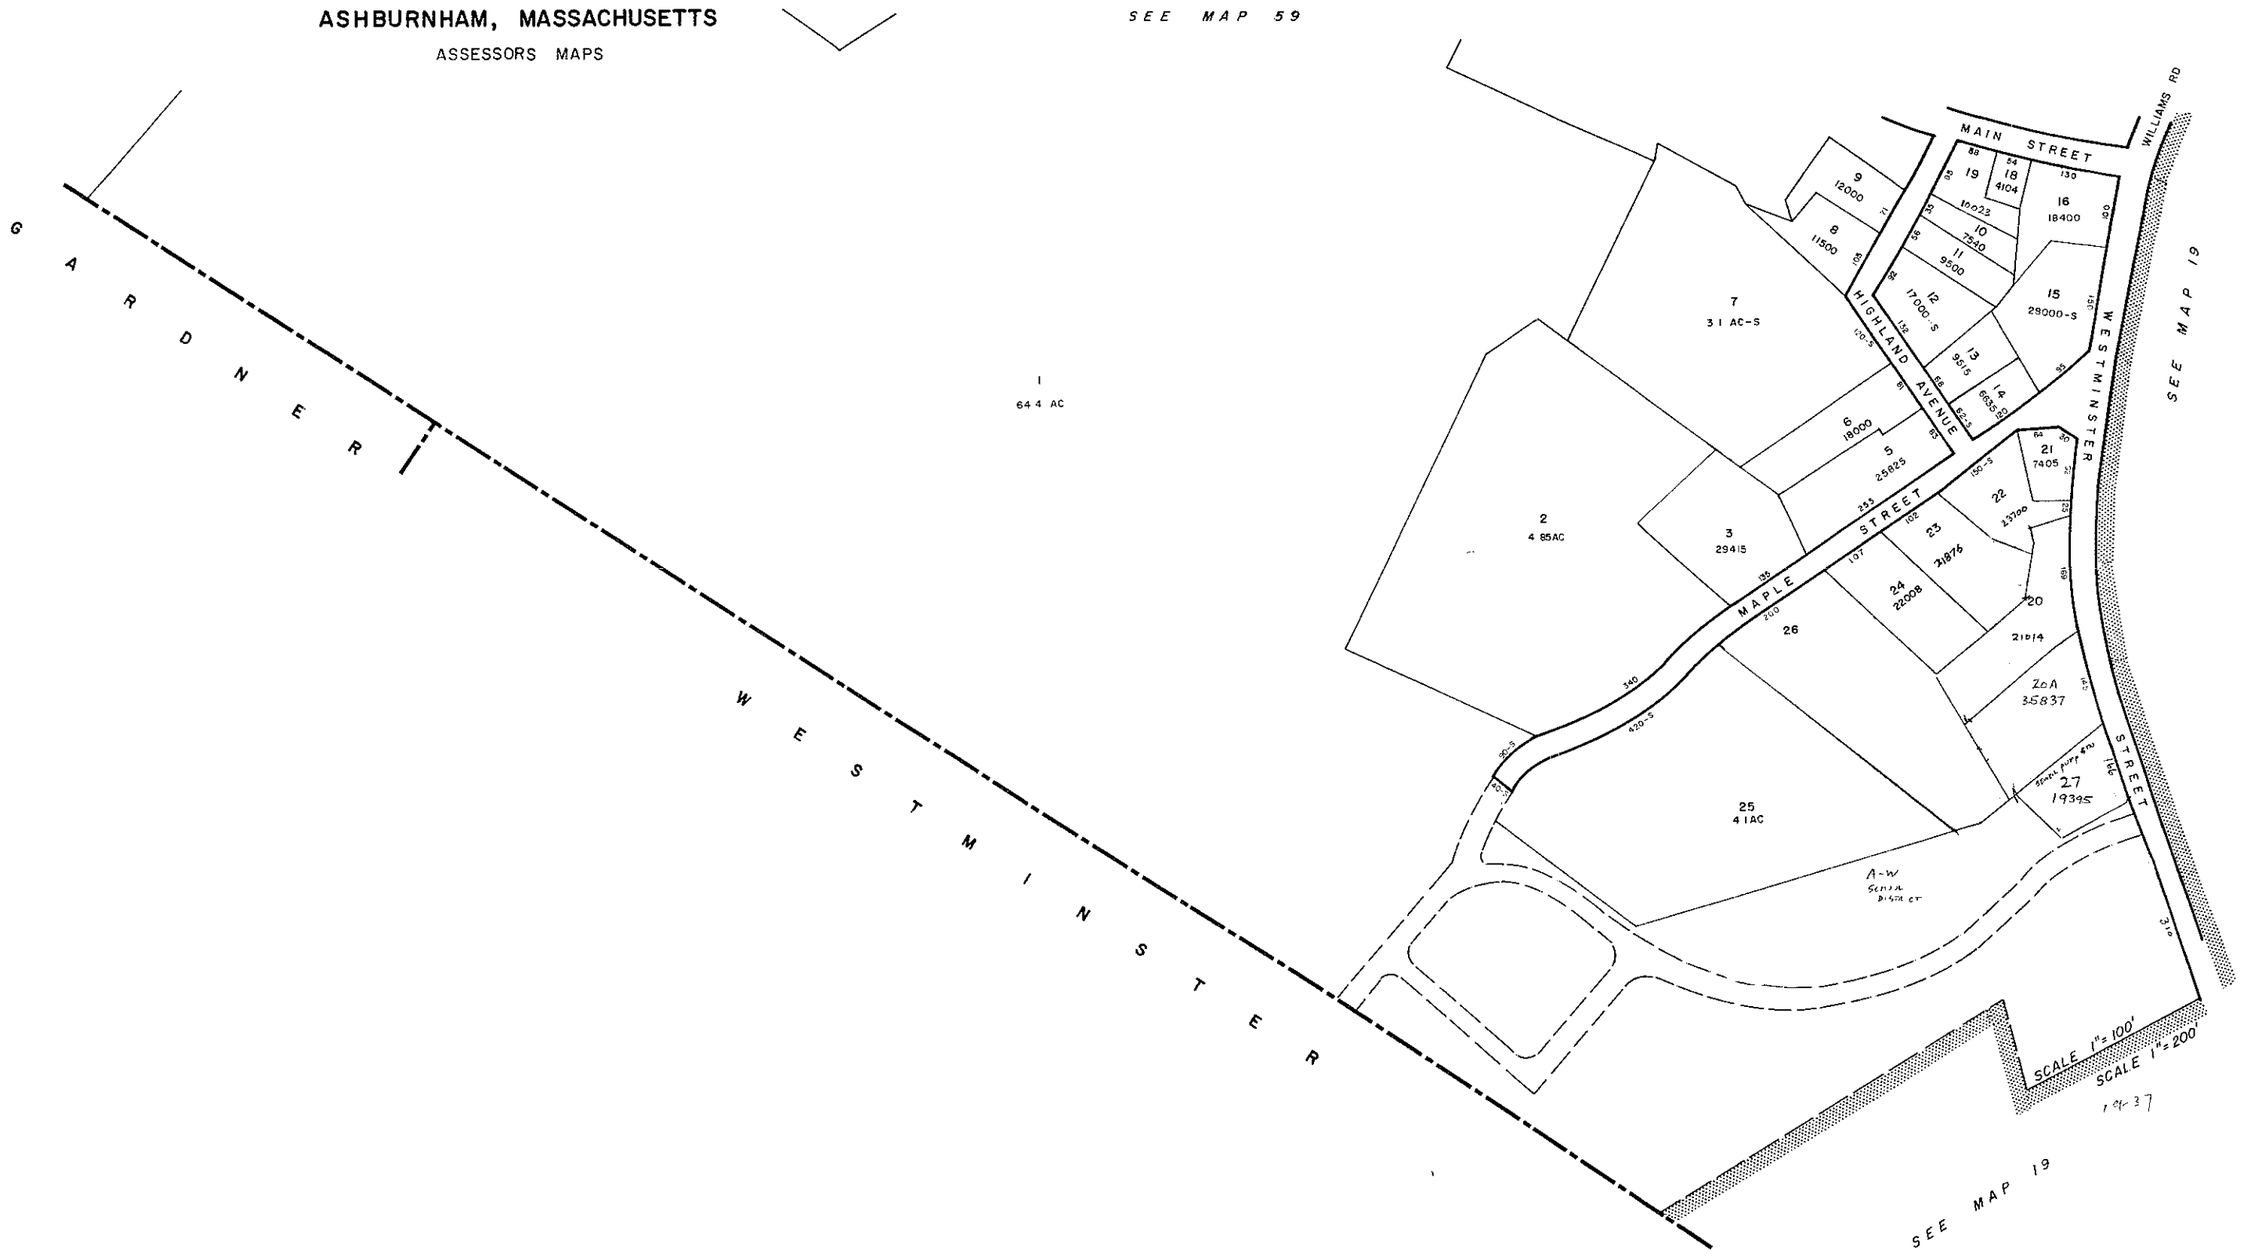


PREPARED UNDER THE DIRECTION OF THE
ASHBURNHAM BOARD OF ASSESSORS
BY
AVIS AIRMAP, INC
*BROOKLINE — BRAINTREE — HARTFORD*

100 0 100 200 300 FEET

| | | |
|---|---|---|
| REV BY | AVIS | 198 |
| REV BY | AVIS | 197 |
| REV BY | AVIS | 1974 |
| LAST Nº USED: | | [illegible] |
| ORIGINAL ISSUE: | | 1971 |

NUMBER NOT USED: 4 17

| | | |
|---|---|---|
| 18 | 59 | |
| | 60 | 19 |
| | | |

**MAP 60**

Revised To January 1, 1[illegible]

1/1/06

# ASHBURNHAM, MASSACHUSETTS

ASSESSORS MAPS

ACADEMY ST
PUFFER ST
PLEASANT ST
WILLARD RD
CENTRAL ST
SCHOOL ST
HILL RD
CASHMAN RD
FAIRVIEW AVE
FAIRVIEW PARK WEST
LIBERTY LANE
SCALE 1"=200'
SCALE 1"=100'

SEE MAP 21
SEE MAP 34
SEE MAP 35

1 14.3 AC-S
2 1 AC
3 24300-S
4 51500
6 2 AC
7 1.1 AC-S
8 3.3 AC-S
9 17.5 AC
10 6783
11 5980
12 7405
13 6563
14 12350-S
15 3485
16 3398
17 1.7 AC
18 37600-S
19 7500
20 39500
21 3.56 Ac
22 10000
23 25353
24 11250
25 22500
26 7500
27 13735
28 18735
29 38160
30 1.83 Ac
31 2.11 Ac
32 1.79 AC
33 2.29 AC
34 2.53 Ac
35 1.62 Ac
36 25000
37 18125
38 25012
39 14300
40 16500
41 13200
42 26400
43 8800
44 26400
45 17100-S
46 2.48 Ac
46A 45970
47 2.8 AC-S
48 17500-S
49 9583
50 8800 S
51 8278
52 9148
53 10454
54 12192
55 6.9 Ac
56 4 AC
57 1.59 Ac
58 1.09 Ac
59 1.37 Ac
60 1.39 Ac
61 1.03 Ac
62 1.60 Ac
63 1.08 Ac
64 1.13 Ac
65 1.03 Ac
66 1.04 Ac
67 1.13 Ac
69 1.47 Ac
70 1.31 Ac
71 1.61 Ac
LOT 1
LOT 2
LOT 3
LOT 4
LOT 5
LOT 6
LOT 7
LOT 8
LOT 10
LOT 11-A
LOT 12-A
LOT 14
LOT 15
LOT 16
LOT 17
LOT 18
LOT A-B
LOT C-D
LOT E-F
LOT G-H
R.O.W.
DRAINAGE

| | | |
|---|---|---|
| | AVIS | 198 |
| REV. BY | AVIS | 1975 |
| REV. BY | AVIS | 197 |
| LAST Nº USED: | | 56 |
| ORIGINAL ISSUE: | | 1972 |

NUMBER NOT USED: 5

**MAP 61**

Revised To January 1, 1988 X 1/1/06

| | | |
|---|---|---|
| | 62 | |
| 21 | 61 | 34 |
| 20 | 35 | |

PREPARED UNDER THE DIRECTION OF THE
ASHBURNHAM BOARD OF ASSESSORS
BY
AVIS AIRMAP, INC
*BROOKLINE — BRAINTREE — HARTFORD*

100 0 100 200 300 FEET

# ASHBURNHAM, MASSACHUSETTS

ASSESSORS MAPS

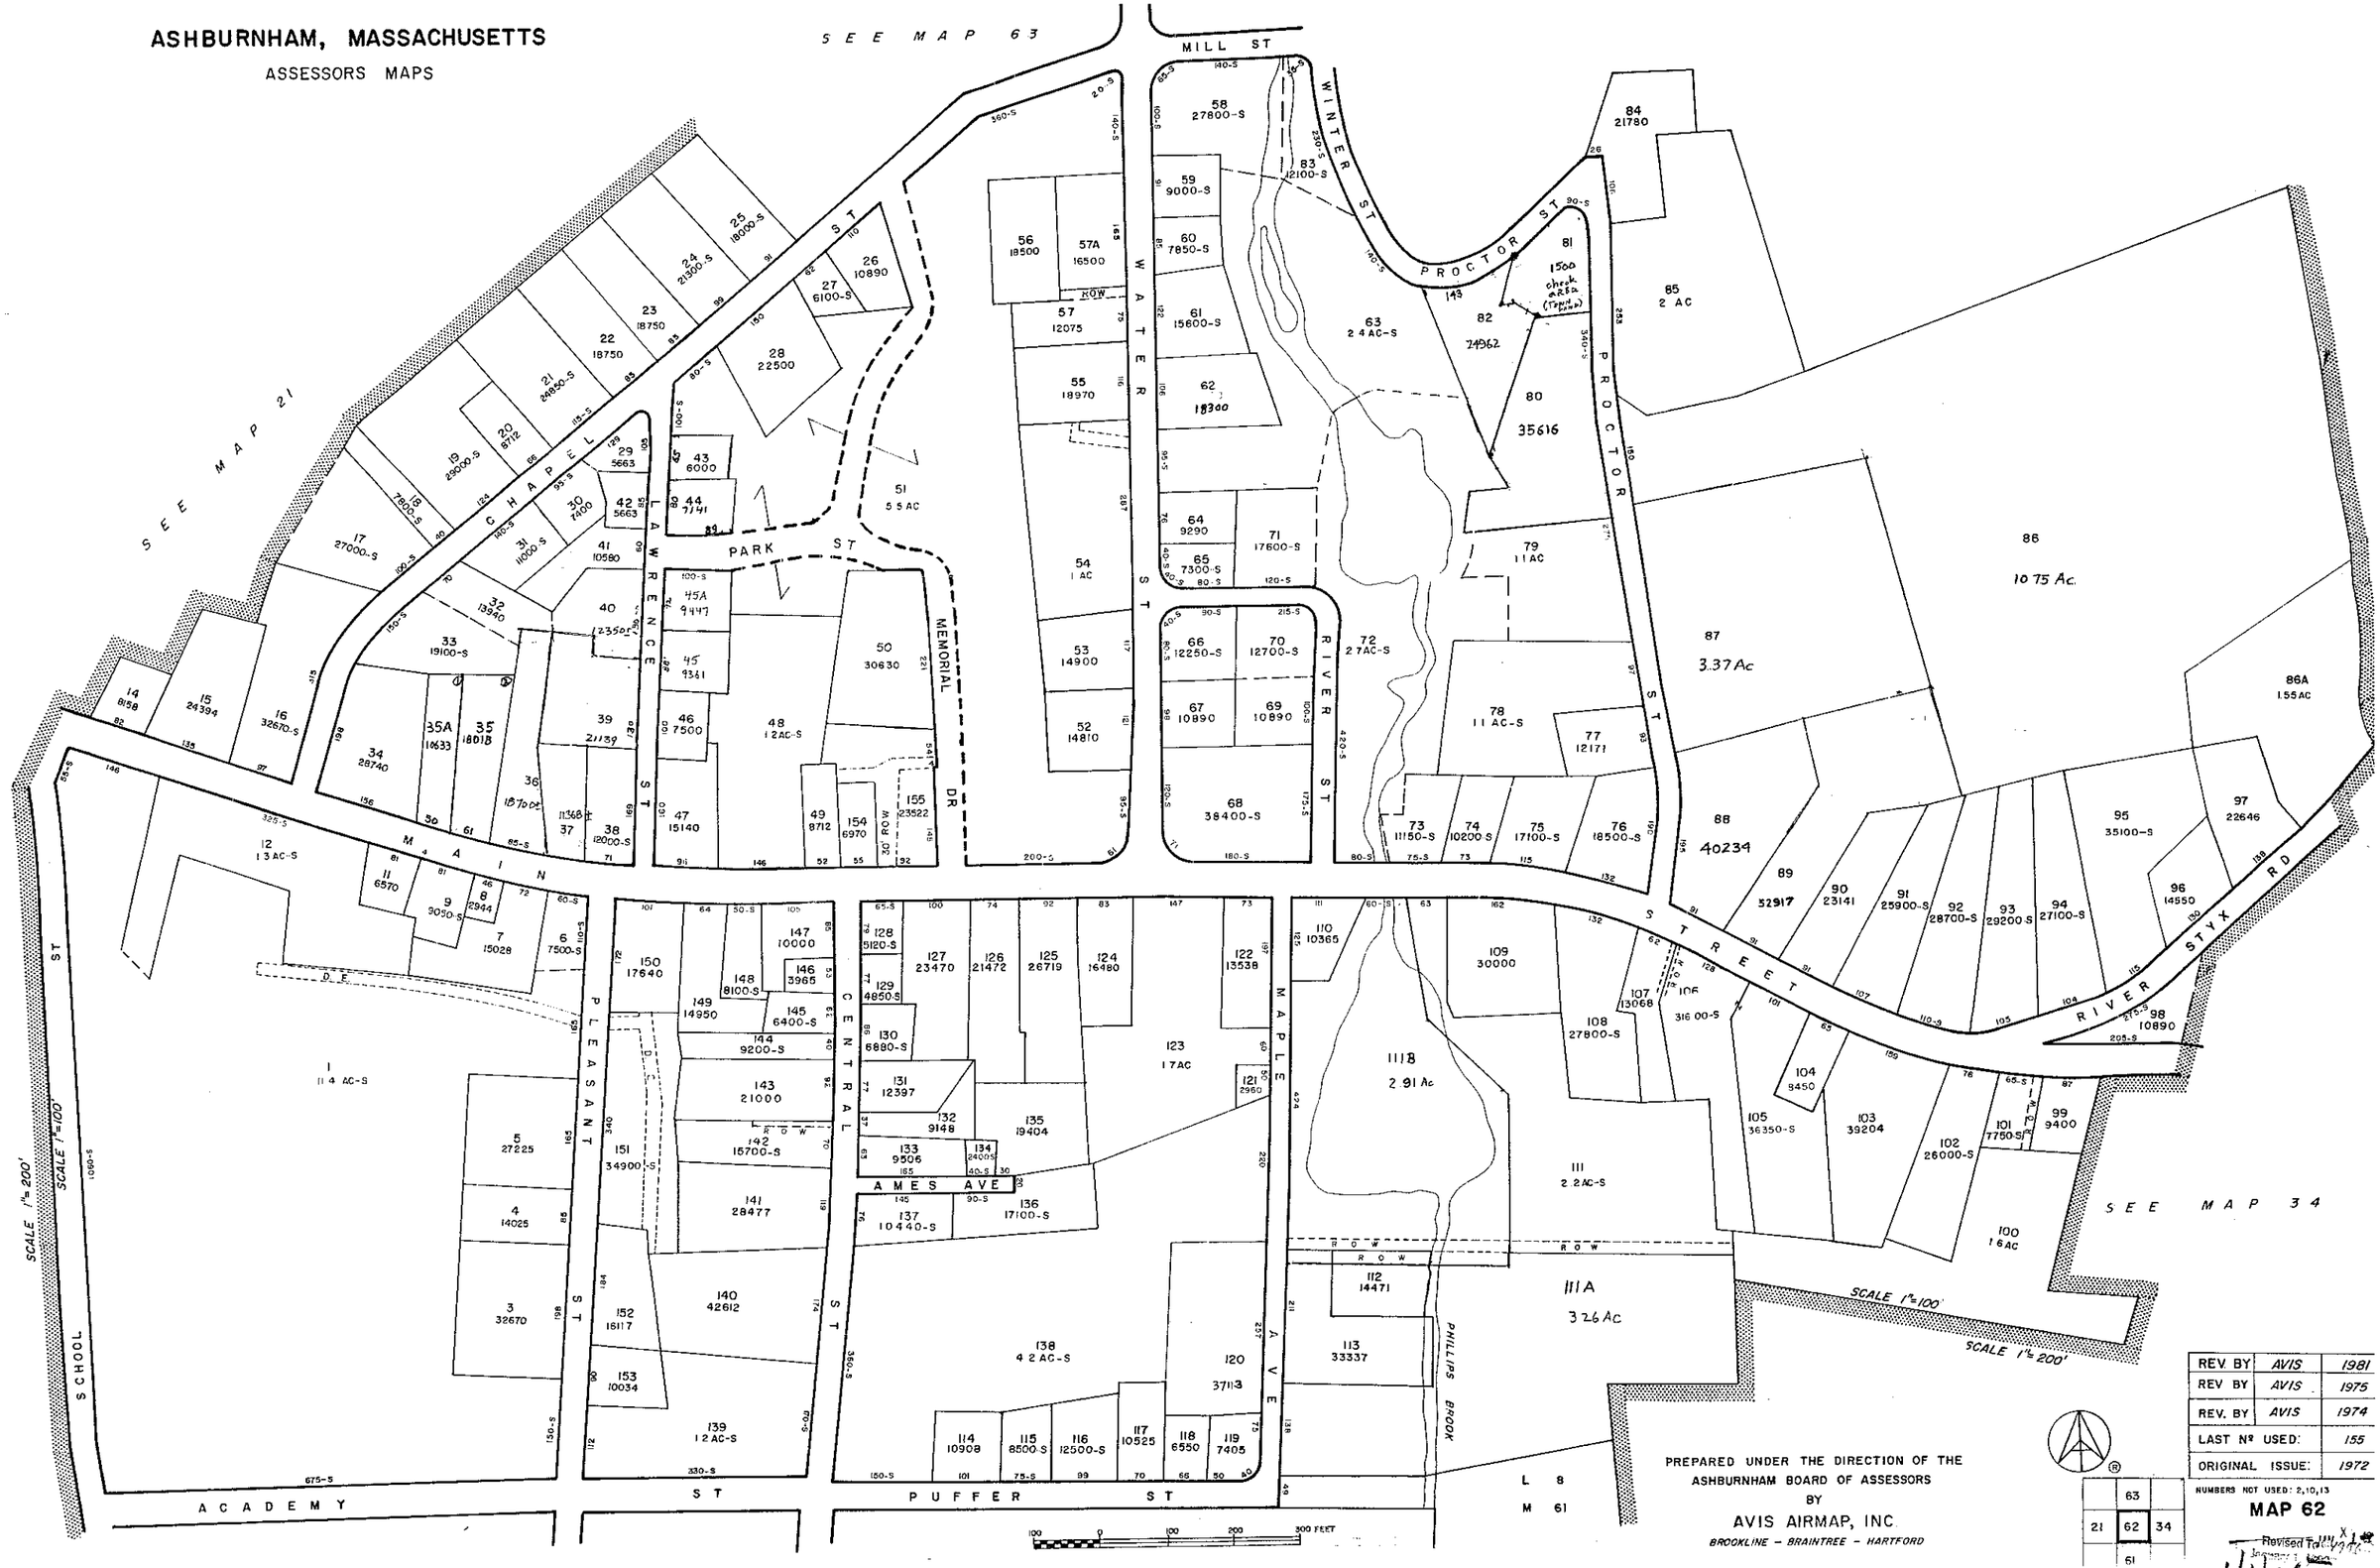


PREPARED UNDER THE DIRECTION OF THE
ASHBURNHAM BOARD OF ASSESSORS
BY
AVIS AIRMAP, INC
*BROOKLINE – BRAINTREE – HARTFORD*

| | | |
|---|---|---|
| REV BY | AVIS | 1981 |
| REV BY | AVIS | 1975 |
| REV. BY | AVIS | 1974 |
| LAST Nº USED: | | 155 |
| ORIGINAL ISSUE: | | 1972 |

NUMBERS NOT USED: 2,10,13

| | | |
|---|---|---|
| | 63 | |
| 21 | 62 | 34 |
| | 61 | |

**MAP 62**

Revised To 1/1/06

# ASHBURNHAM, MASSACHUSETTS

ASSESSORS MAPS

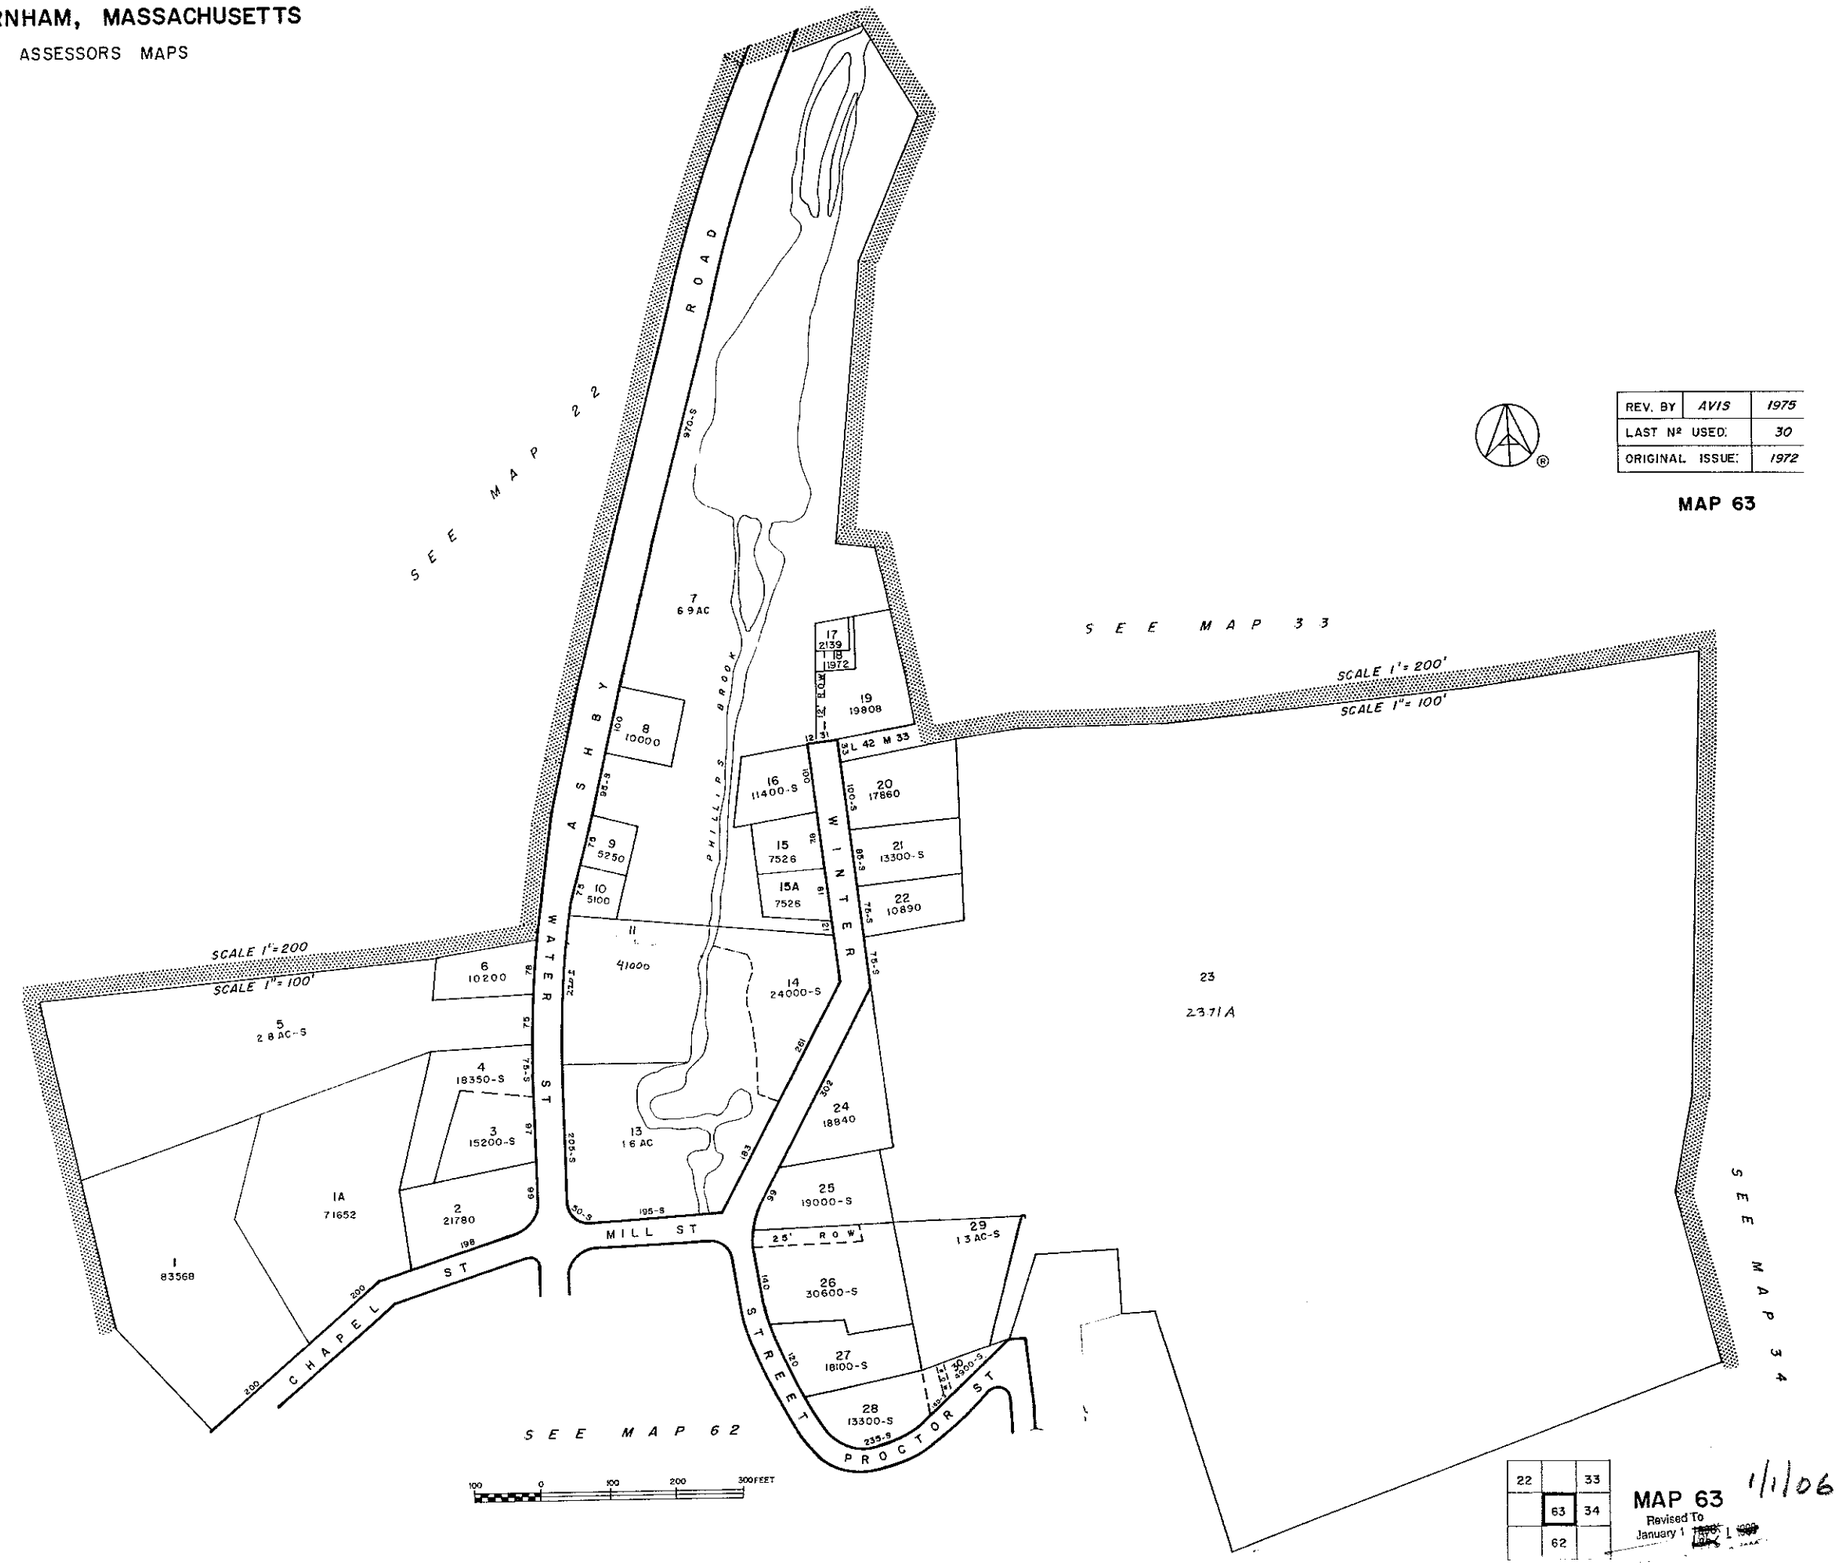


| REV. BY | AVIS | 1975 |
|---|---|---|
| LAST Nº USED: | | 30 |
| ORIGINAL ISSUE: | | 1972 |

**MAP 63**

PREPARED UNDER THE DIRECTION OF THE
ASHBURNHAM BOARD OF ASSESSORS
BY
AVIS AIRMAP, INC
*BROOKLINE — BRAINTREE — HARTFORD*




**MAP 63**
Revised To
January 1 1/1/06

# ASHBURNHAM, MASSACHUSETTS

ASSESSORS MAPS

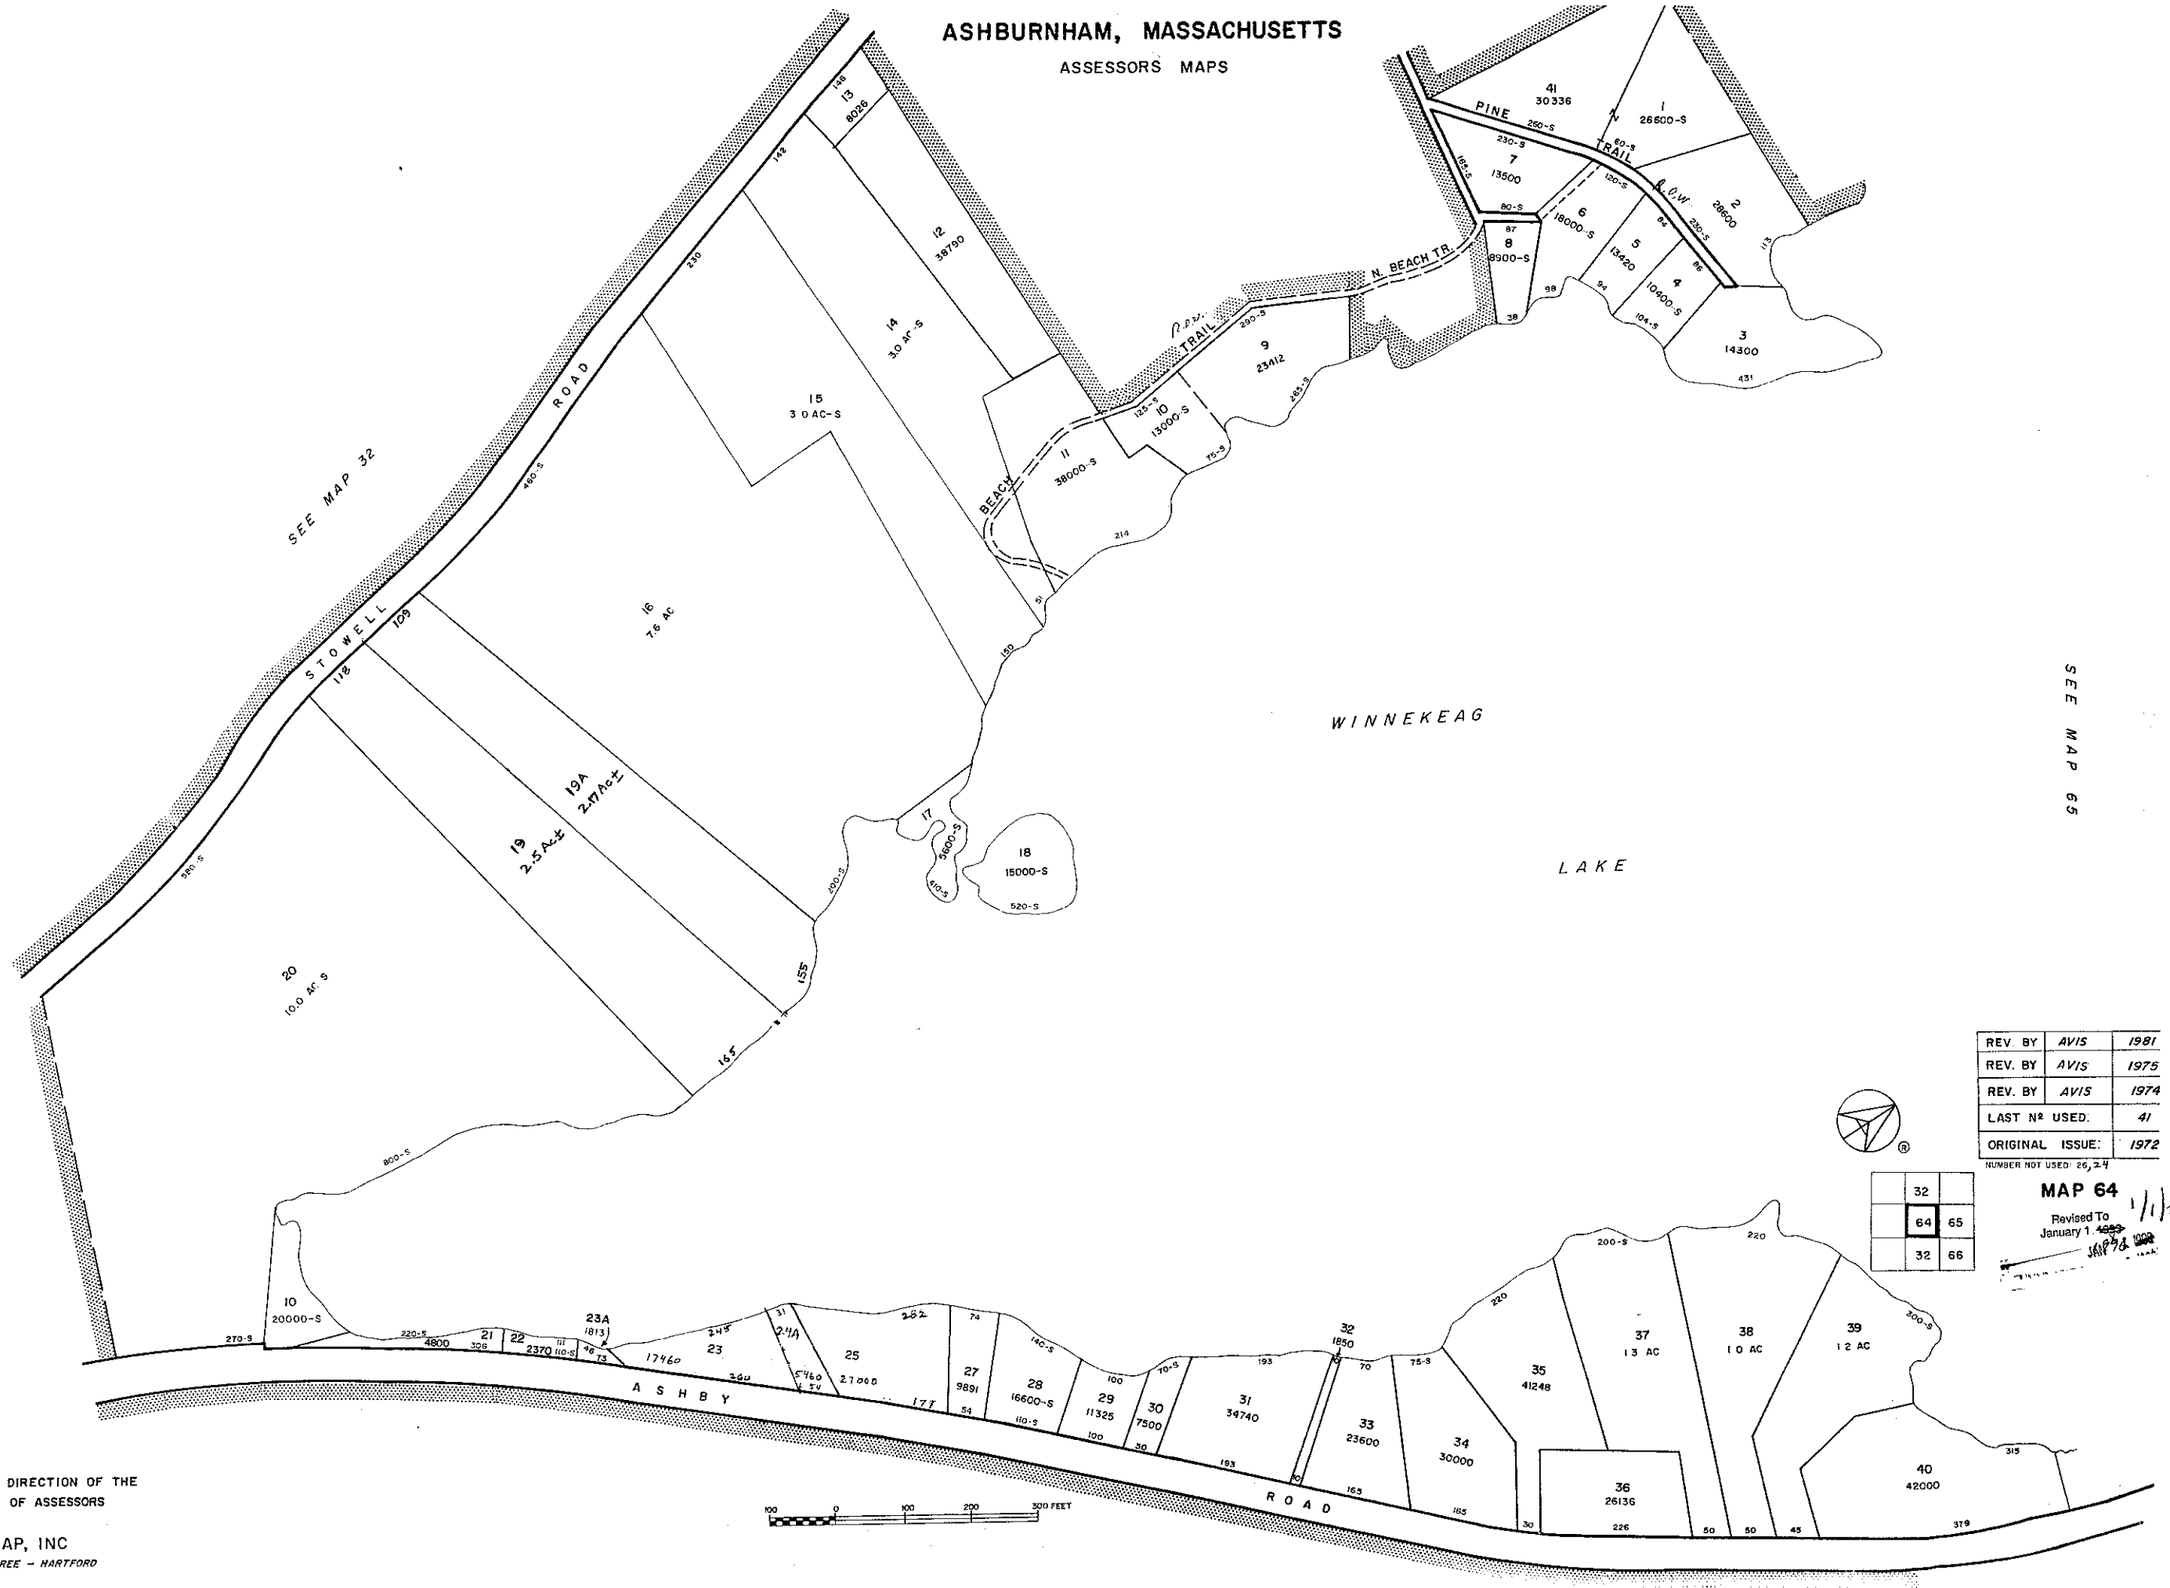


| | | |
|---|---|---|
| REV. BY | AVIS | 1981 |
| REV. BY | AVIS | 1975 |
| REV. BY | AVIS | 1974 |
| LAST Nº USED: | | 41 |
| ORIGINAL ISSUE: | | 1972 |

NUMBER NOT USED: 26, 24

| | | |
|---|---|---|
| | 32 | |
| | 64 | 65 |
| | 32 | 66 |

**MAP 64**

Revised To January 1 ~~1993~~ 1998 ~~1999~~

1/1/06

PREPARED UNDER THE DIRECTION OF THE
ASHBURNHAM BOARD OF ASSESSORS
BY
AVIS AIRMAP, INC
*BROOKLINE – BRAINTREE – HARTFORD*

# ASHBURNHAM, MASSACHUSETTS

ASSESSORS MAPS

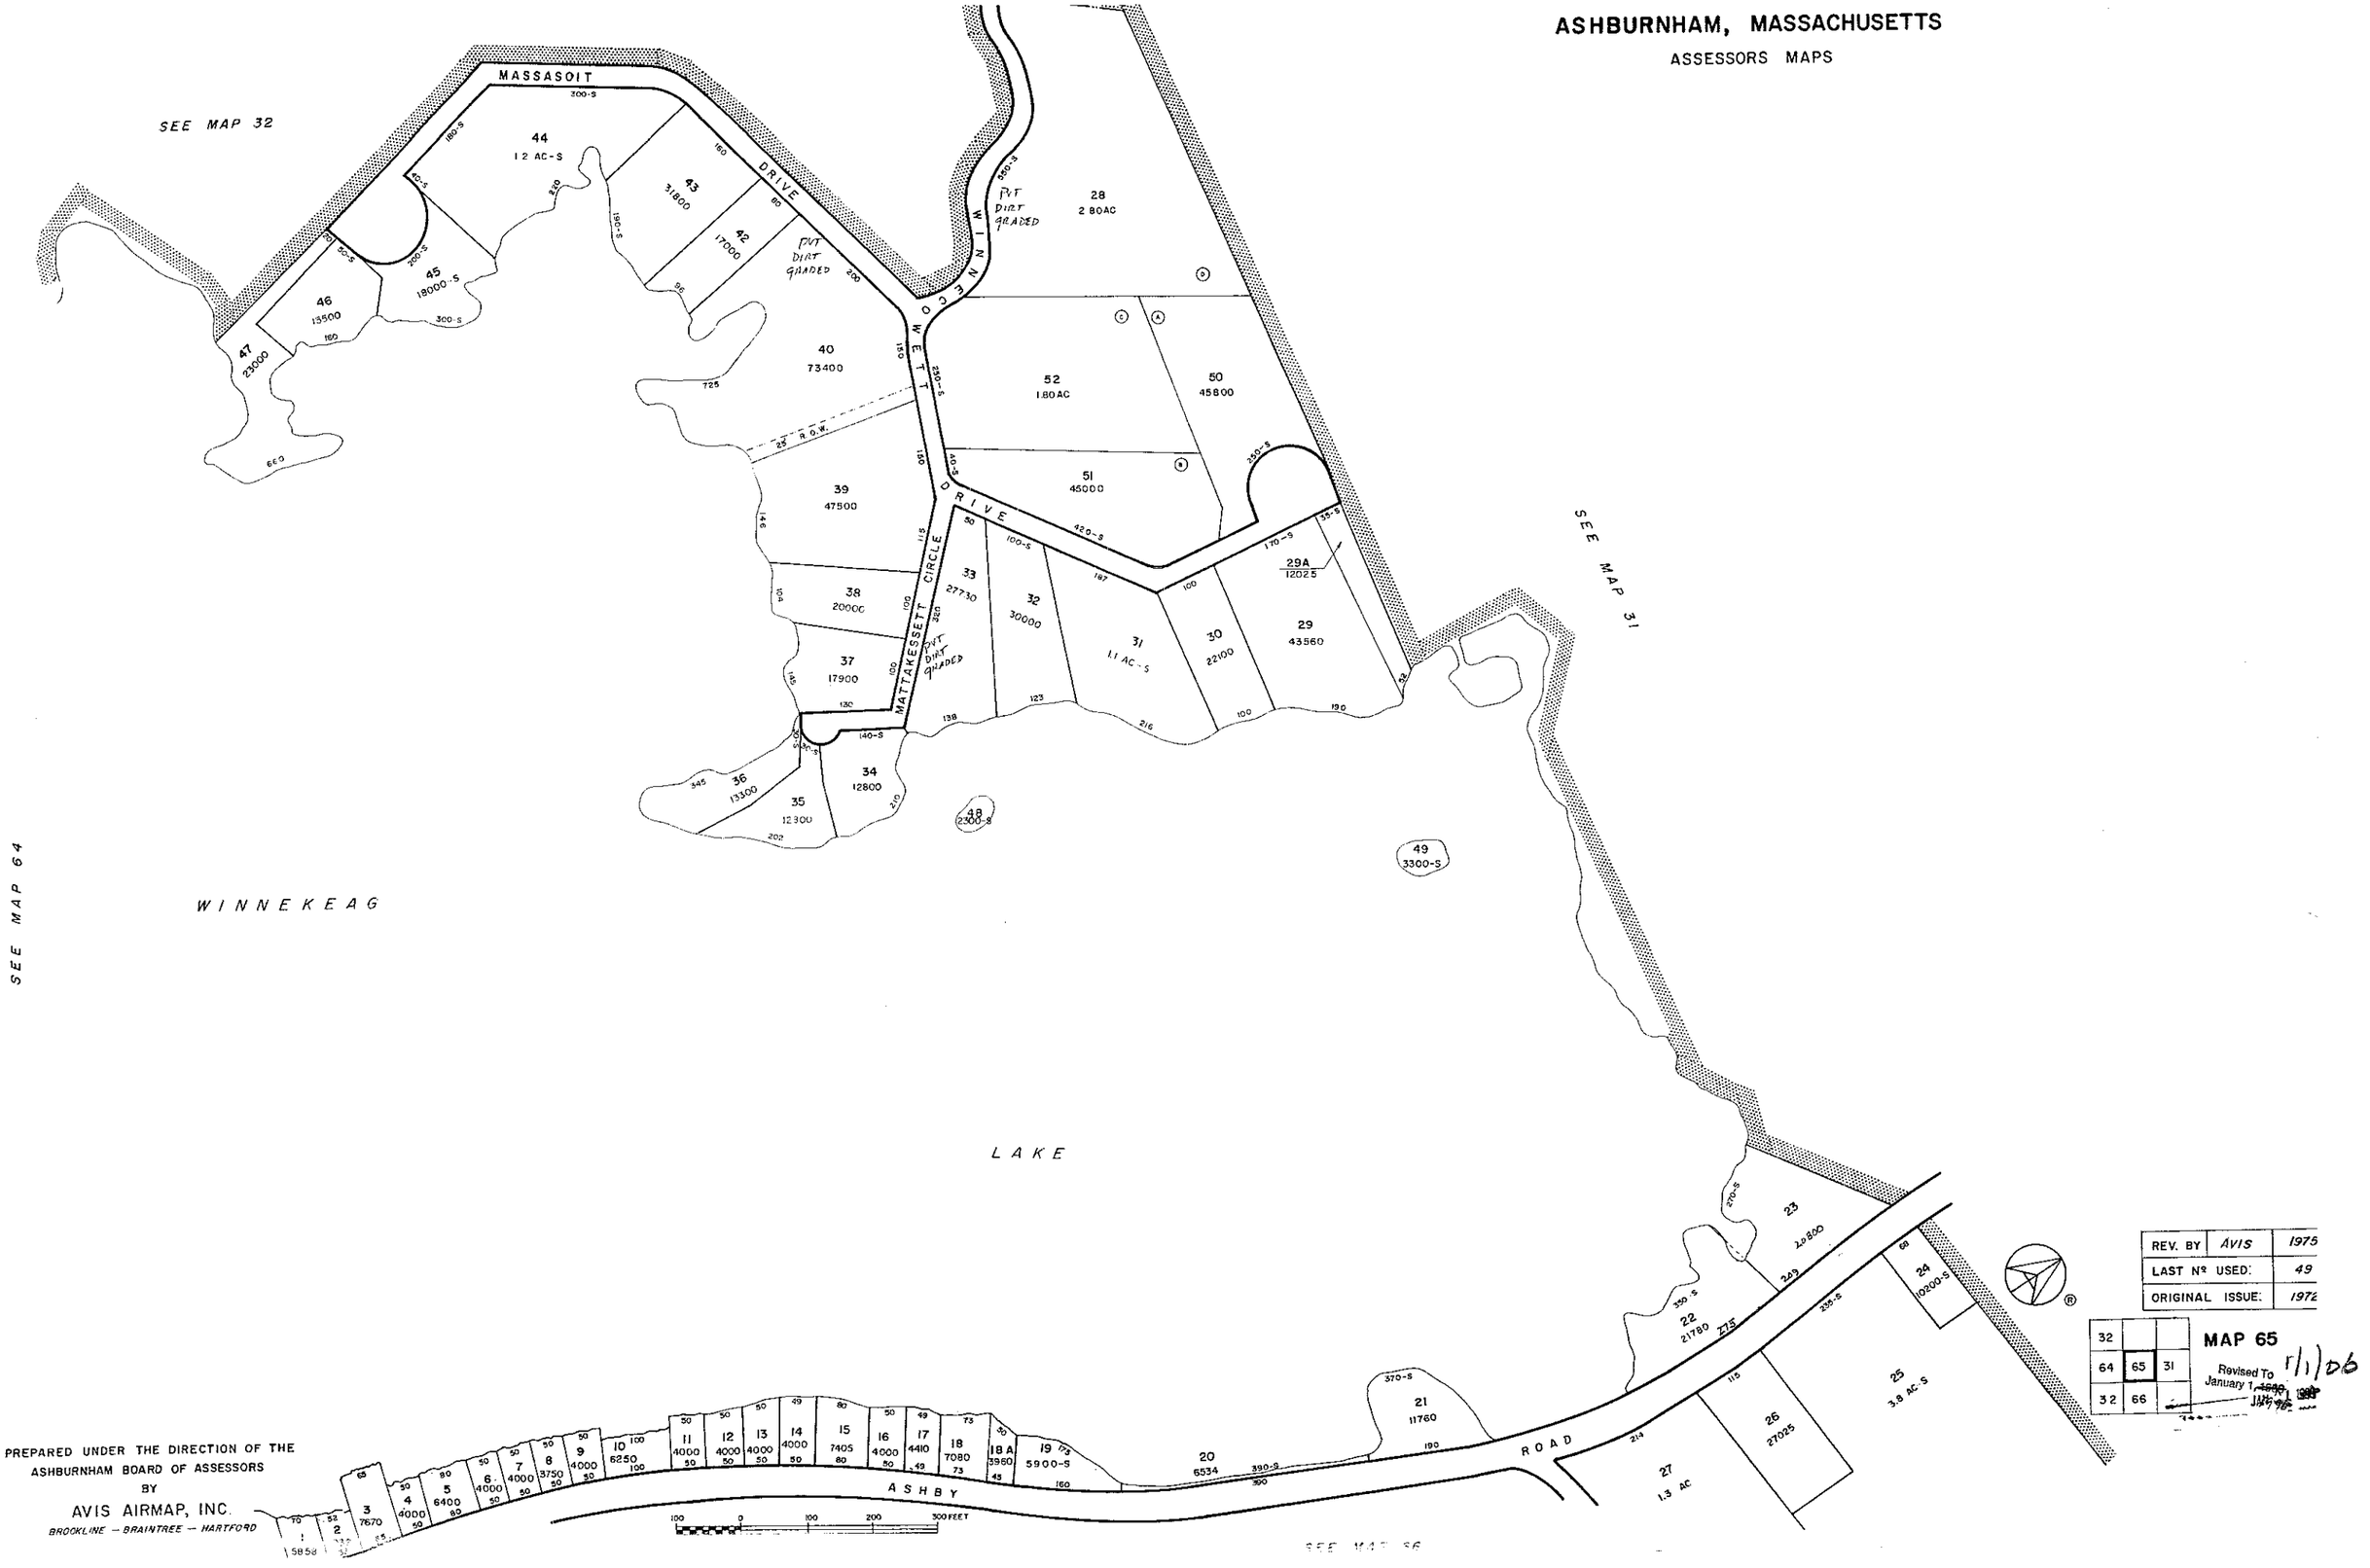


PREPARED UNDER THE DIRECTION OF THE
ASHBURNHAM BOARD OF ASSESSORS
BY
AVIS AIRMAP, INC.
*BROOKLINE — BRAINTREE — HARTFORD*

| | | |
|---|---|---|
| REV. BY | *AVIS* | *1975* |
| LAST Nº USED: | | *49* |
| ORIGINAL ISSUE: | | *1972* |

| | | |
|---|---|---|
| 32 | | |
| 64 | 65 | 31 |
| 32 | 66 | |

**MAP 65**

Revised To January 1, ~~1990~~ 1996


# ASHBURNHAM, MASSACHUSETTS

ASSESSORS MAPS

SEE MAP 65

SEE MAP 31

SEE MAP 32

ASHBY ROAD

HOLT ROAD

HAY ROAD

LOG CABIN ROAD

DIRT R.O.W.

ELLIS DRIVE

MOORE ROAD

OPEN SPACE

STODGE MEADOW POND

SEE MAP M67 P49

L 27 M 65

L 25 M 65

M32 P10

PART OF 61

60A 10689

60B 14875

60C 7332

60D 47916

25044

61 4 AC

58 32.06Ac ± (A-1)

74 6.00Ac ±

75 5.03Ac ±

76 50699

77 85131

78 74511

79 60818

80 60372

81 47300

82 75267

83 62619

84 60580

65 60239

66 58A 2.98 Ac

58B 1.45Ac

67 60276

68 6518

69 1.58Ac.

70 61935

71 60462

72 60341

73 76134

35 130 AC

| REV. BY | AVIS | 1981 |
|---|---|---|
| REV. BY | AVIS | 1975 |
| REV. BY | AVIS | 1986 |
| ORIGINAL ISSUE: | | 1972 |

| | | |
|---|---|---|
| | 65 | 31 |
| 32 | 66 | 67 |
| | 68 | |

MAP 66

Revised To January 1, 1996

1/1/06

PREPARED UNDER THE DIRECTION OF THE
ASHBURNHAM BOARD OF ASSESSORS
BY
AVIS AIRMAP, INC
*BROOKLINE – BRAINTREE – HARTFORD*

# ASHBURNHAM, MASSACHUSETTS

ASSESSORS MAPS

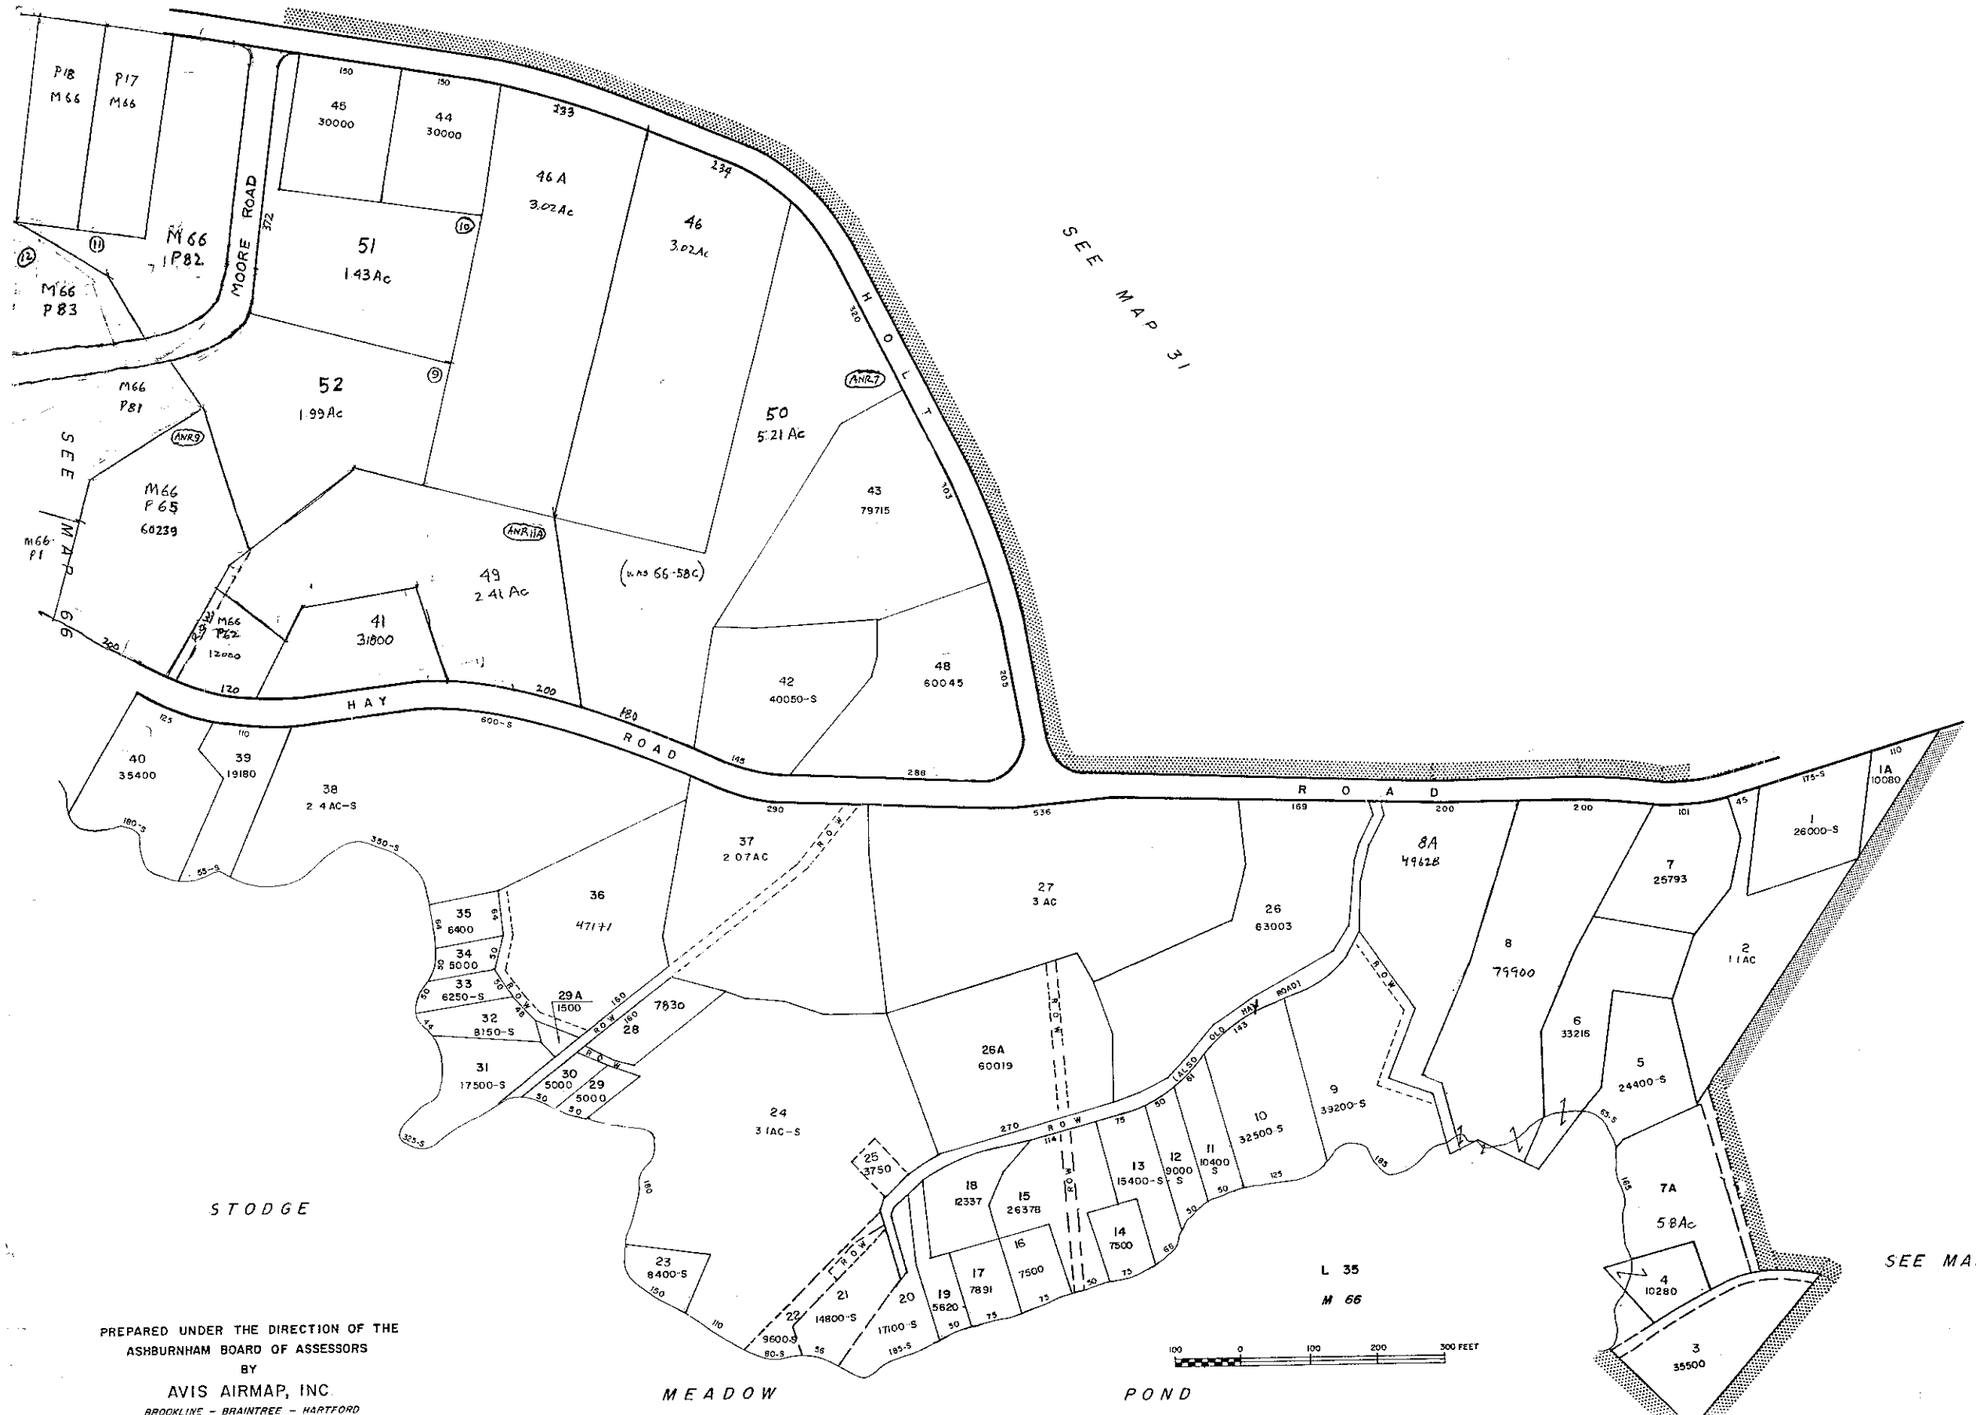


PREPARED UNDER THE DIRECTION OF THE
ASHBURNHAM BOARD OF ASSESSORS
BY
AVIS AIRMAP, INC.
*BROOKLINE - BRAINTREE - HARTFORD*

| | | |
|---|---|---|
| REV. BY | AVIS | 1981 |
| REV. BY | AVIS | 1975 |
| REV. BY | AVIS | 1974 |
| LAST Nº USED: | | 45 |
| ORIGINAL ISSUE: | | 1972 |

| | | |
|---|---|---|
| | 31 | |
| 66 | 67 | |
| 69 | | 41 |

**MAP 67** 1/1/06
Revised To
January 1 1993
1/1/2006

# ASHBURNHAM, MASSACHUSETTS

ASSESSORS MAPS

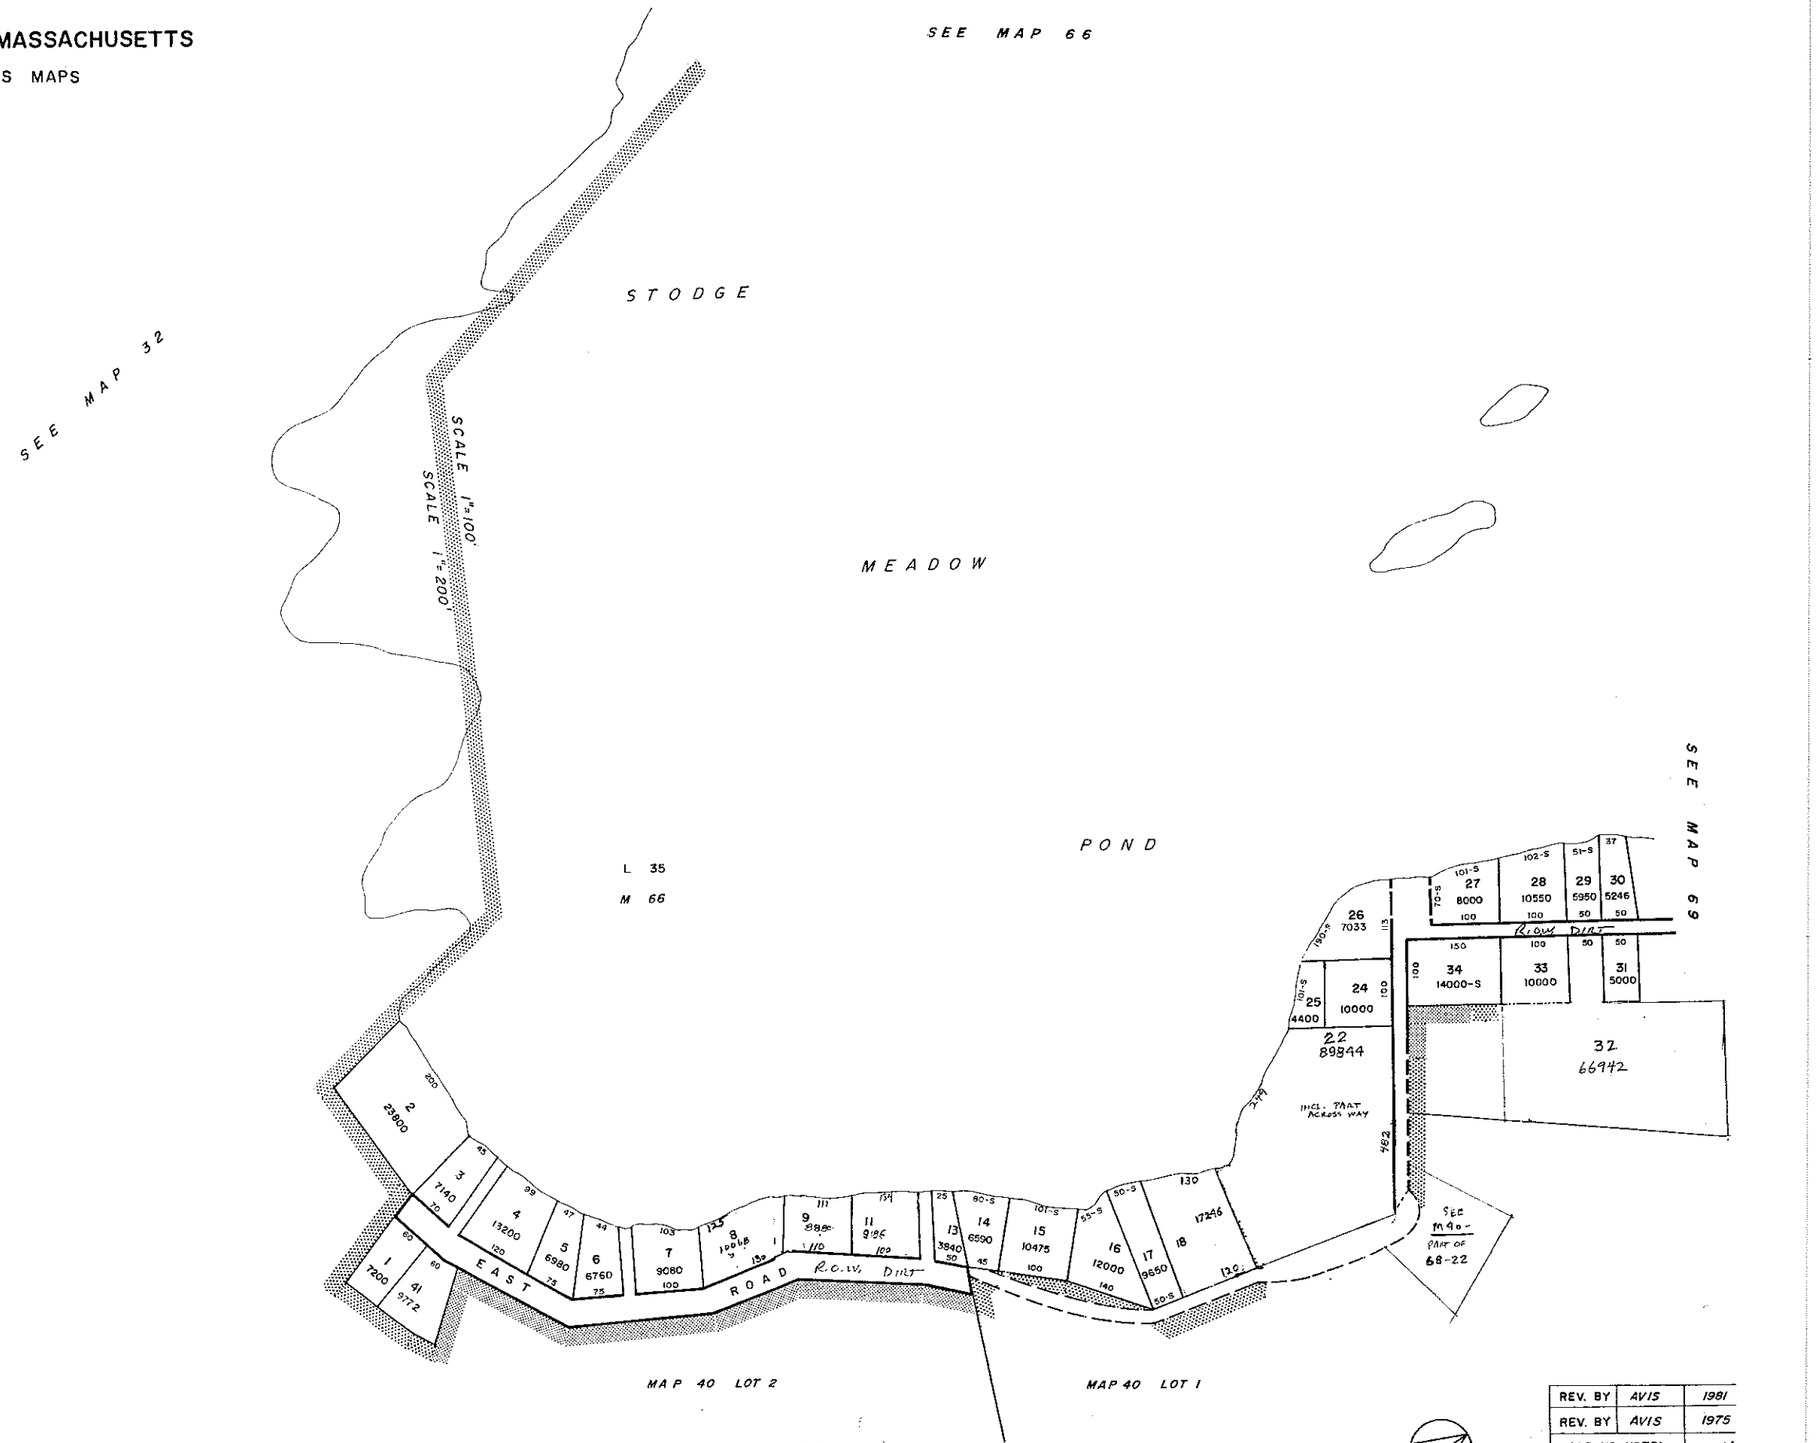


| | | |
|---|---|---|
| REV. BY | AVIS | 1981 |
| REV. BY | AVIS | 1975 |
| LAST Nº USED: | | 41 |
| ORIGINAL ISSUE: | | 1972 |

NUMBERS NOT USED: 20, 21, 23, 35 THRU 41

| | | |
|---|---|---|
| | 66 | |
| 32 | 68 | 69 |
| | 40 | |

**MAP 68**

Revised To January 1, 1981, 1985

1/1/06

PREPARED UNDER THE DIRECTION OF THE
ASHBURNHAM BOARD OF ASSESSORS
BY
AVIS AIRMAP, INC.
*BROOKLINE – BRAINTREE – HARTFORD*

# ASHBURNHAM, MASSACHUSETTS

ASSESSORS MAPS

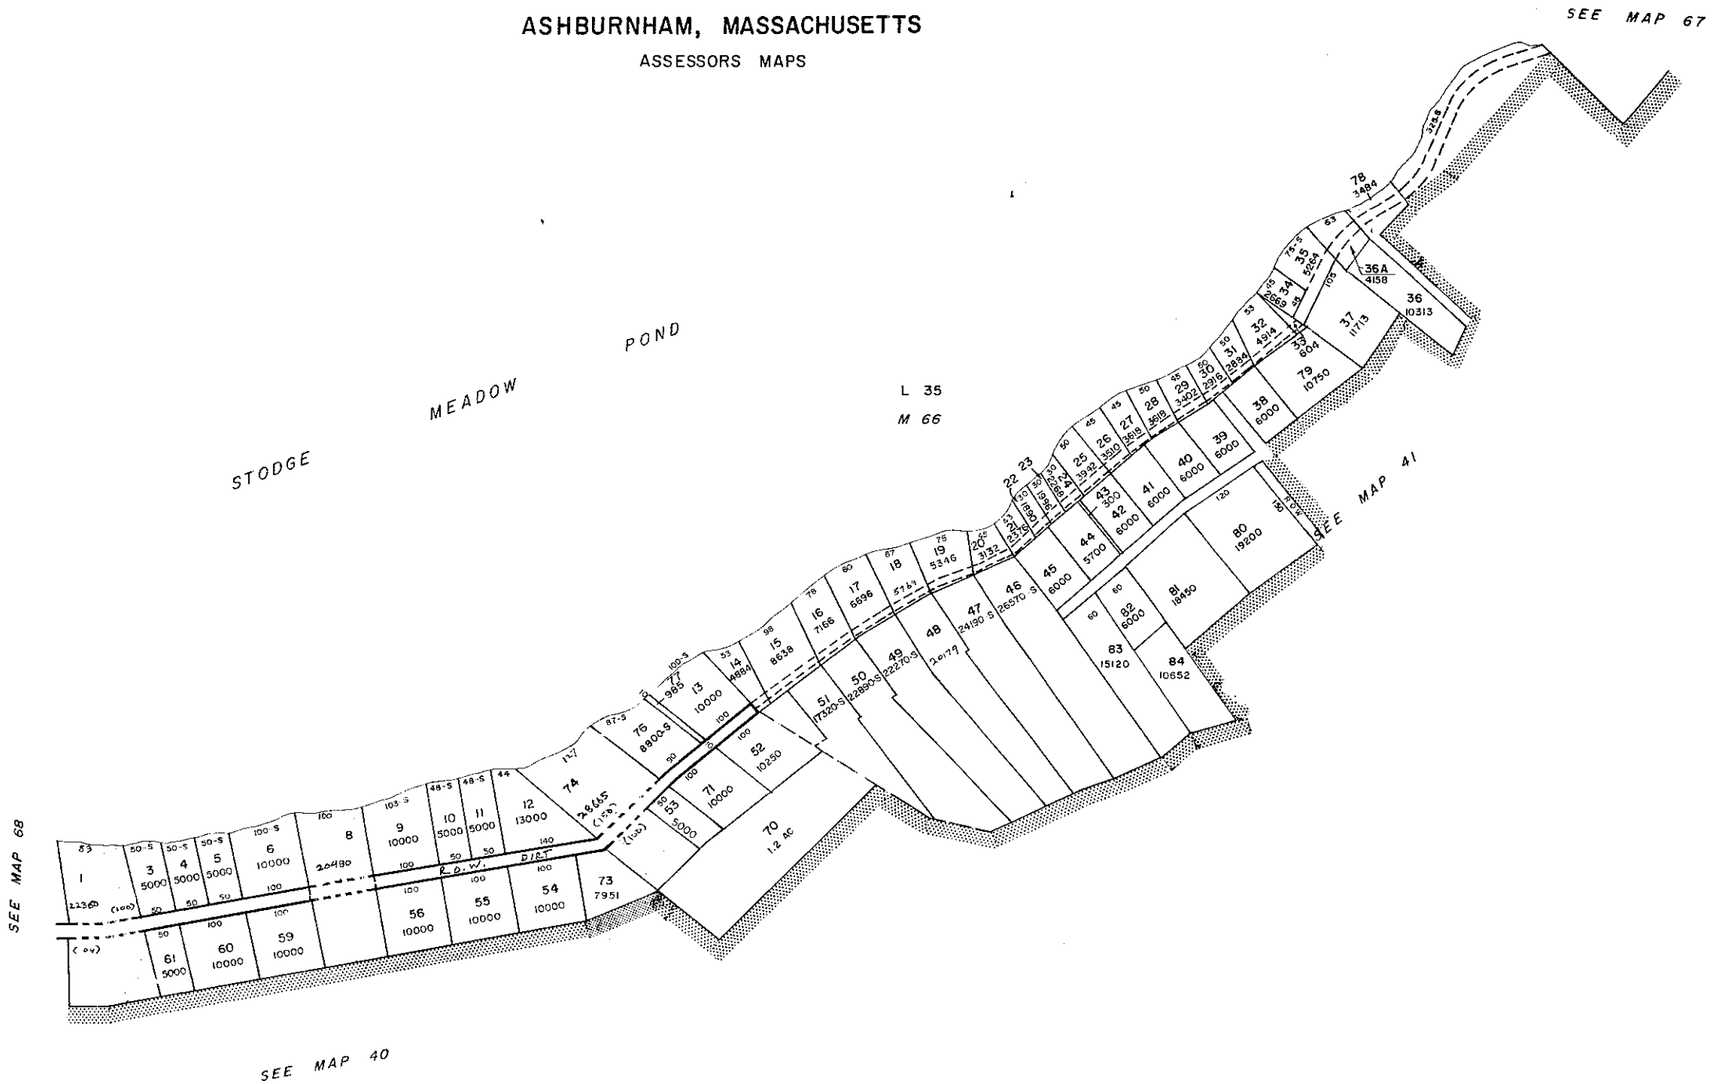


PREPARED UNDER THE DIRECTION OF THE
ASHBURNHAM BOARD OF ASSESSORS
BY
AVIS AIRMAP, INC.
*BROOKLINE – BRAINTREE – HARTFORD*

100 0 100 200 300 FEET

| | | |
|---|---|---|
| REV. BY | AVIS | 198 |
| REV. BY | AVIS | 197 |
| LAST Nº USED: | | 83 |
| ORIGINAL ISSUE: | | 197 |

NUMBERS NOT USED: 64 THRU 69, 73

| | | |
|---|---|---|
| 32 | 66 | 67 |
| 68 | 69 | |
| | 40 | 41 |

**MAP 69**

Revised To
January 1, 1~~19~~ 1/1/06

# ASHBURNHAM, MASSACHUSETTS

ASSESSORS MAPS

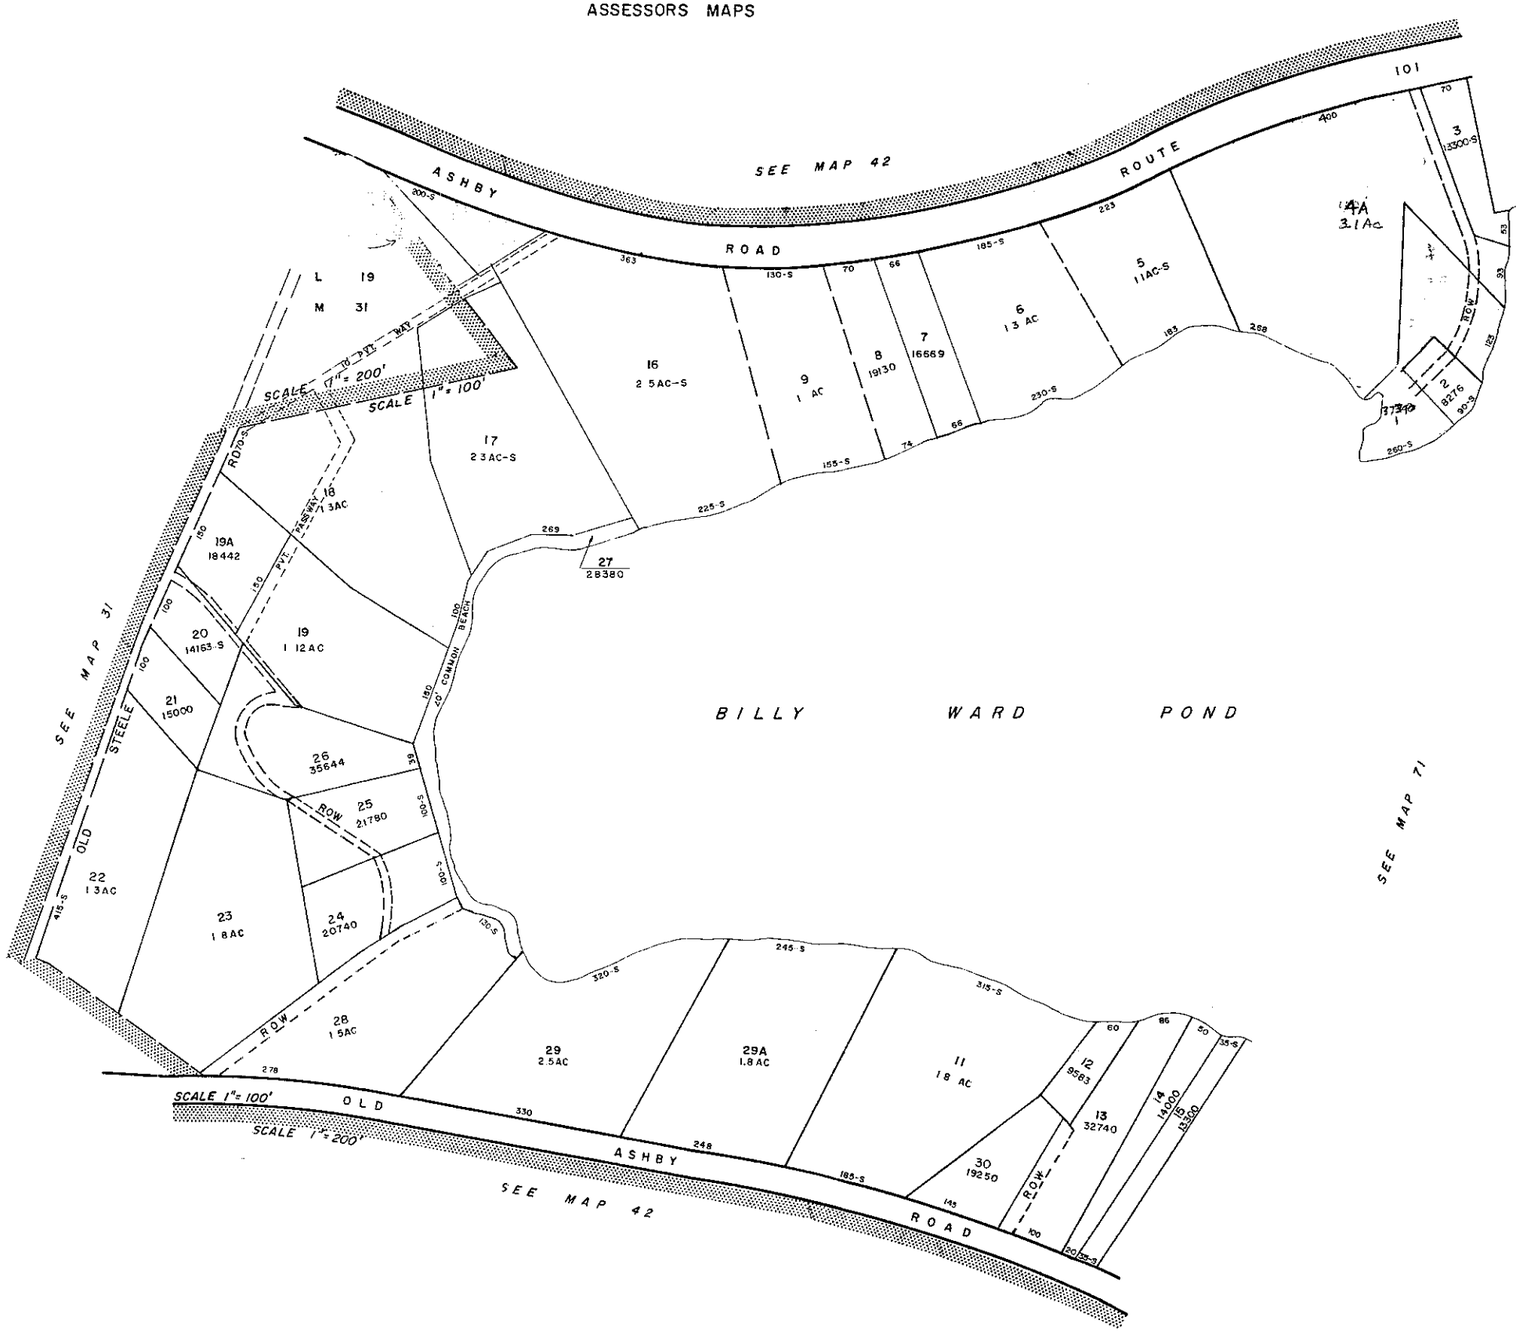


PREPARED UNDER THE DIRECTION OF THE
ASHBURNHAM BOARD OF ASSESSORS
BY
AVIS AIRMAP, INC
*BROOKLINE – BRAINTREE – HARTFORD*

| | | |
|---|---|---|
| REV. BY | AVIS | 1981 |
| REV. BY | AVIS | 1975 |
| REV. BY | AVIS | 1974 |
| LAST Nº USED: | | 30 |
| ORIGINAL ISSUE: | | 1972 |

NUMBER NOT USED: 27, 10, 4

| | | |
|---|---|---|
| | 42 | |
| 31 | 70 | 71 |

**MAP 70** 1/1/06

Revised To
January 1, 1999

# ASHBURNHAM, MASSACHUSETTS

ASSESSORS MAPS

SCALE 1" = 200'
SCALE 1" = 100'

SEE MAP 42

SEE MAP 43

SEE MAP 70

SEE MAP 42

ASHBY ROAD

ROUTE 101

ROUTE 119

ASHBY ROAD

OLD ASHBY ROAD

TURNPIKE ROAD

RINGE ROAD

LITTLE WATATIC R.D.

PVT. DR.

BILLY WARD POND

WATATIC POND

19 26600-S

18 2.7 AC-S

17 14200-S

16 2548

15 2.6 AC

14 21780-S

13 11761

12 6600-S

11

10 3080

9

3200-S

24 26400

34 1 AC-S

25 10000

26 9145

27 10000

28 12510

29 5290

30 8136

31 8024

32 17500

33 21000

36 1.6 AC-S

37 2 AC

65 7673

64 6674

23 4.5 AC-S

21 9.3 AC-S

20 3.9 AC

21A 2.33 AC

20A 50139

45 1 AC-S

44 37200

43 21760

42 41000

46 225-S

47 12000-S

48 1 AC

40 1 AC

41 27000

50 1600

49 12400

68 3560

67 6250

38 25400

39 35937

52 19885

53 7600

54 13900

55 16325

55A 8277

56 12118

57 7250

58 7154

60 8860

61 7100-S

62 13900

63 34973

59 1400-S

22 6 AC-S

7 2.5 AC-S

6 1.9 AC

5 1 AC

4 61050

3 60320

2 25580

1 3.74 AC

PREPARED UNDER THE DIRECTION OF THE
ASHBURNHAM BOARD OF ASSESSORS
BY
AVIS AIRMAP, INC
BROOKLINE — BRAINTREE — HARTFORD

100 0 100 200 300 FEET

| | | |
|---|---|---|
| REV. BY | AVIS | 1981 |
| REV. BY | AVIS | 1975 |
| REV. BY | AVIS | 1974 |
| LAST Nº USED: | | 67 |
| ORIGINAL ISSUE: | | 1972 |

NUMBERS NOT USED: 8, 35, 66

| | | |
|---|---|---|
| 30 | | 43 |
| 70 | 71 | |
| 41 | 42 | |

MAP 71

Revised To January 1 1996

1/1/06